


11 = "E" section lease from Geo. Baer Est

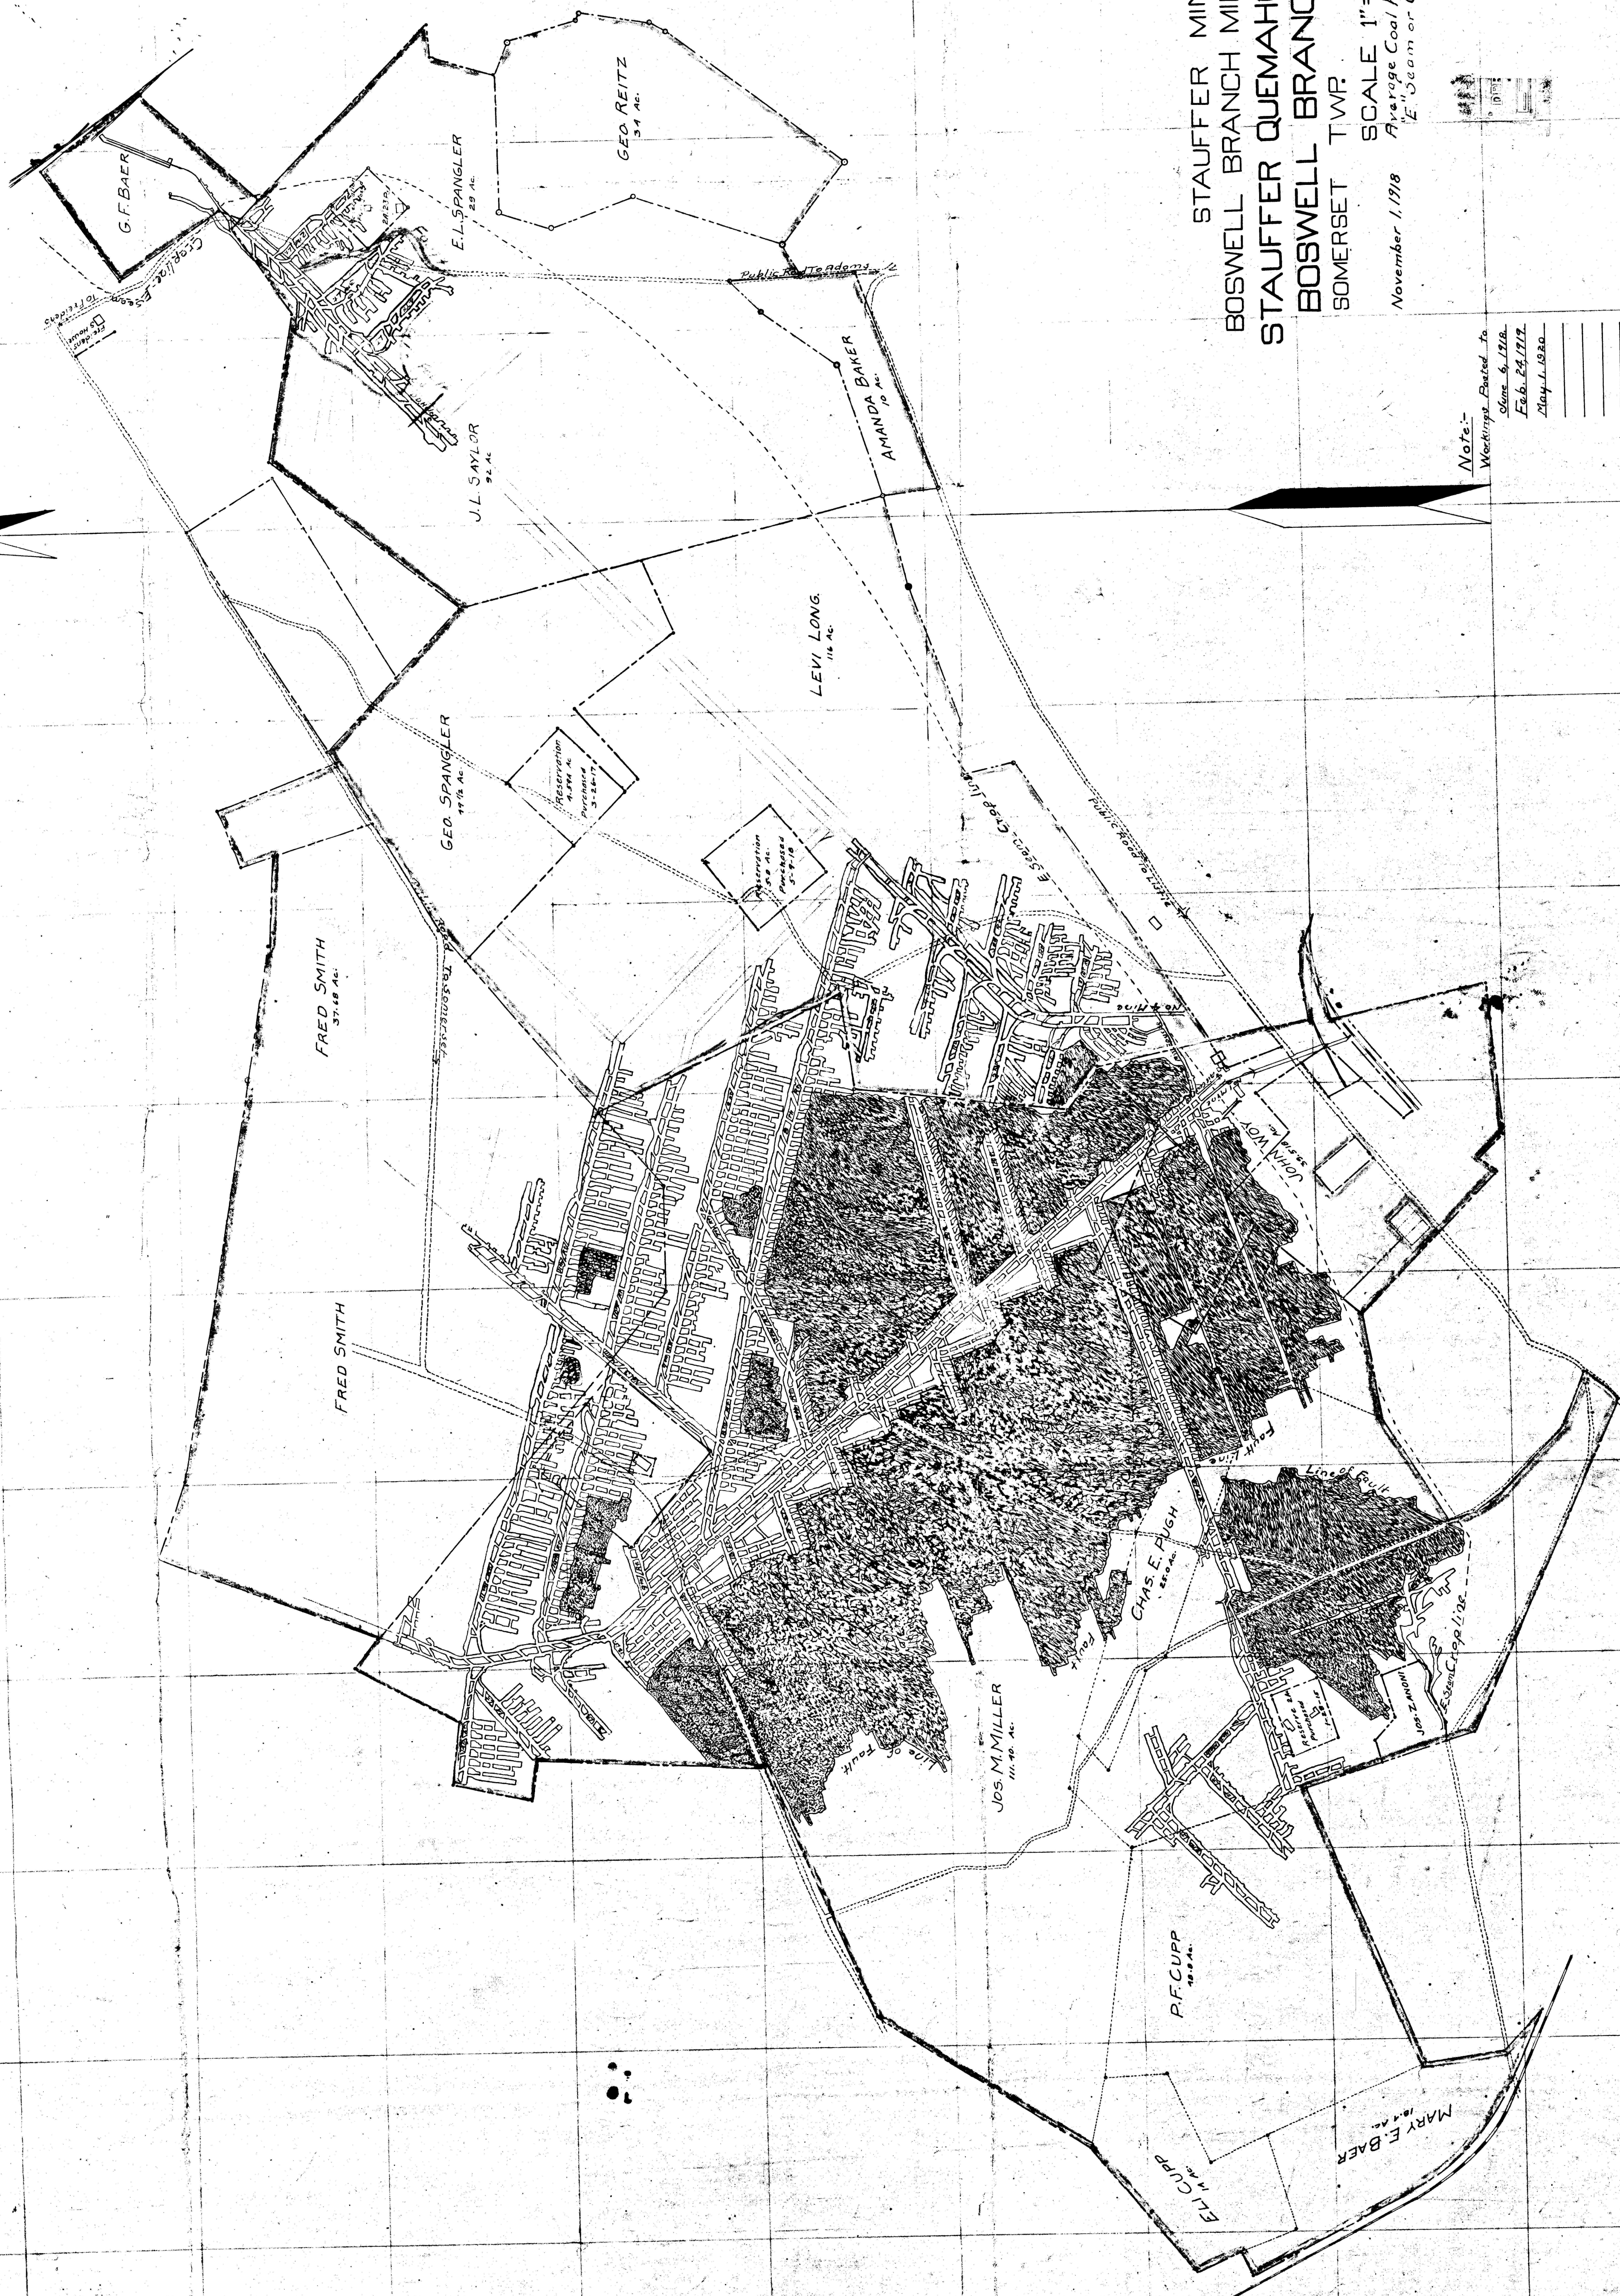

STAUFFER MINE NO. 1
BOSWELL BRANCH MINES NO. 1 & NO. 2
STAUFFER QUEMAHONING COAL CO.
BOSWELL BRANCH COAL CO.
SOMERSET TWP. SOMERSET CO. PA.

SCALE 1" = 400'
November 1, 1918
Average Coal Height = 40" Thick - More
"E" Seam or Upper Freepart. Mining Somerset Co.

Note:-
Workings Based to
State & L.R.
Feb. 23, 1917.
May 1, 1920.