


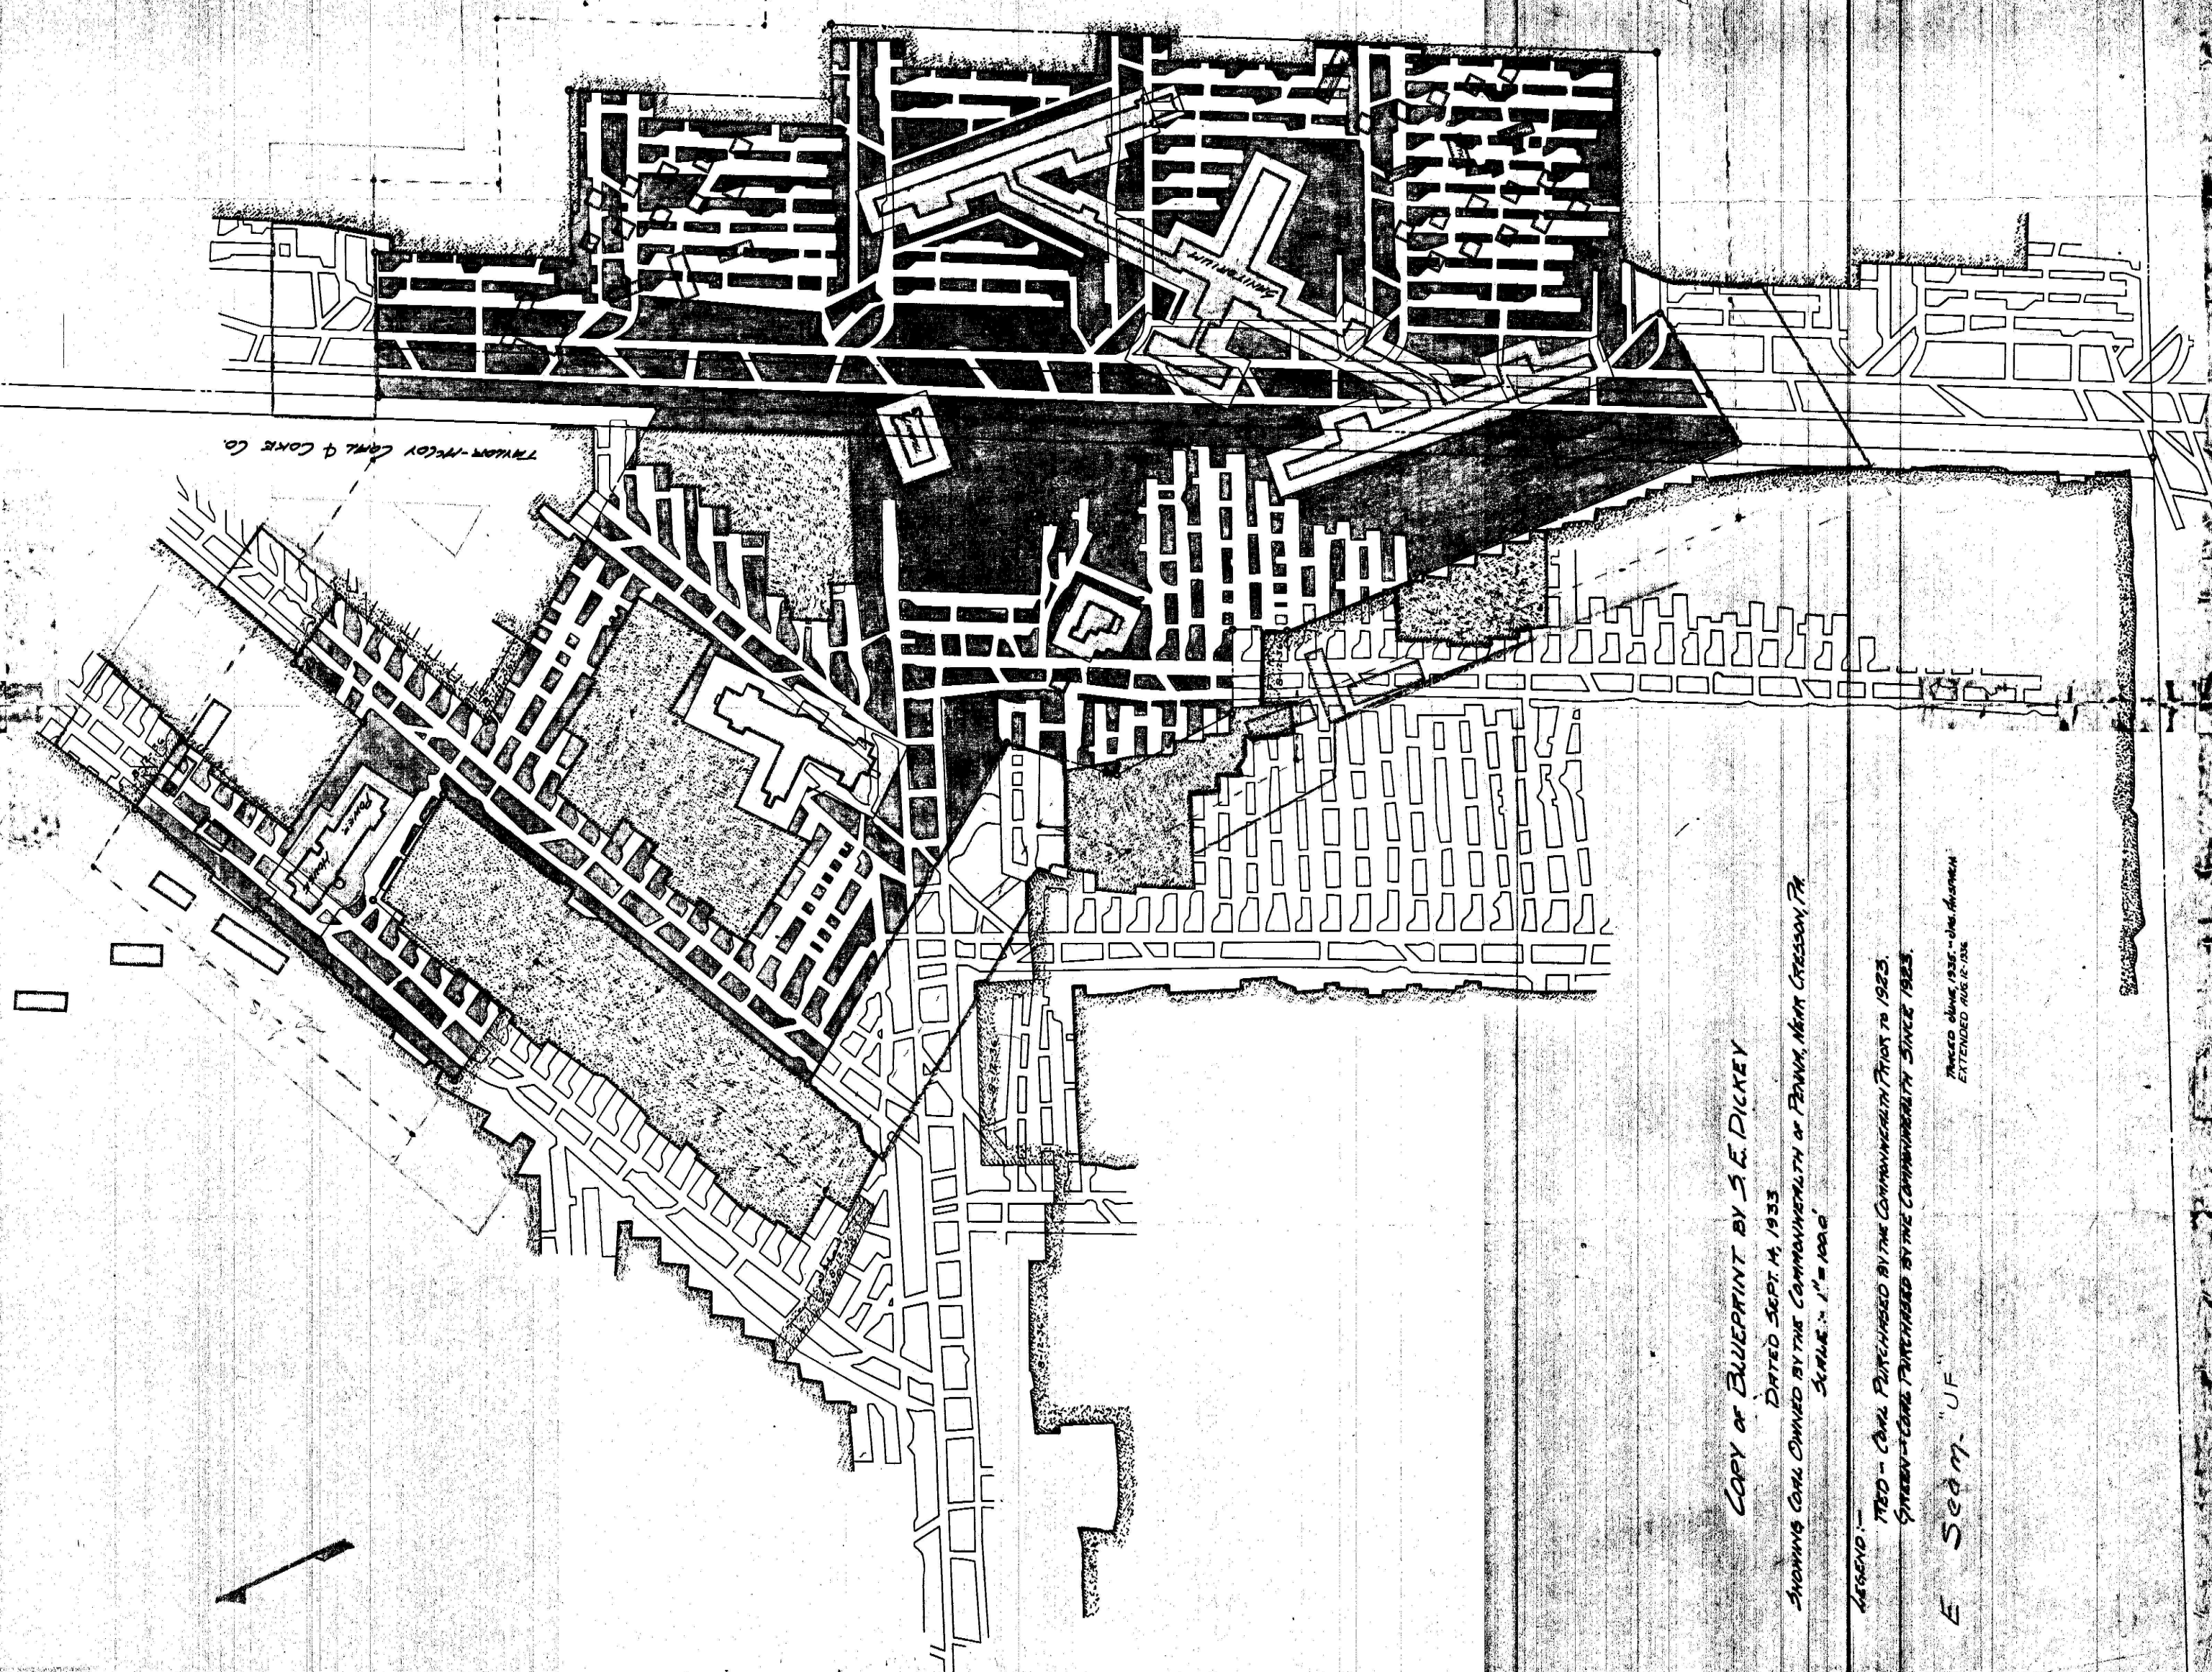

COPY OF BLUEPRINT BY S.E. DICKEY

DATED SEPT. 14, 1933

SHOWING COAL OWNED BY THE COMMONWEALTH OF PENNSYLVANIA, NEAR CRESSON, PA.

SCALE: 1" = 100'

LEGEND:


GREEN - COAL PURCHASED BY THE COMMONWEALTH SINCE 1923.



