


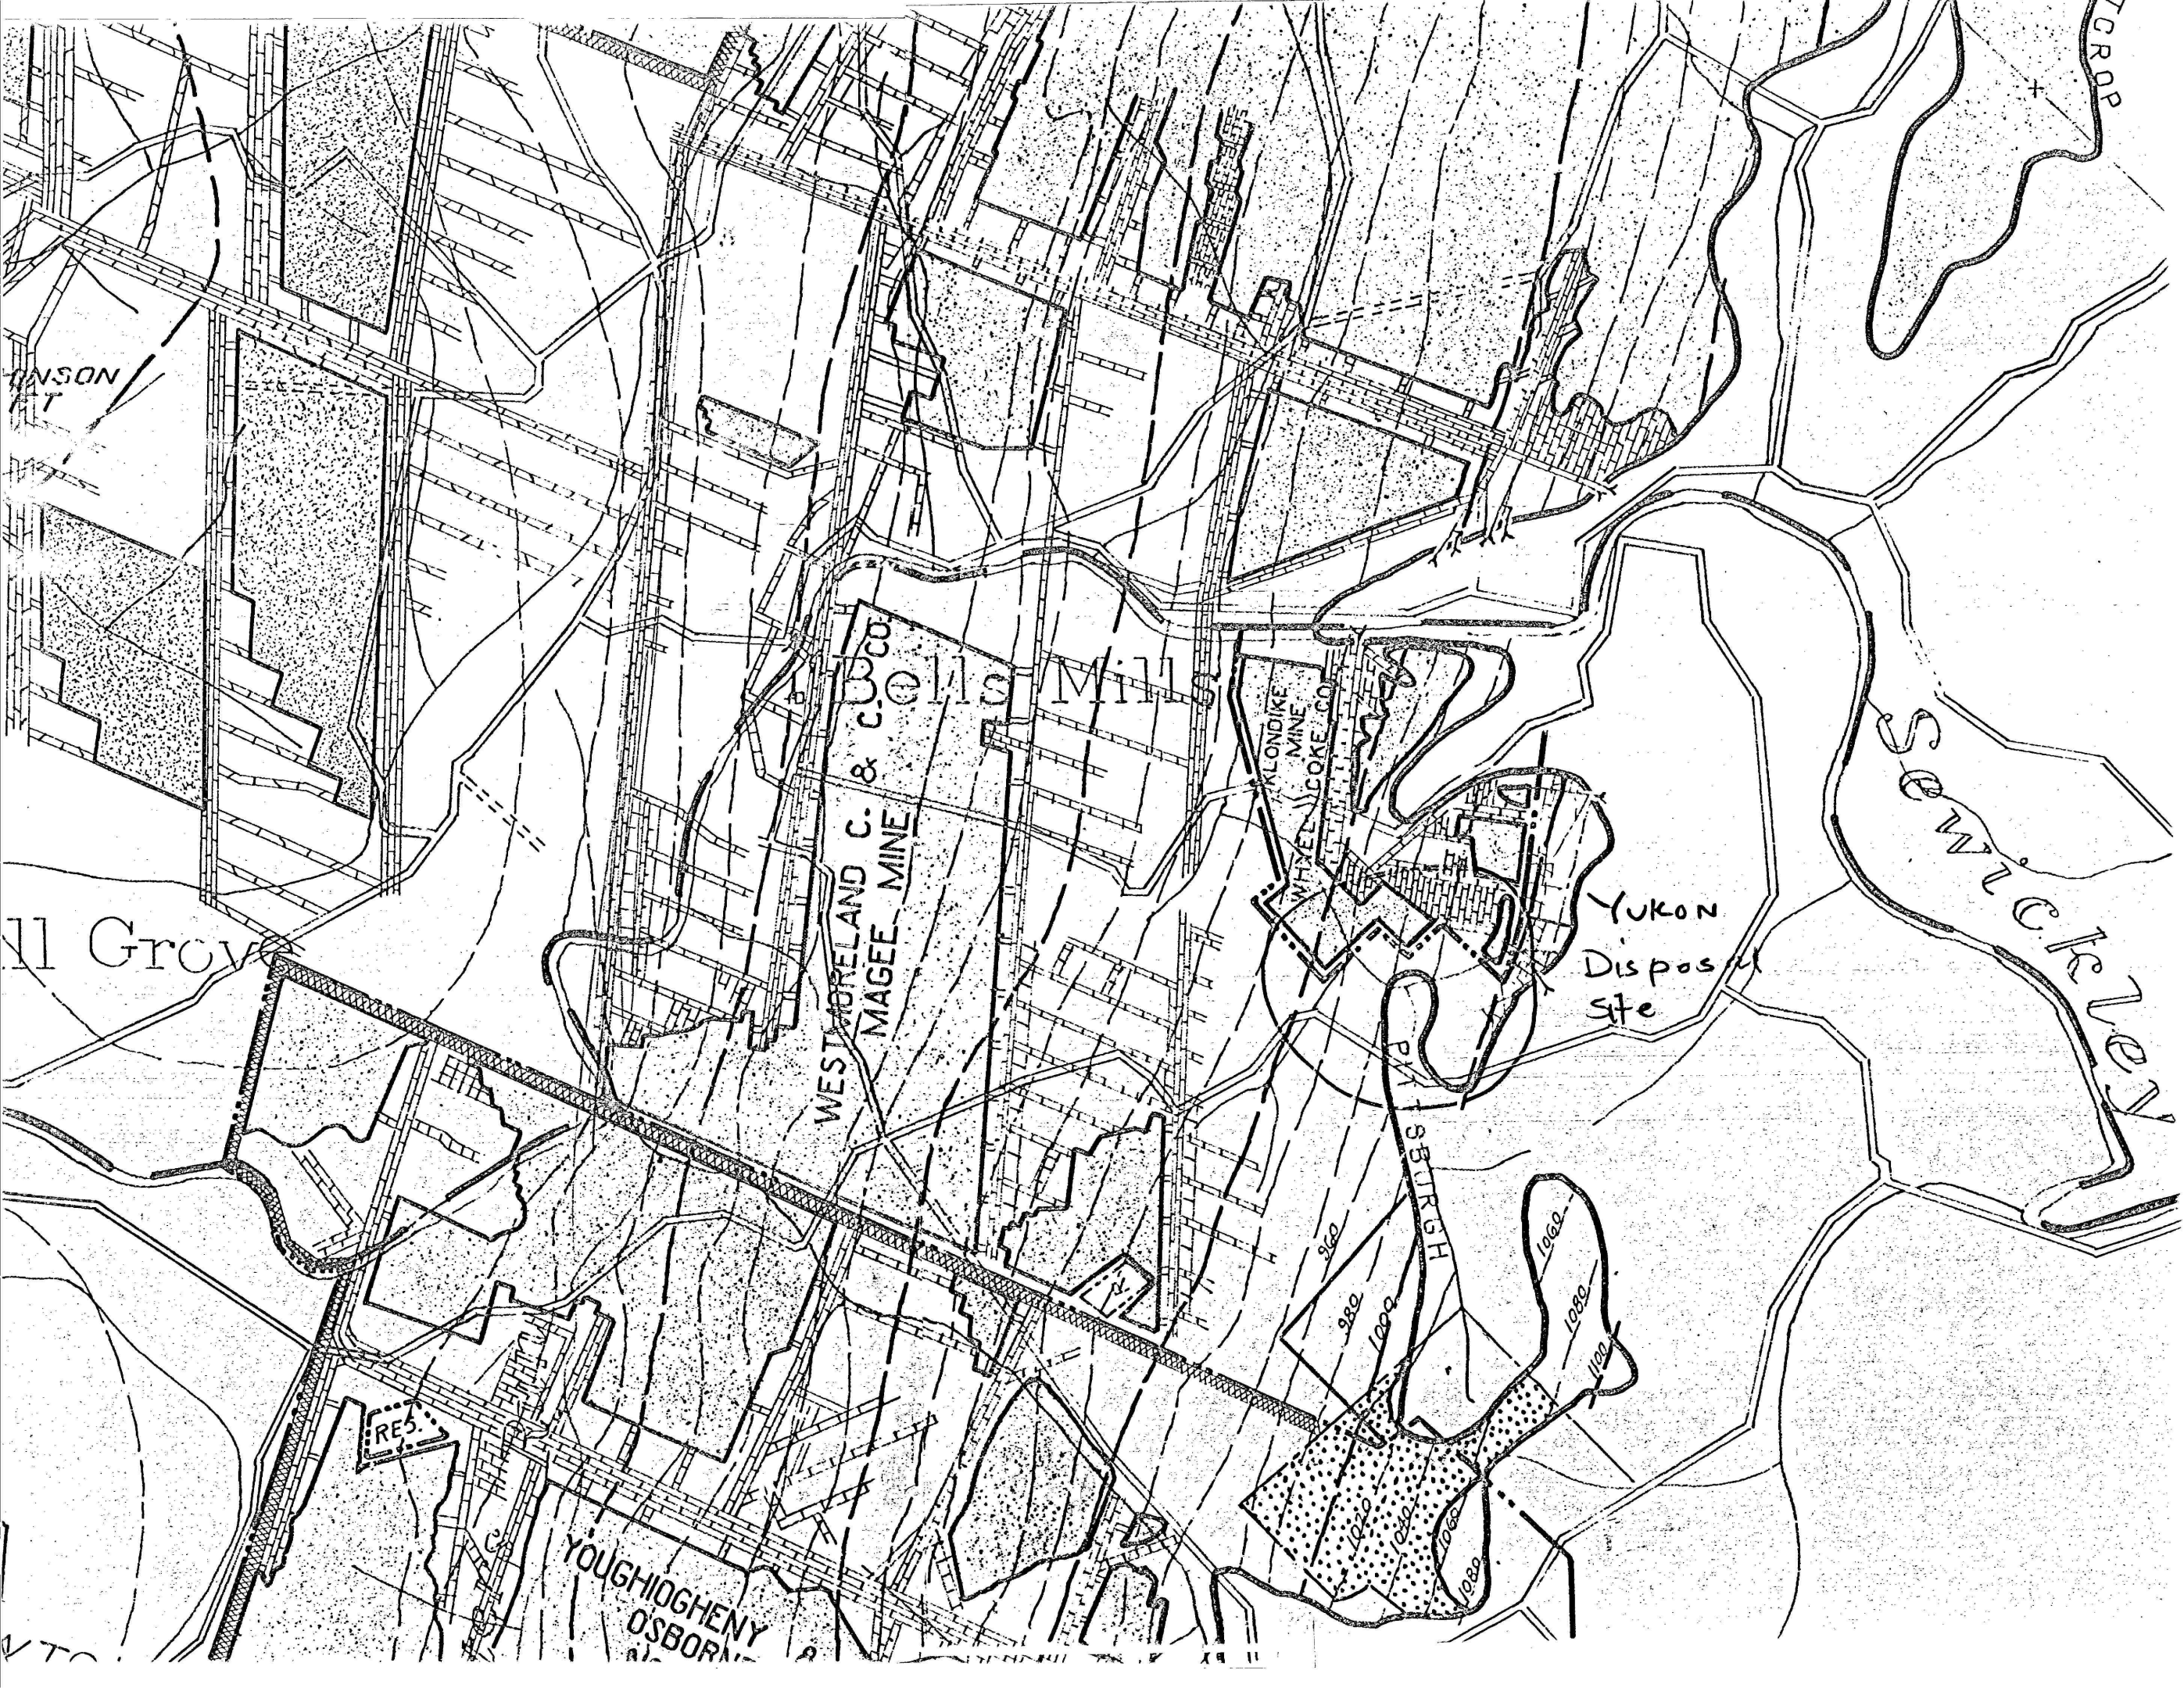

JANSON ST

Hill Grove

WESTMORELAND C. & CO. CO.
MAGEE MINE
MILL

KLONDIKE MINE
WHEEL COKE CO.

Yukon Dispos. Site

Sawichley

RES.

YOUGHIOGHENY
OSBORNE

PIA SBOURGH

