


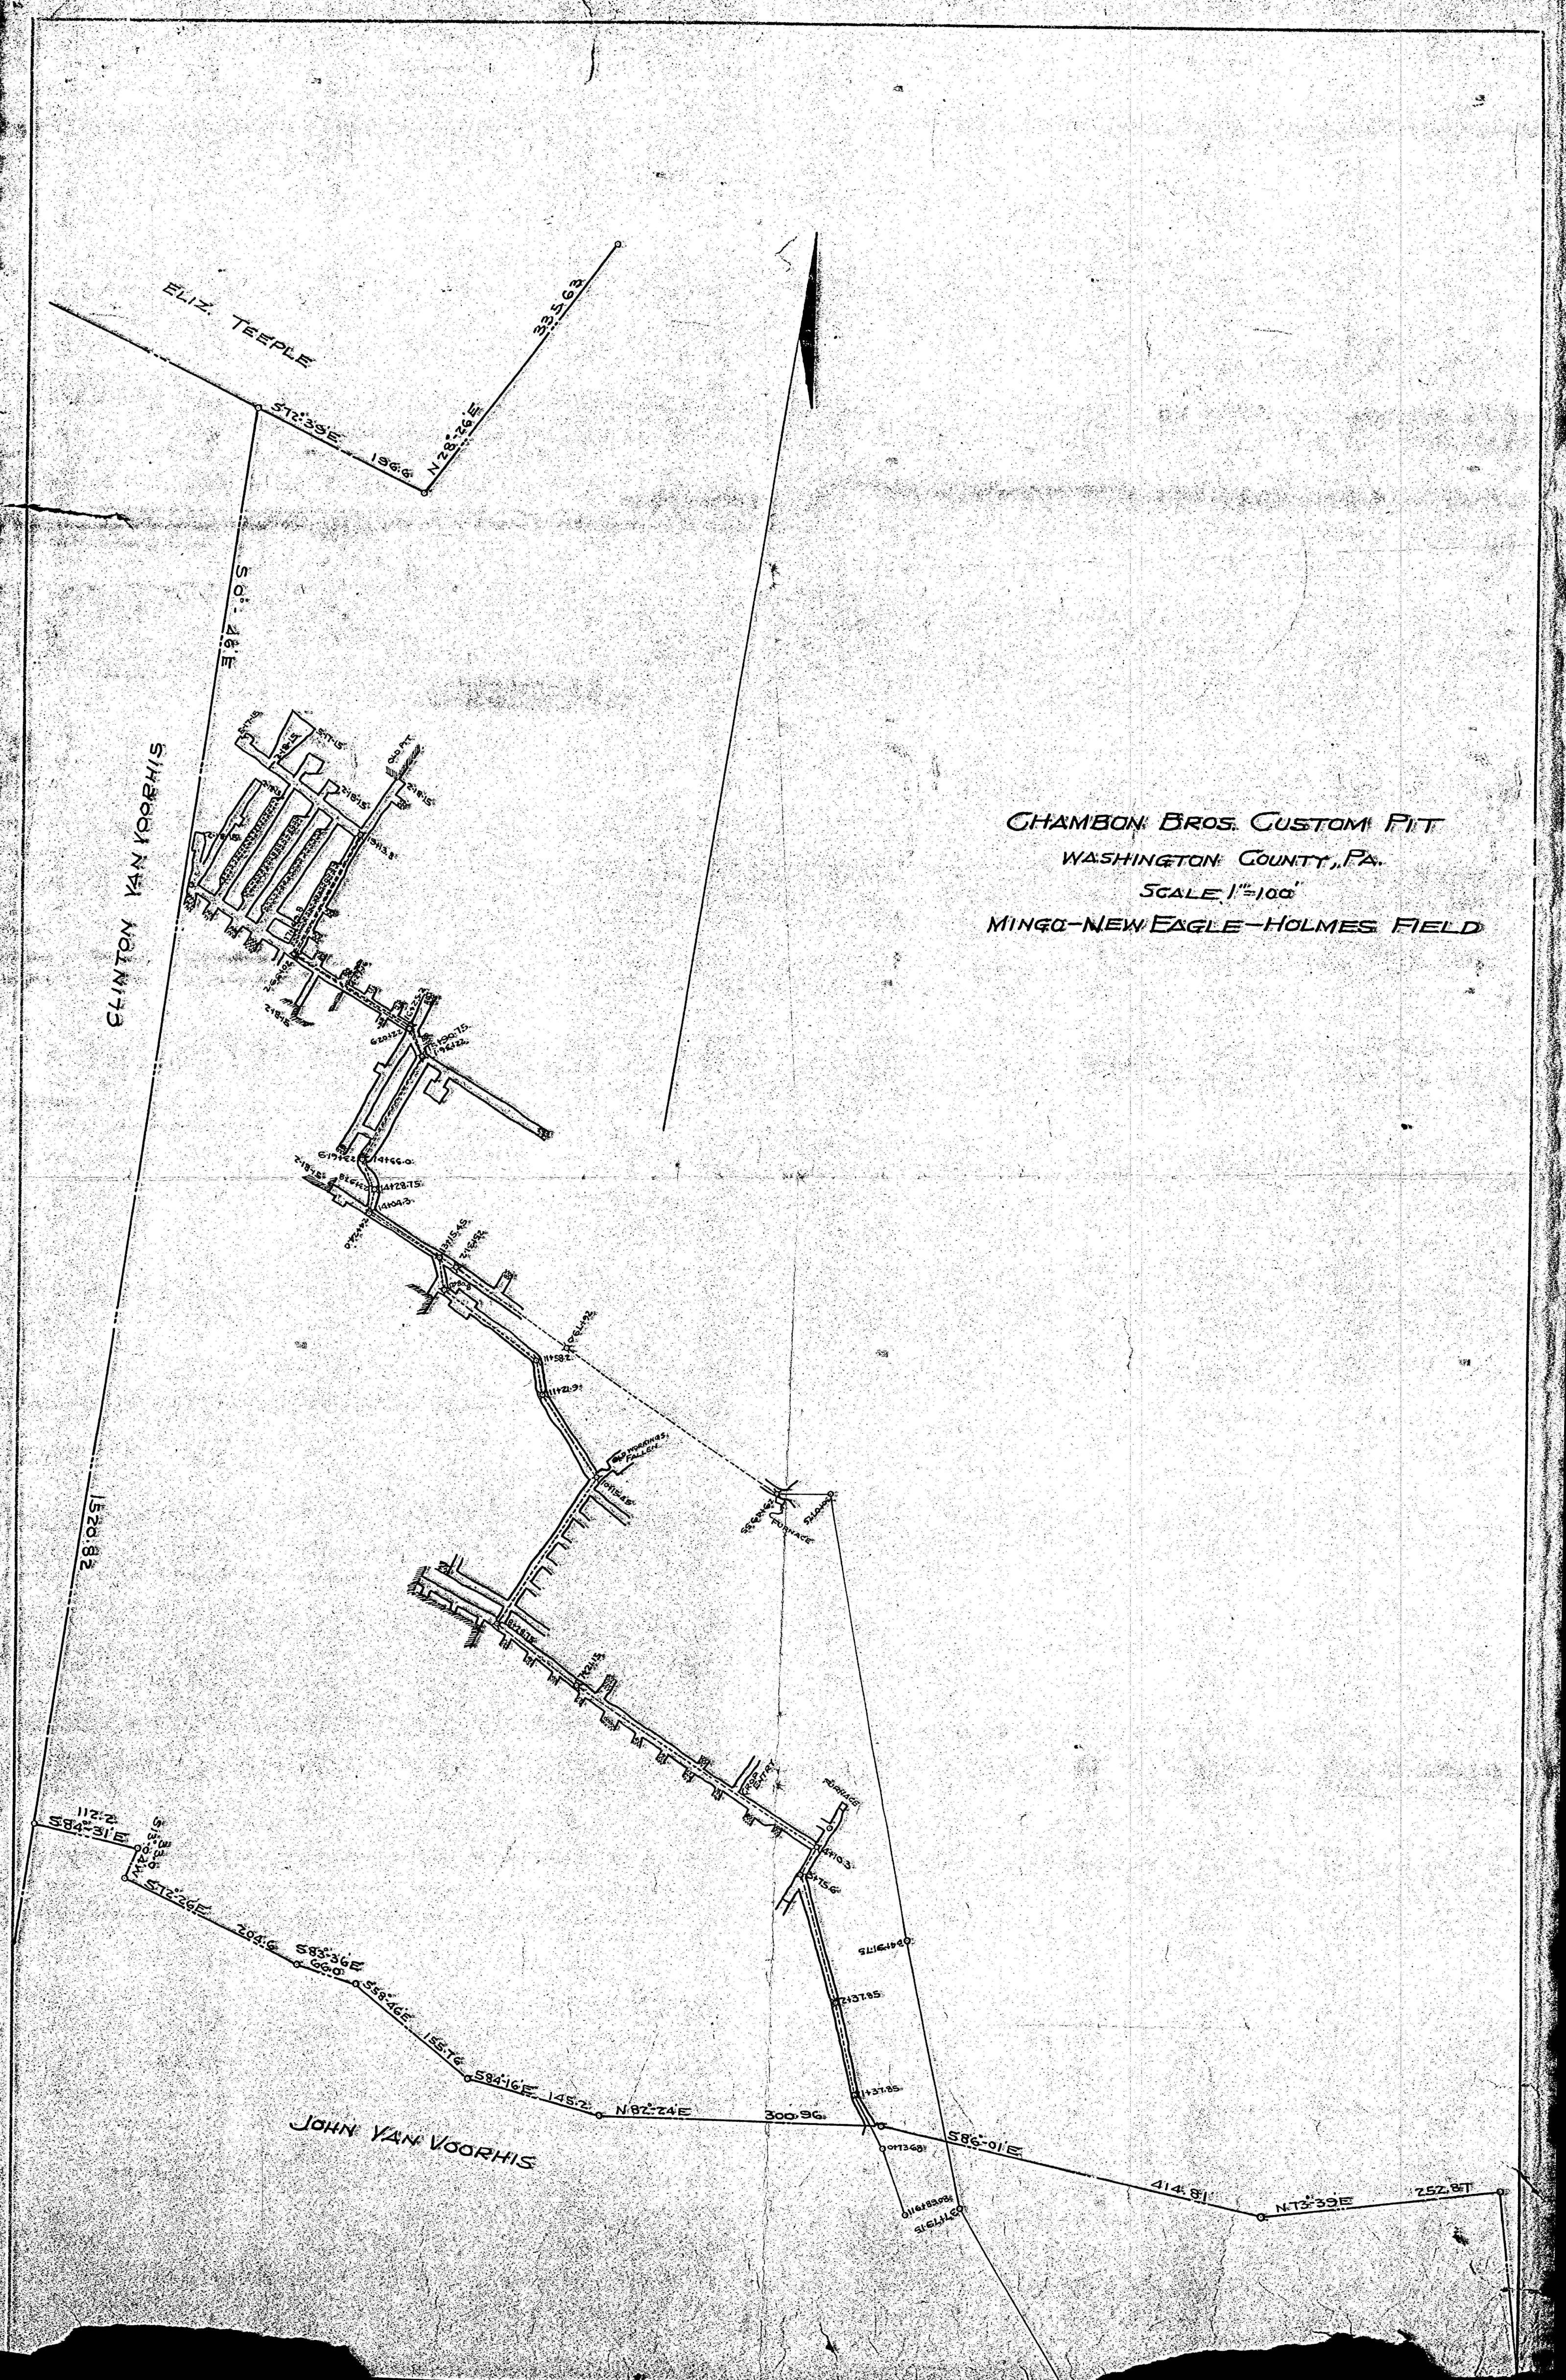

WASHINGTON COUNTY, PA.
SCALE 1"=100'
MINGO-NEW EAGLE-HOLMES FIELD