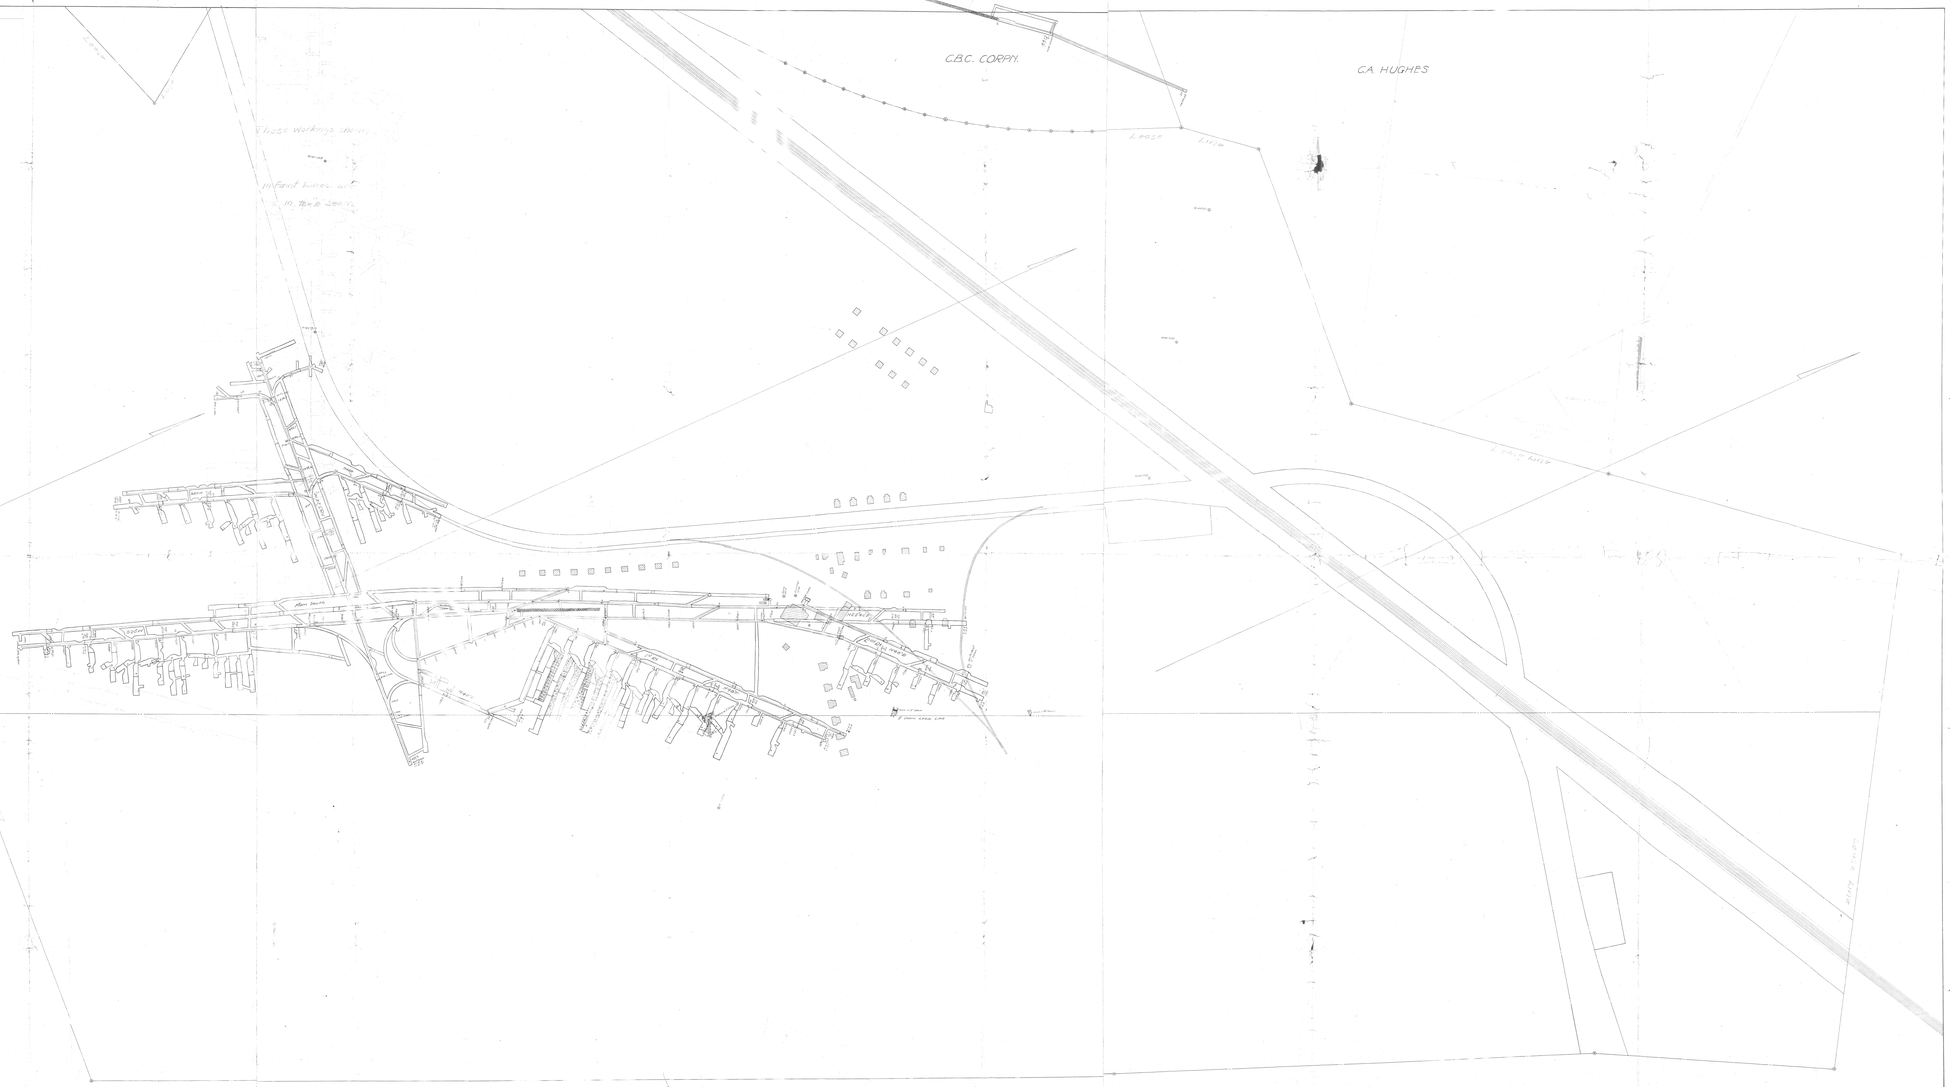


No. 11

MAP OF THE

SONMAN SHAFT

WORKINGS ON C PRIME SEAM

OPERATED BY THE

SONMAN SHAFT COAL CO.

ON LANDS OF THE

CAMBRIA MINING AND MANUFACTURING CO.

AT

SONMAN CAMBRIA CO. PA.

SCALE 1 IN = 100 FT

ALTOONA PA.

CIVIL & MINING ENGINEERS.