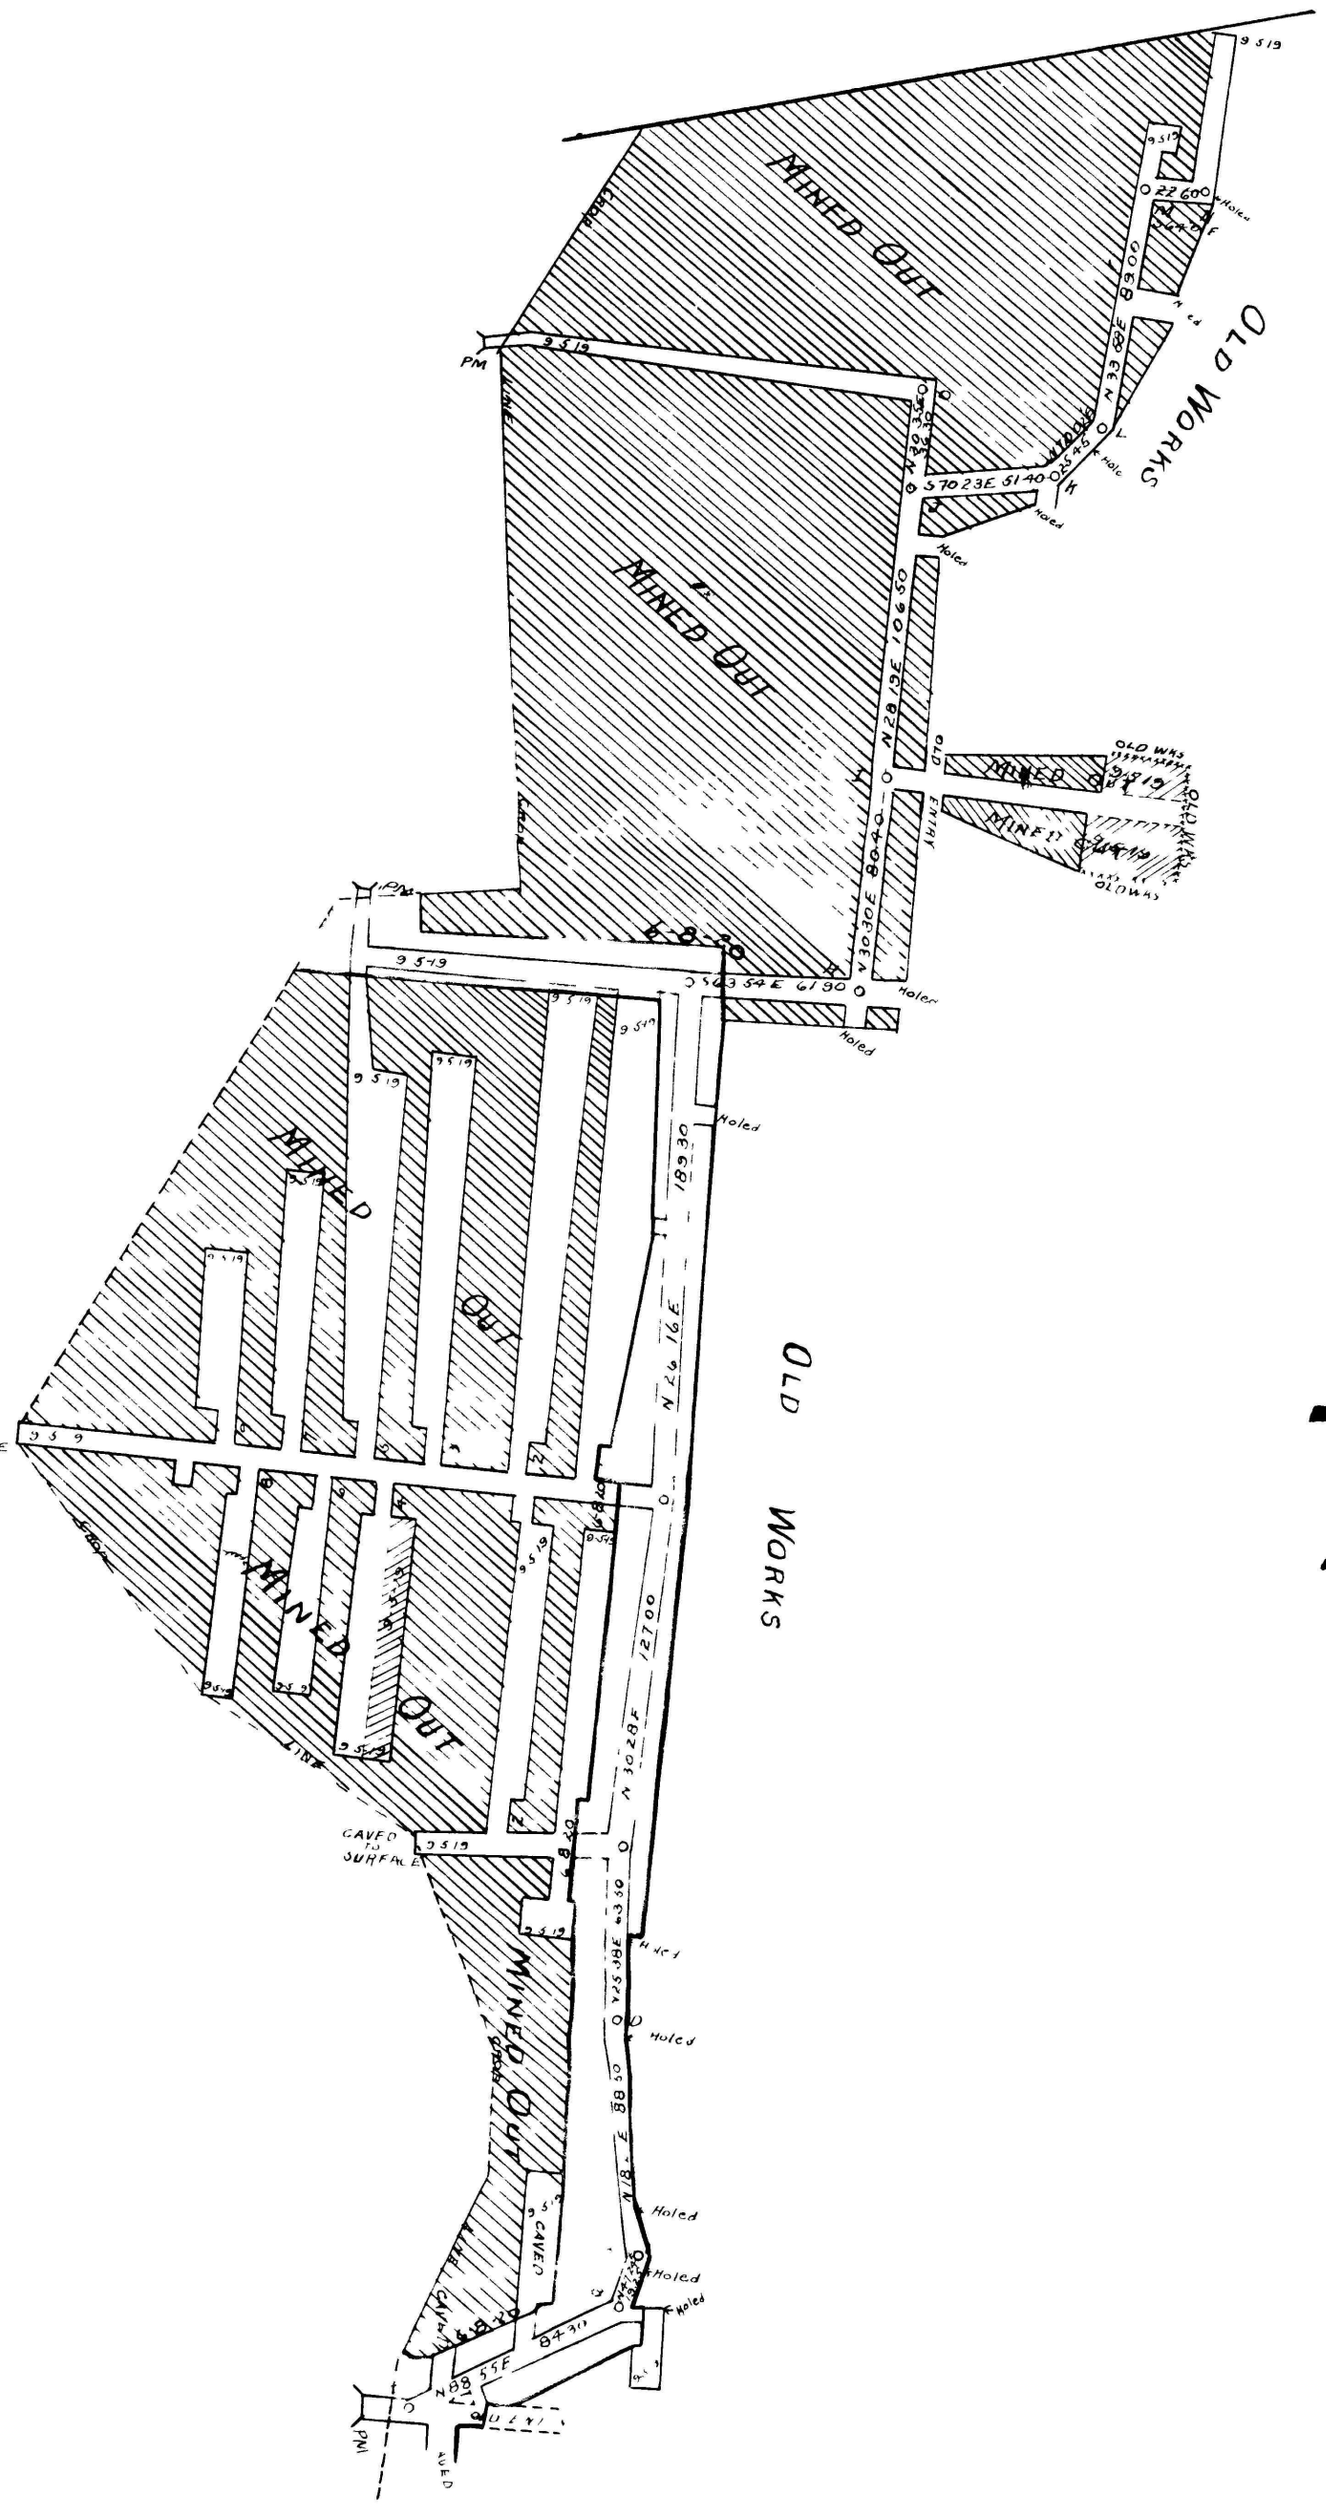

PLAN OF HAYS COAL CO. MINE,

Situated in Hays Boro., Allegheny County Pa.

SCALE 1 IN. = 50 FT.

October. 1919.

F. L. HILL ENG
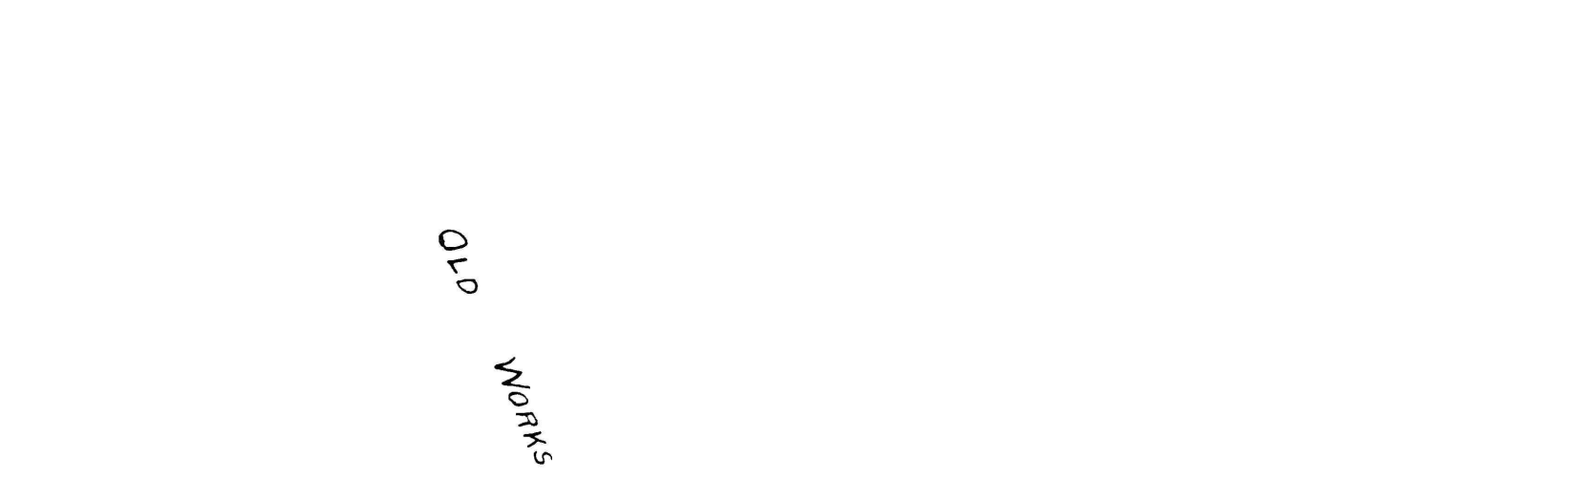
UNMINED COAL TINTED RED JUNE 1 1920 = 0.25 ACRE