


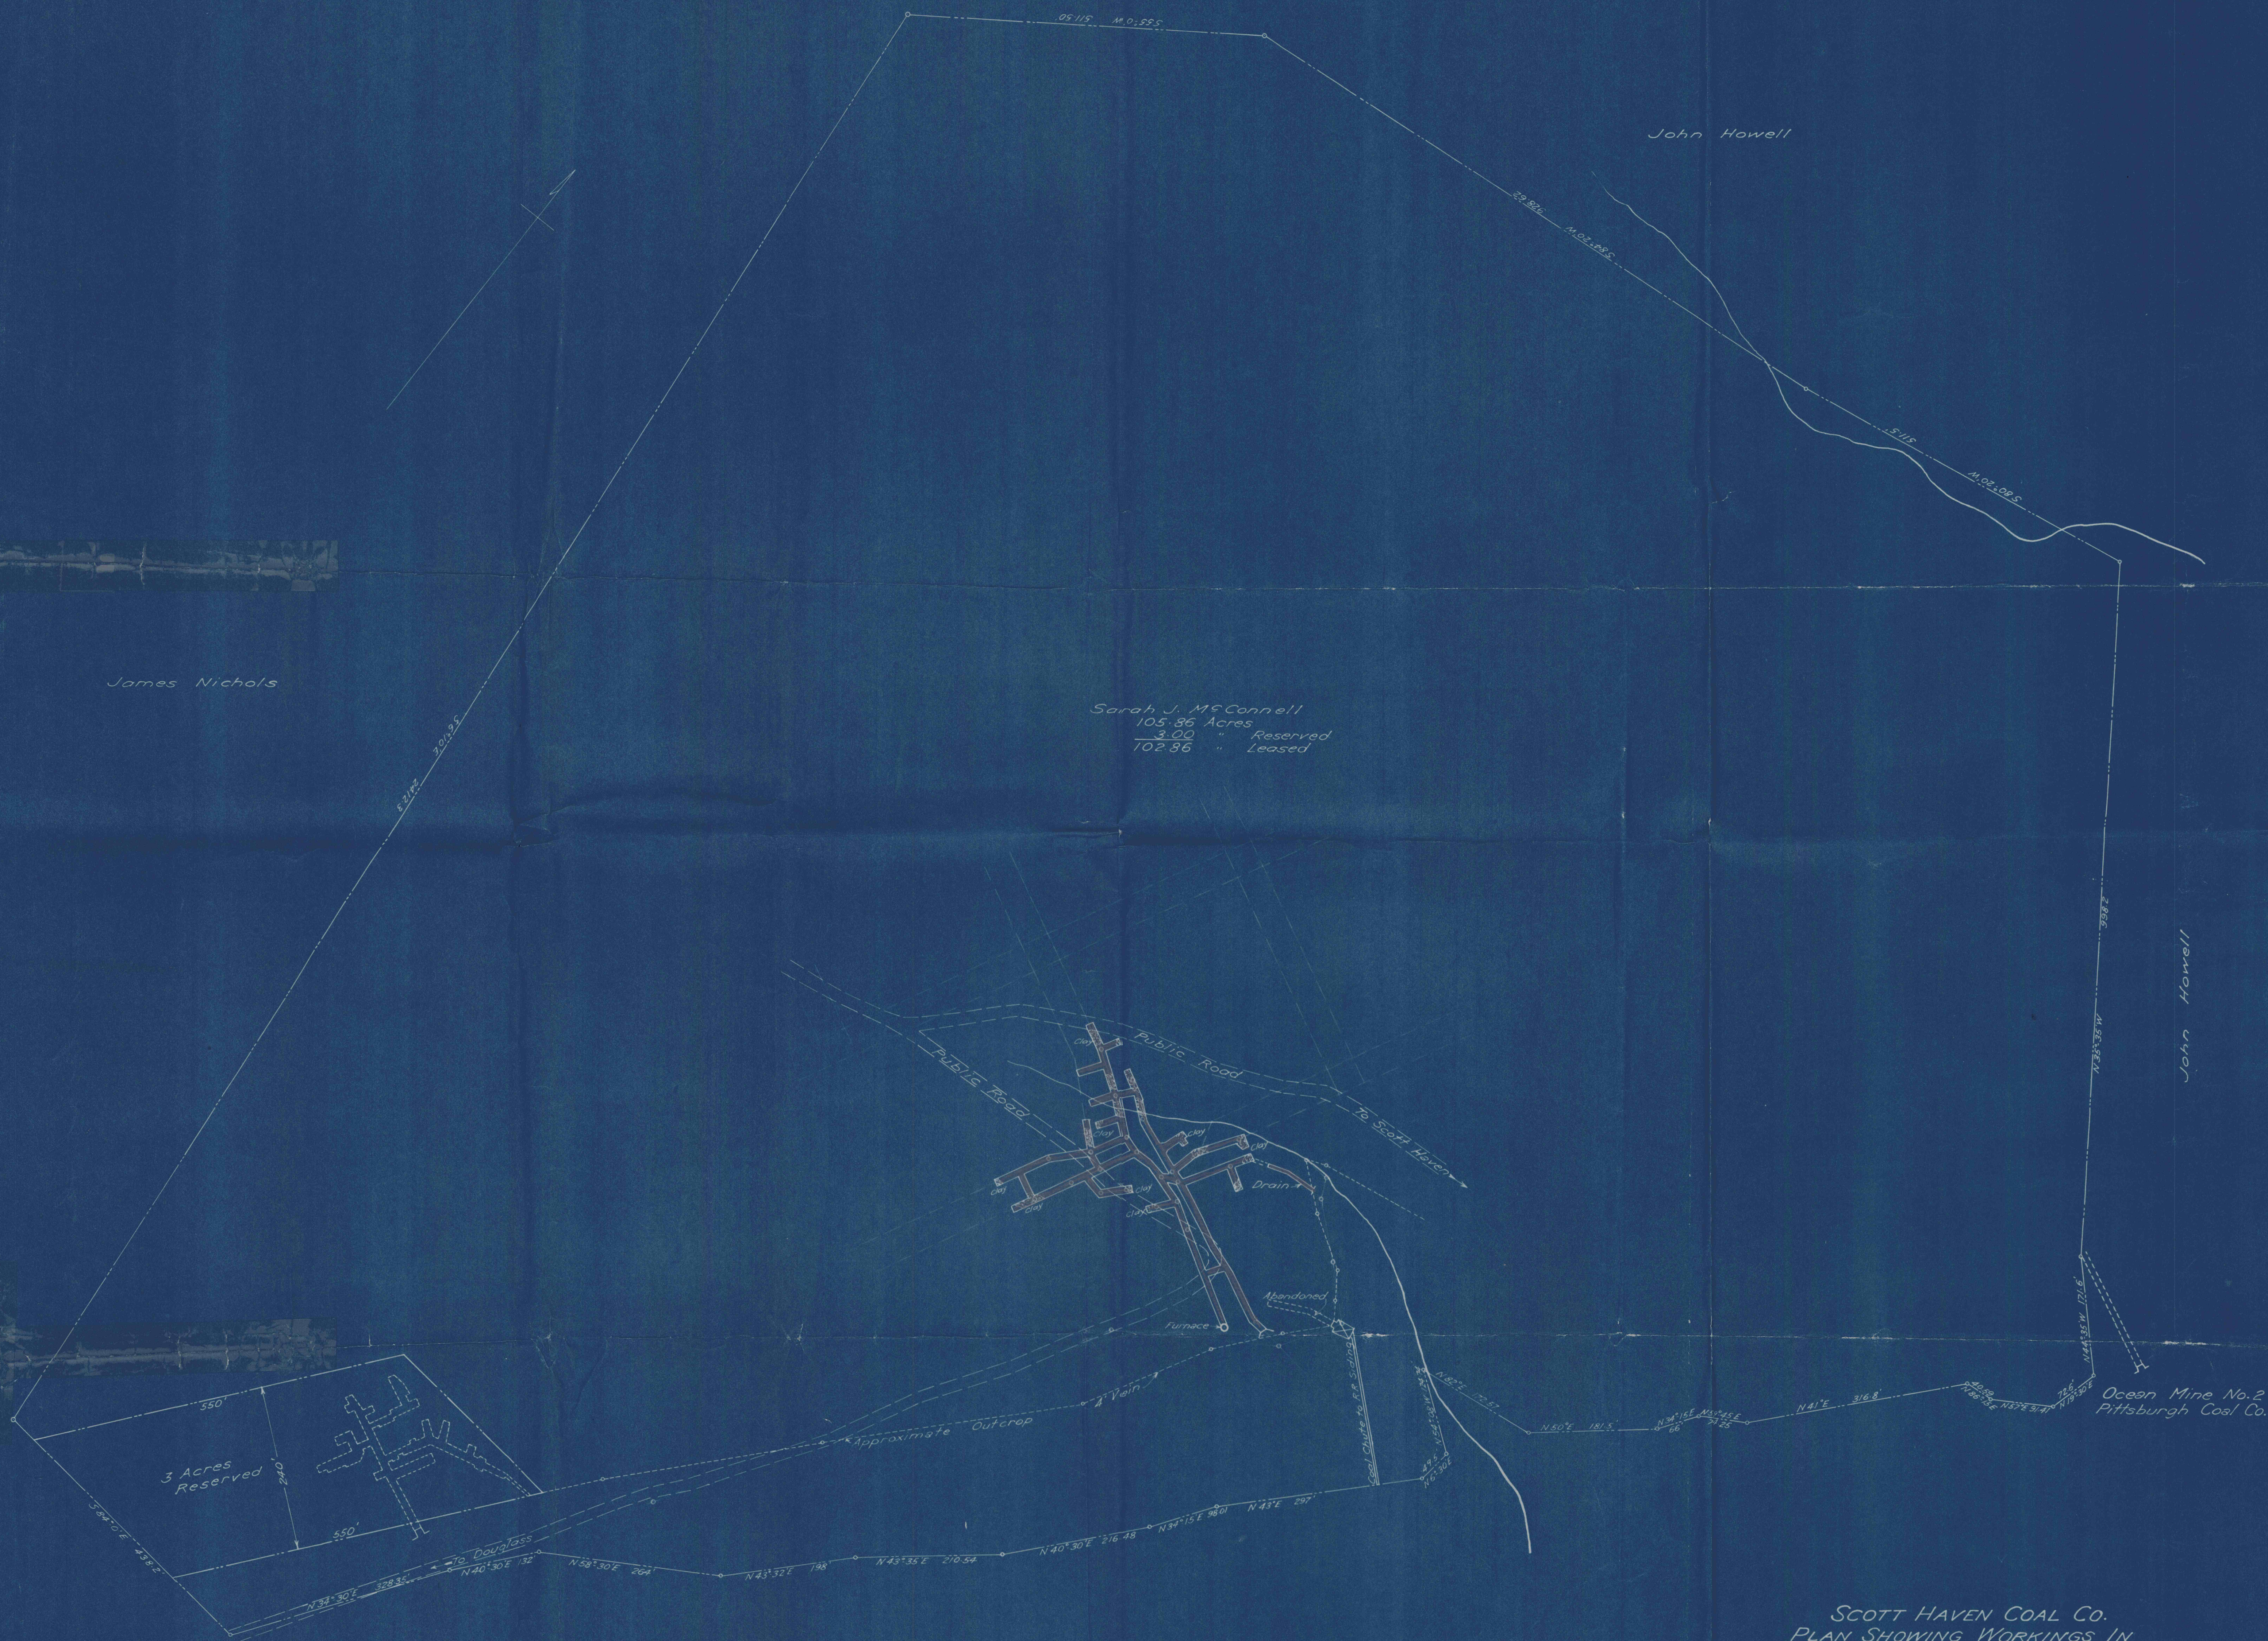

SCOTT HAVEN COAL CO.
PLAN SHOWING WORKINGS IN
FOUR FOOT VEIN OF COAL
IN SARAH J. McCONNELL TRACT
SITUATED IN ELIZABETH TWP, ALLEGHENY CO.
Scale 1"=100' June 1920
Note - Coal Mined is Red Stone Vein