


31829
July 17, 1943

I hereby certify that this tracing is a true and correct copy of the original map of the Bowers and Neal Mine, situate in Banks Township, Indiana County, Pa.

Walter J. Zimmerman
M. J. Zimmerman
Reg. Surveyor No. 4940

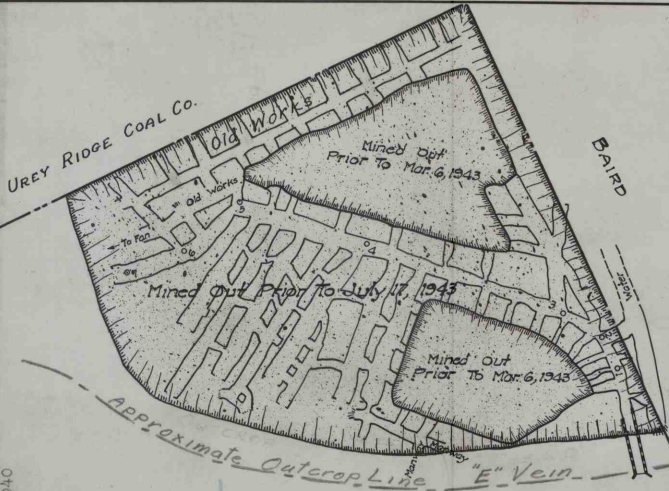

MAP OF
BOWERS & NEAL
MINE

BANKS TOWNSHIP INDIANA COUNTY PA.

SCALE 1"=100' MARCH 1943

WALTER J. ZIMMERMAN SURVEYOR
PUNKSUTAWNEY PENNA.

#3316
6-15-99
C.C.