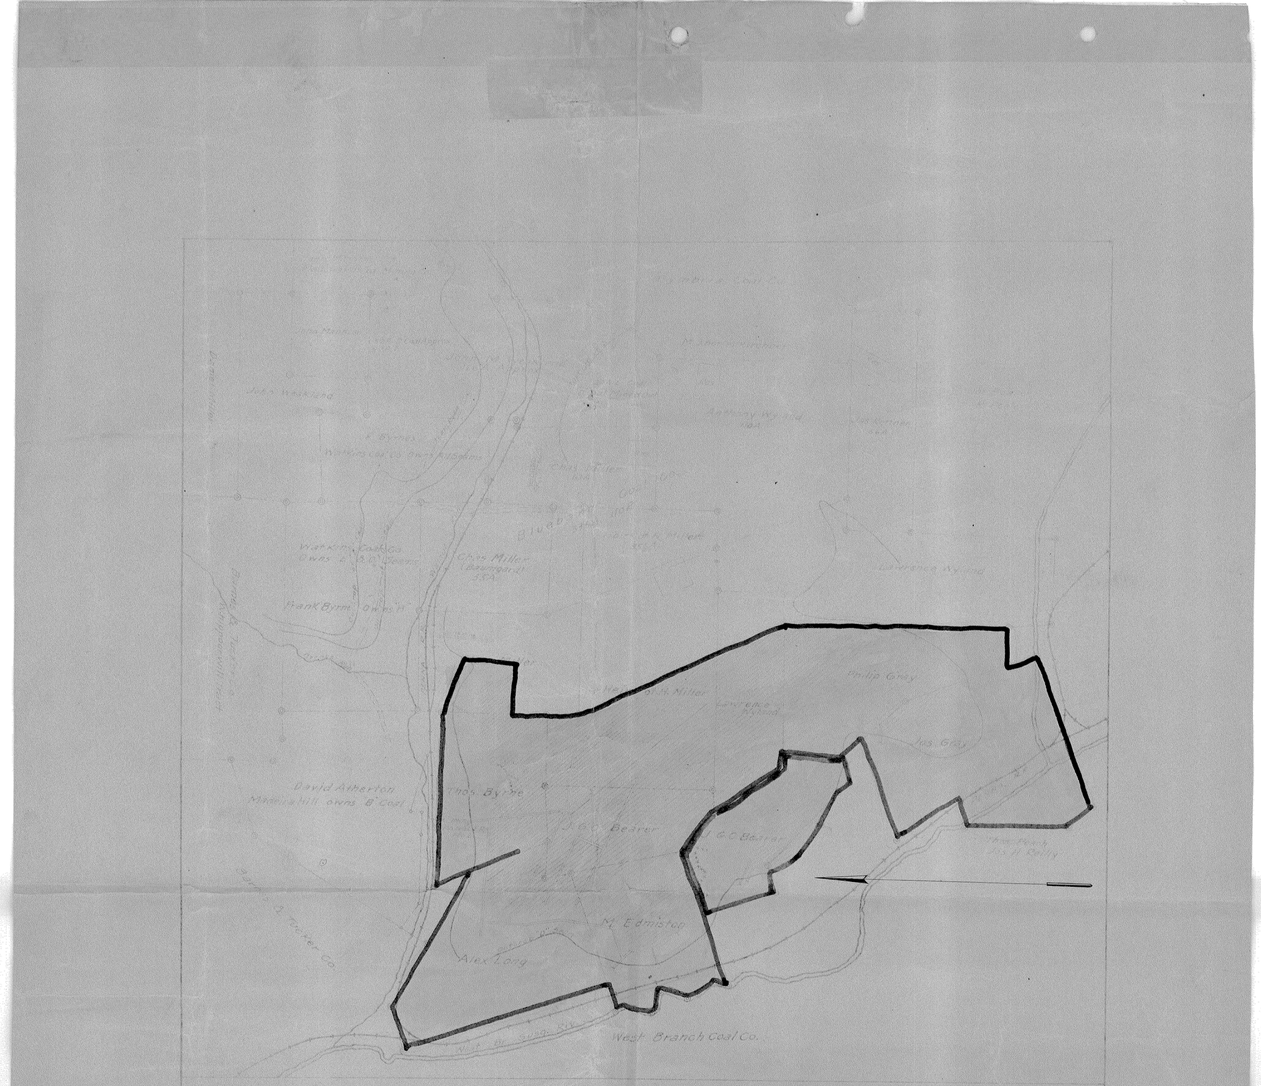


SPANGLER No. 2 MINE
'D' SEAM
OPERATED BY MADEIRA HILL COAL MINING CO.
SITUATED IN SUSQUEHANNA TOWNSHIP, CAMBRIA CO. PA.
SCALE: 1IN.=200FT. DEC. 1, 1920

LEGEND

Original Acreage 389.7
Less Faults & Outcrops 90.0
Acreage Worked Out 235.6
Remaining 64.1

WALNUT RUN COAL CO. LANDS LEASED TO MADEIRA HILL COAL MINING CO.

Original Acreage 50.3
Less Faults & Outcrops 0.0
Acreage Worked Out 50.3
" Remaining 0.0

BETTS & HIGLER LANDS

ROBBED

ROLL

FAULT