


BLUE - MAIN INTAKE
BROWN - MAIN RETURN

LEASEHOLDS AND OWNERSHIPS
OF THE
SONMAN SHAFT COAL CO.
IN THE
"E" OR UPPER FREEPORT SEAM.
PORTAGE AND SUMMERHILL TOWNSHIPS, CAMBRIA COUNTY, PA.
SCALE 1"=400'
WORKINGS SHOWN TO 6-1-40
W.A. SULLIVAN
ENGINEER
ALTOONA, PA.

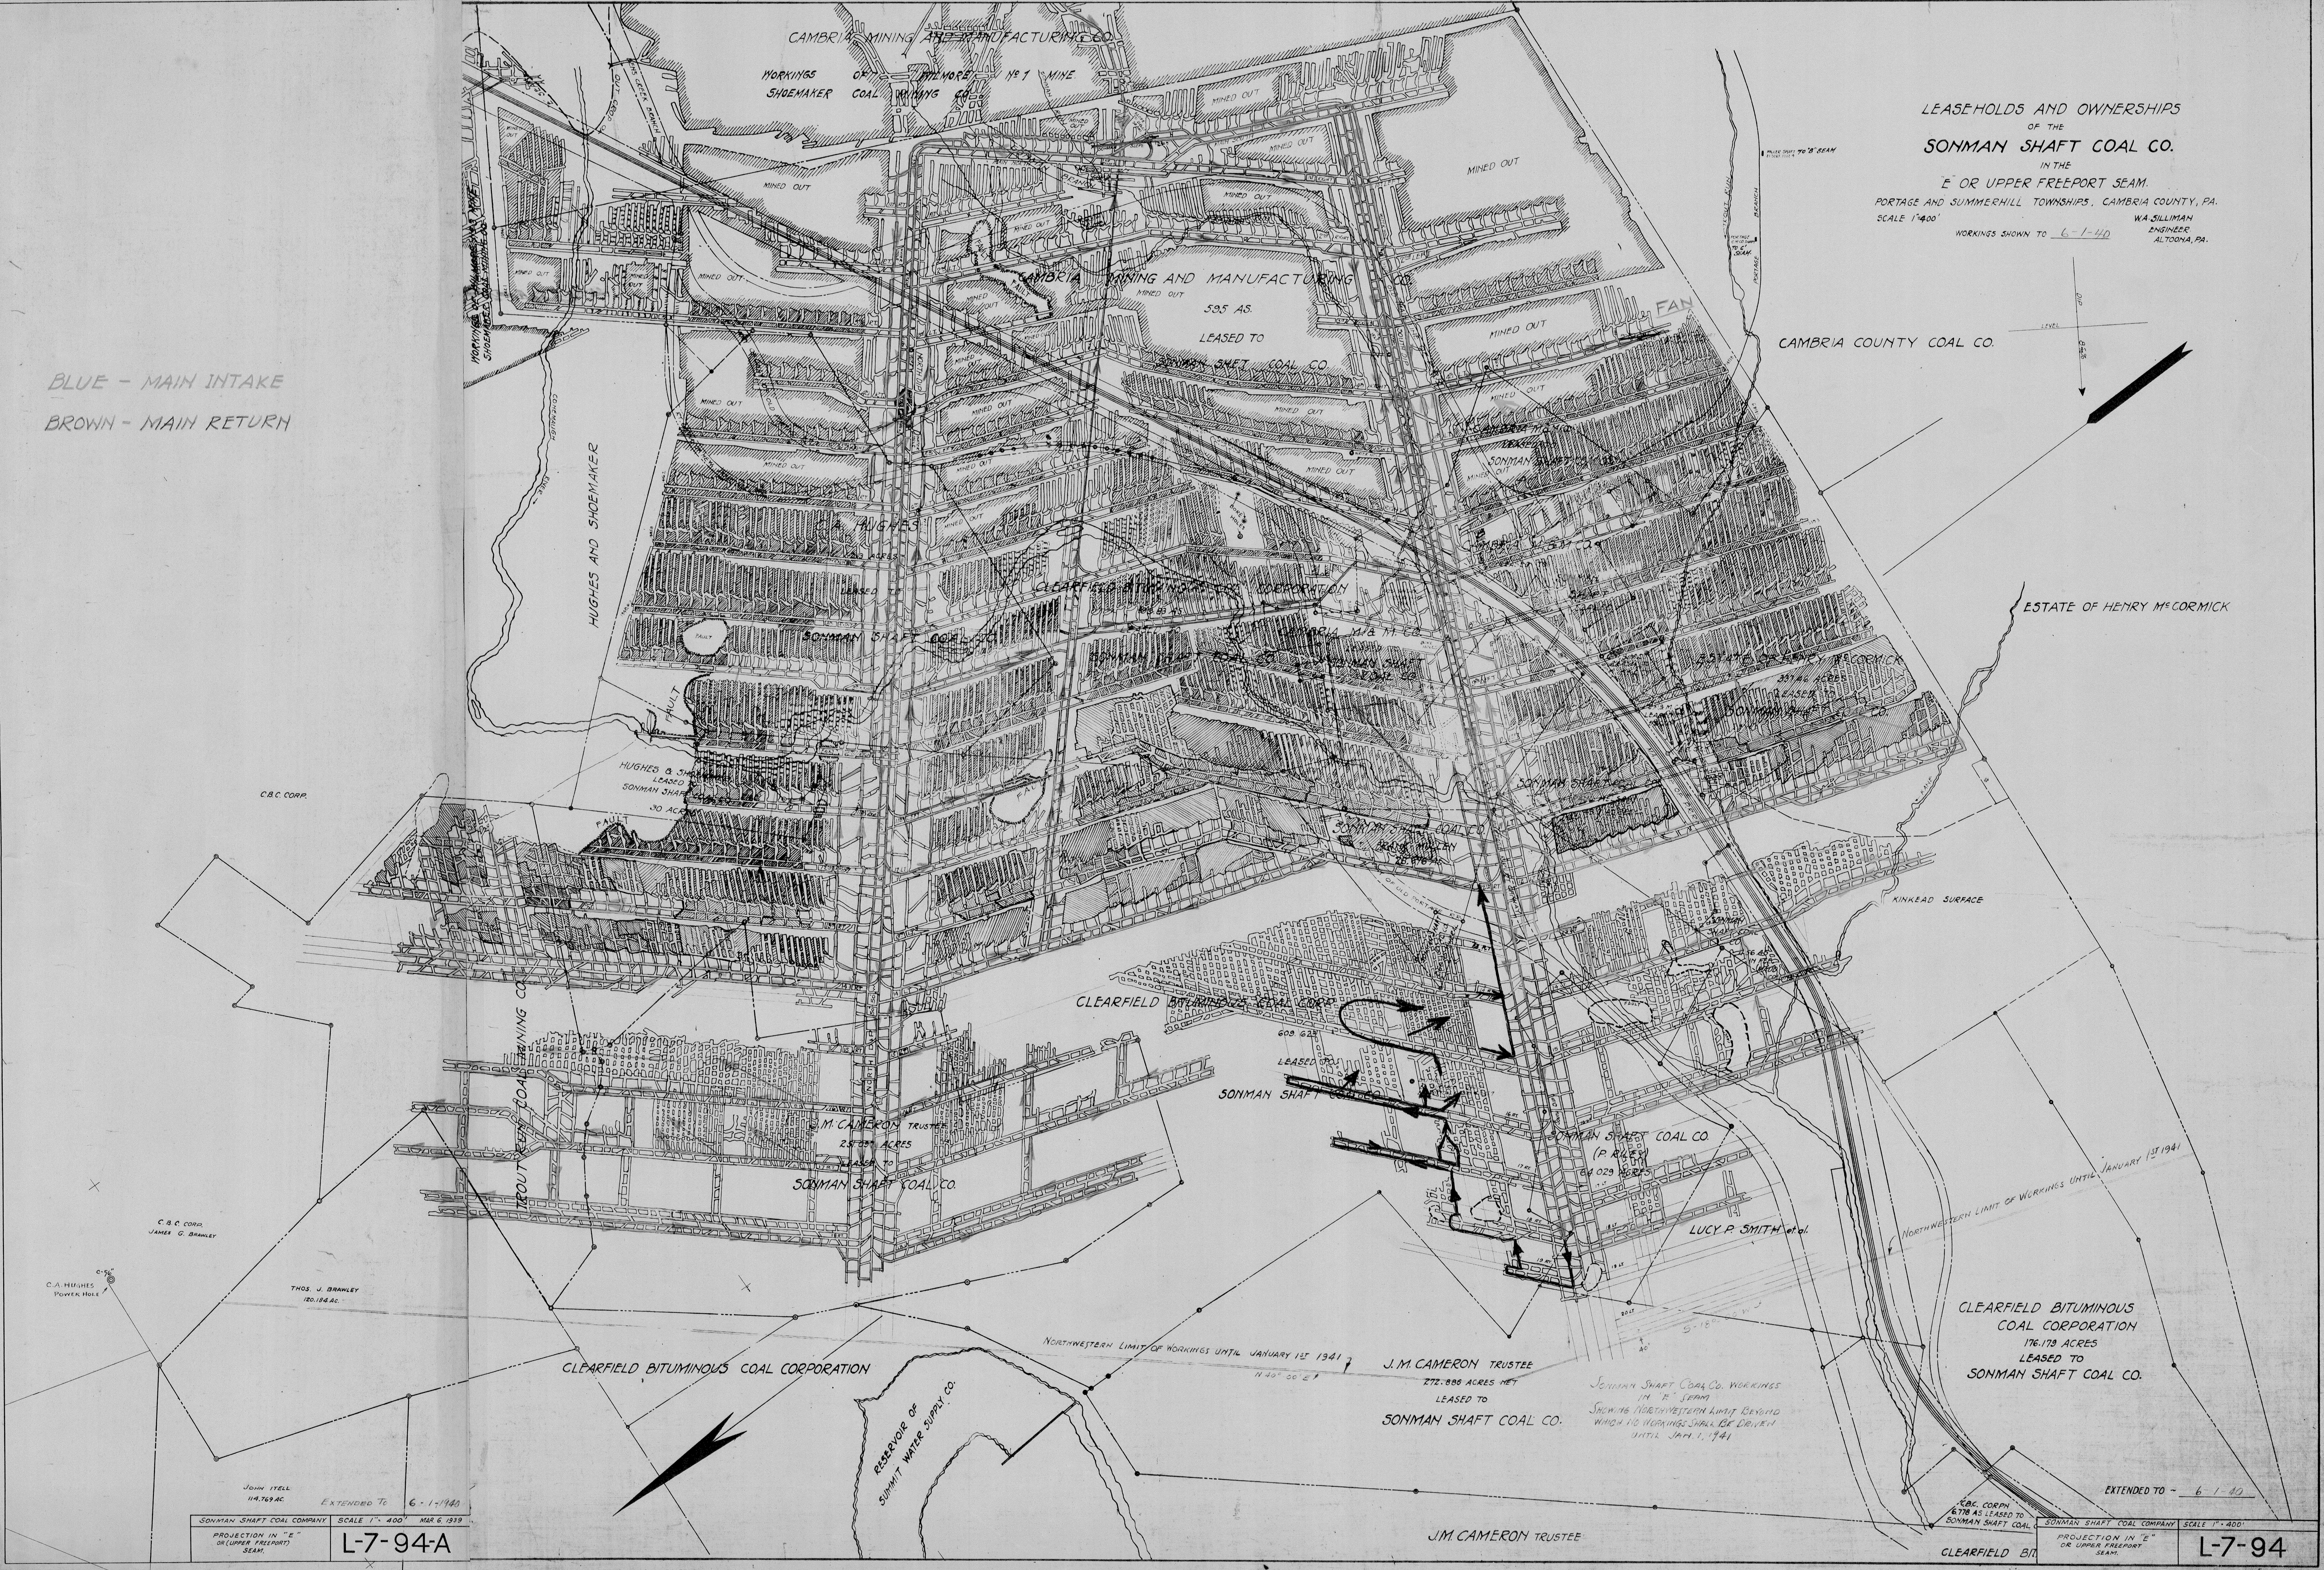

SONMAN SHAFT COAL COMPANY
SCALE 1"=400' MAR. 6, 1939
PROJECTION IN "E"
OR UPPER FREEPORT
SEAM.
L-7-94-A

J.M. CAMERON TRUSTEE

SONMAN SHAFT COAL COMPANY
SCALE 1"=400'
PROJECTION IN "E"
OR UPPER FREEPORT
SEAM.
L-7-94