



MSHA I.D. No. 36-08487

CMAP No. 33941301

CopySystems Demo - Evaluation Version



Doverspike Bros. Coal Co.
R.D. #4, Box 271, Punxsutawney, PA 15767
Knox Twp., Jefferson County

RAMSEYTOWN MINE

SCALE: 1" = 200' SHEET 1 of 2

Final Mine Map

— PERMIT AREA

--- PROPERTY LINES

 PROPERTY OWNERS

 CONT. PROPERTY OWNERS

 UNOCCUPIED DWELLINGS, STRUCTURES

 OCCUPIED DWELLINGS, STRUCTURES

 PROT. ACT 54 STRUCTURES

 L.K. COAL CONTOURS

 L.K. COAL OUTCROP

 GAS WELL

—T— TELE./ELEC. LINES

 WATER WELL

 SPRING

 DRILL HOLE

 IMPOUNDMENT

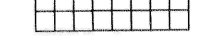
 CEMETERY

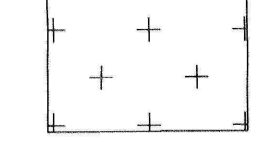
 MINE OPENINGS, NOT SEALED

 PENINGS, SEALED

— STREAMS

 SURVEY STATION

 SUPPORT AREA (No Second Mining)

 NO MINING AREA

 GAS WELL BARRIER (No Mining Within Barrier Unless Approved)

 INTAKE AIR

 RETURN AIR

 BELT LINE

 CHECK CURTAIN

 REGULATOR

 DOUBLE DOORS

 RUN-THROUGH CHECK

 OVERCAST

 STOPPING

 STOPPING W/ DOOR

CopySystems Demo - Evaluation Version

 N

 DIP

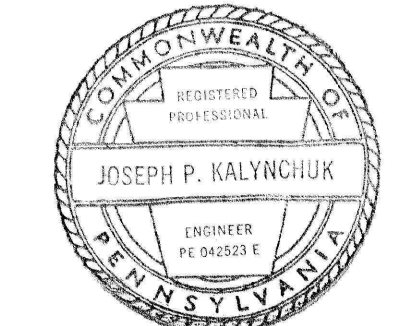
SURVEY IS CLOSED LOOP; ACCURACY IS 1:10000

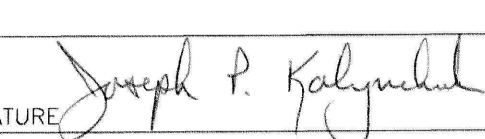
INDIVIDUALS RESPONSIBLE FOR INFORMATION:
CHARLES ISHMAN, ENGINEER & DONALD ISHMAN, SUPERINTENDENT

MAP FULFILLS REQUIREMENTS OF 75.372 & 75.1200

ADJACENT MINE WORKINGS WITHIN 1000 FEET

NO MINE WORKINGS BELOW MINE PROPERTY



SIGNATURE: 

DATE: 4-14-99

Final Mine Map