


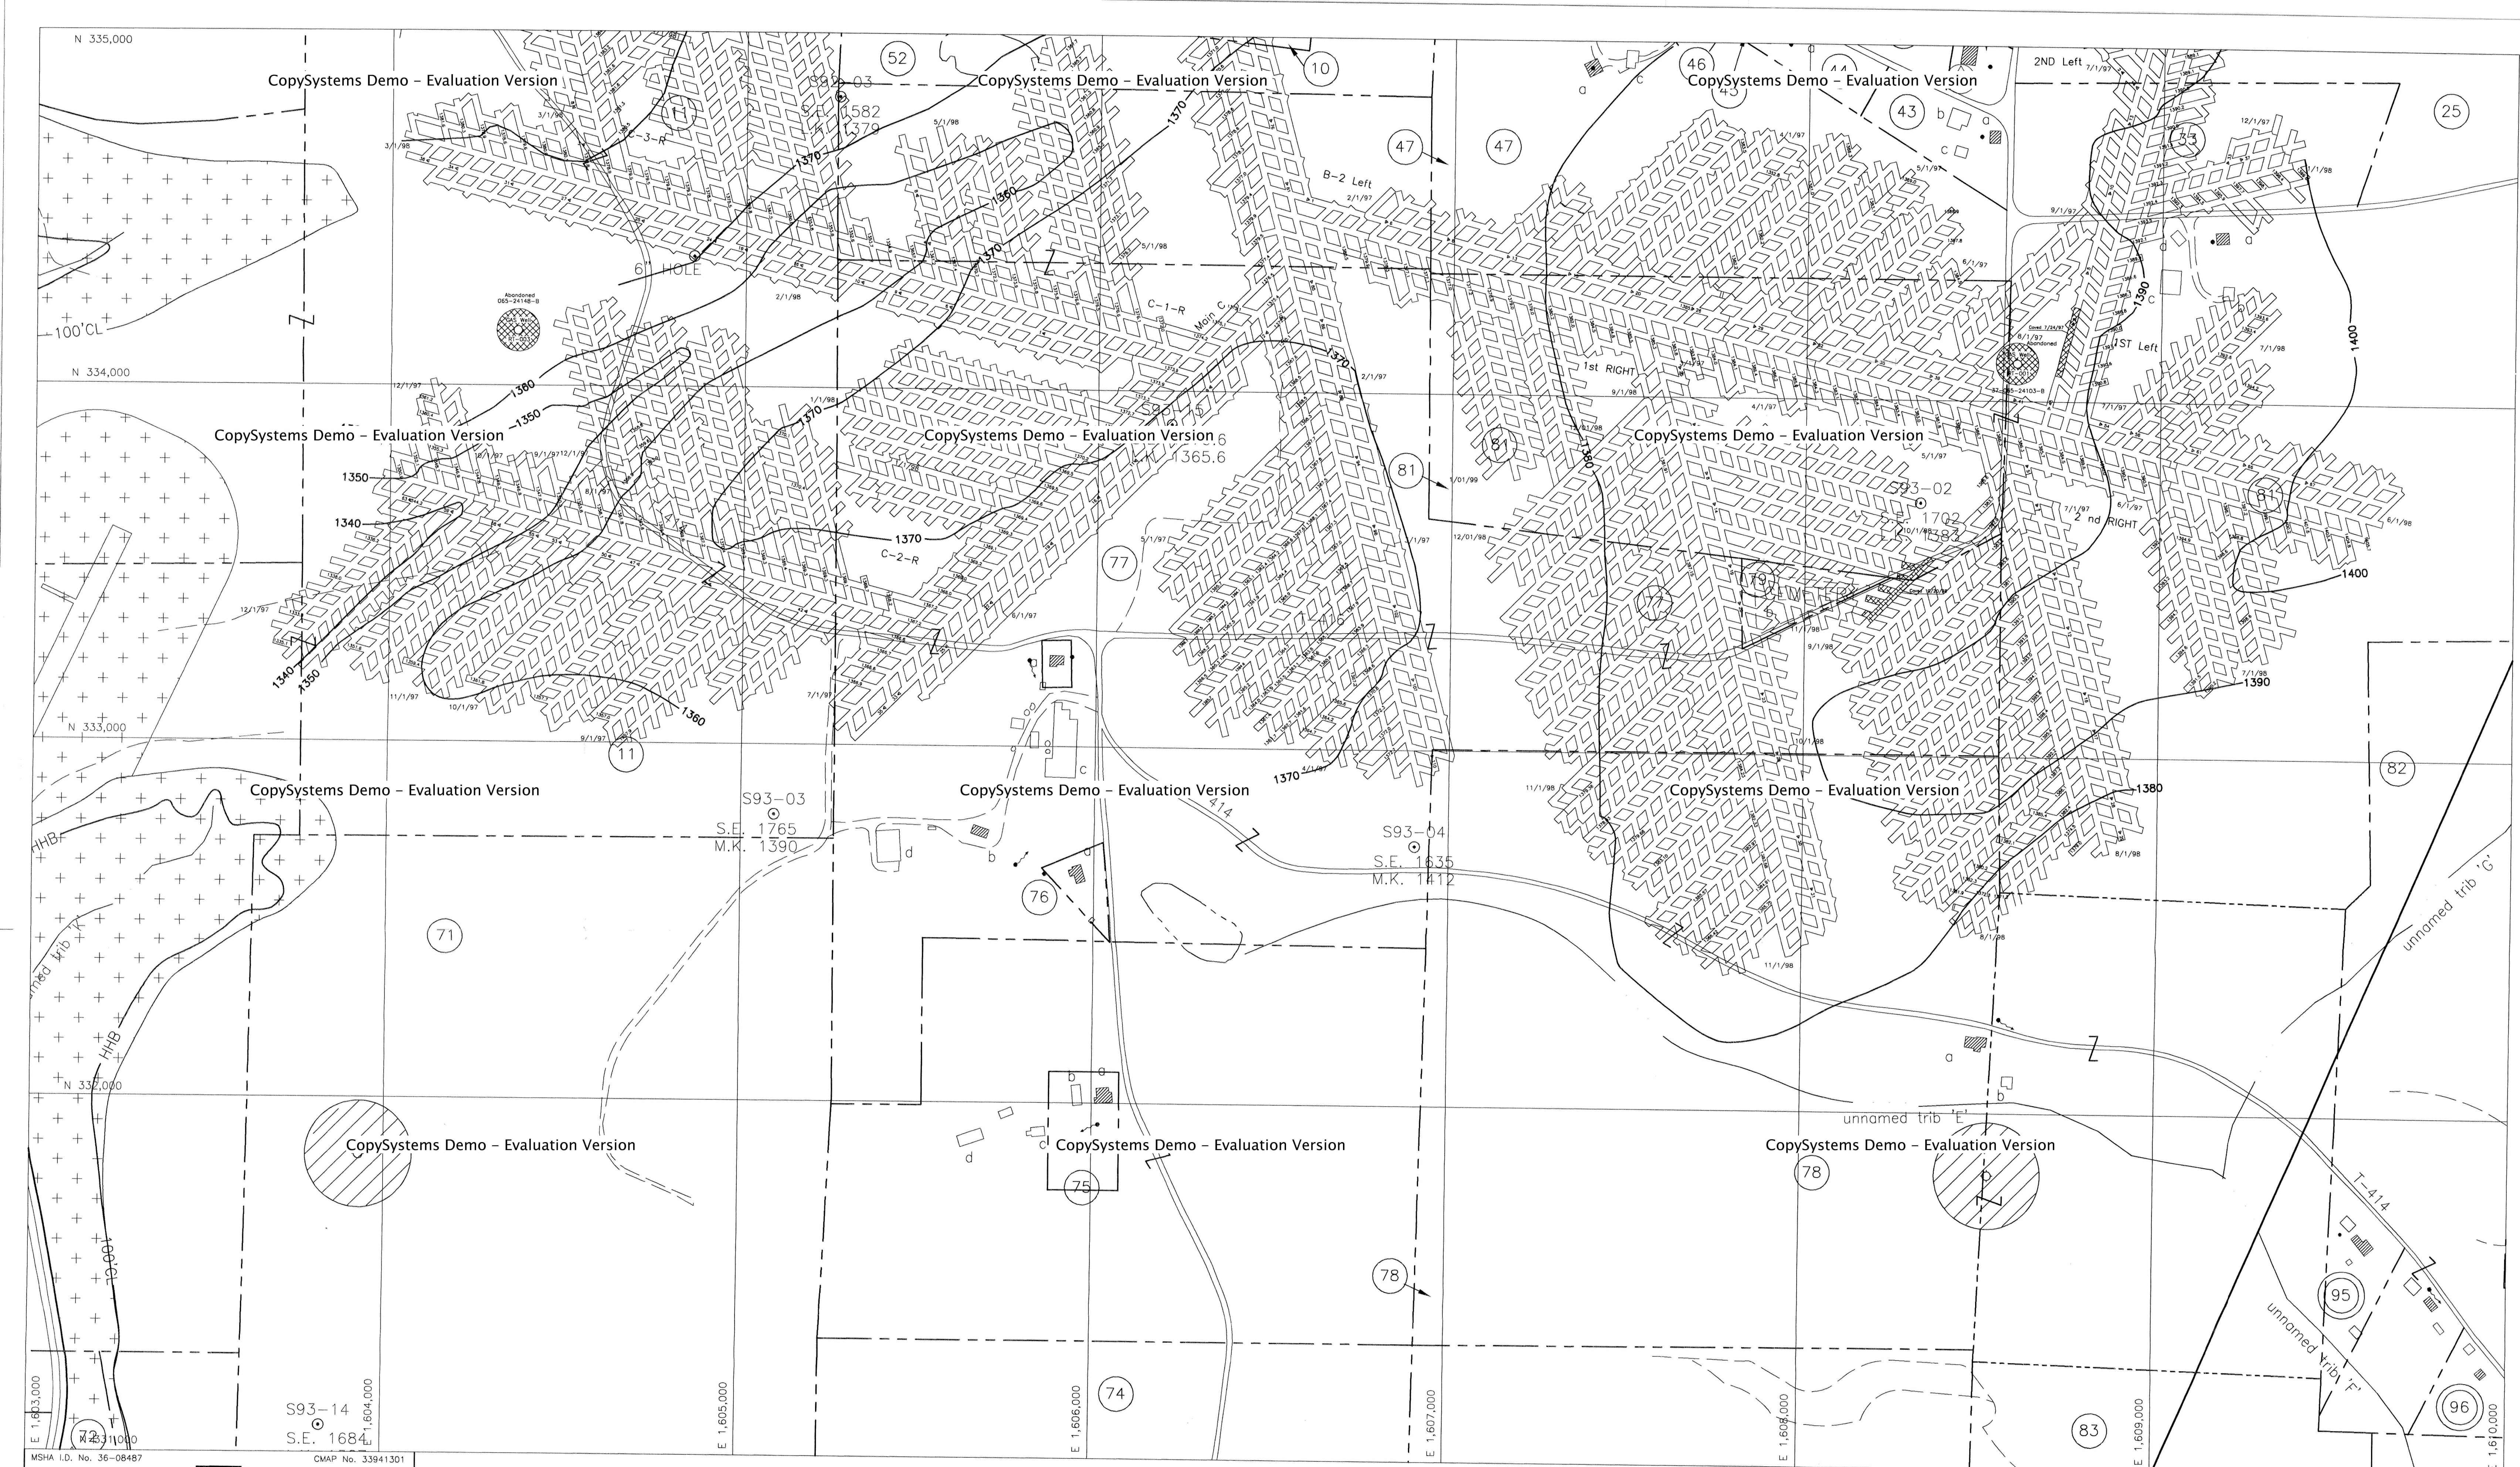

CopySystems Demo – Evaluation Version

- | | | | |
|-----------------|----------------------------------|-----------------|---------------------------|
| (31) | PROPERTY OWNERS | — T — | TELE./ELEC. LINES |
| (9) | CONT. PROPERTY OWNERS | ● | WATER WELL |
| □ ²⁰ | UNOCCUPIED DWELLINGS, STRUCTURES | ○ ²⁰ | SPRING |
| ■ ²⁰ | OCCUPIED DWELLINGS, STRUCTURES | ⊙ | DRILL HOLE |
| (2A) | PROT. ACT 54 STRUCTURES | ▨ | IMPOUNDMENT |
| —LK-1480— | L.K. COAL CONTOURS | ◇ | CEMETERY |
| ▨ | L.K. COAL OUTCROP | —> | MINE OPENINGS, NOT SEALED |

- # CopySystems Demo – Evaluation
-  MINE
 STREAMS
 SURVEY STATION
 SUPPORT AREA (No Second Mining)
 NO MINING AREA
 GAS WELL BARRIER (No Mining Within Barrier Unless Approved)

- | | |
|---|-------------------|
|  | INTAKE AIR |
|  | RETURN AIR |
|  | BELT LINE |
|  | CHECK CURTAIN |
|  | REGULATOR |
|  | DOUBLE DOORS |
|  | RUN-THROUGH CHECK |
|  | OVERCAST |
|  | STOPPING |
|  | STOPPING W/ DOOR |

CopySystems Demo – Evaluation Version 3 1:10000


INDIVIDUALS RESPONSIBLE FOR INFORMATION:

CHARLES ISHMAN, ENGINEER & DONALD ISHMAN, SUPERINTENDENT

MAP FULFILLS REQUIREMENTS OF 75.372 & 75.1200

ADJACENT MINE WORKINGS WITHIN 1000 FEET

NO MINE WORKINGS BELOW MINE PROPERTY

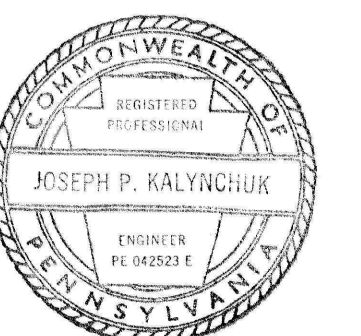

SIGNATURE _____

DATE 4-14-99

Final Mine Map