


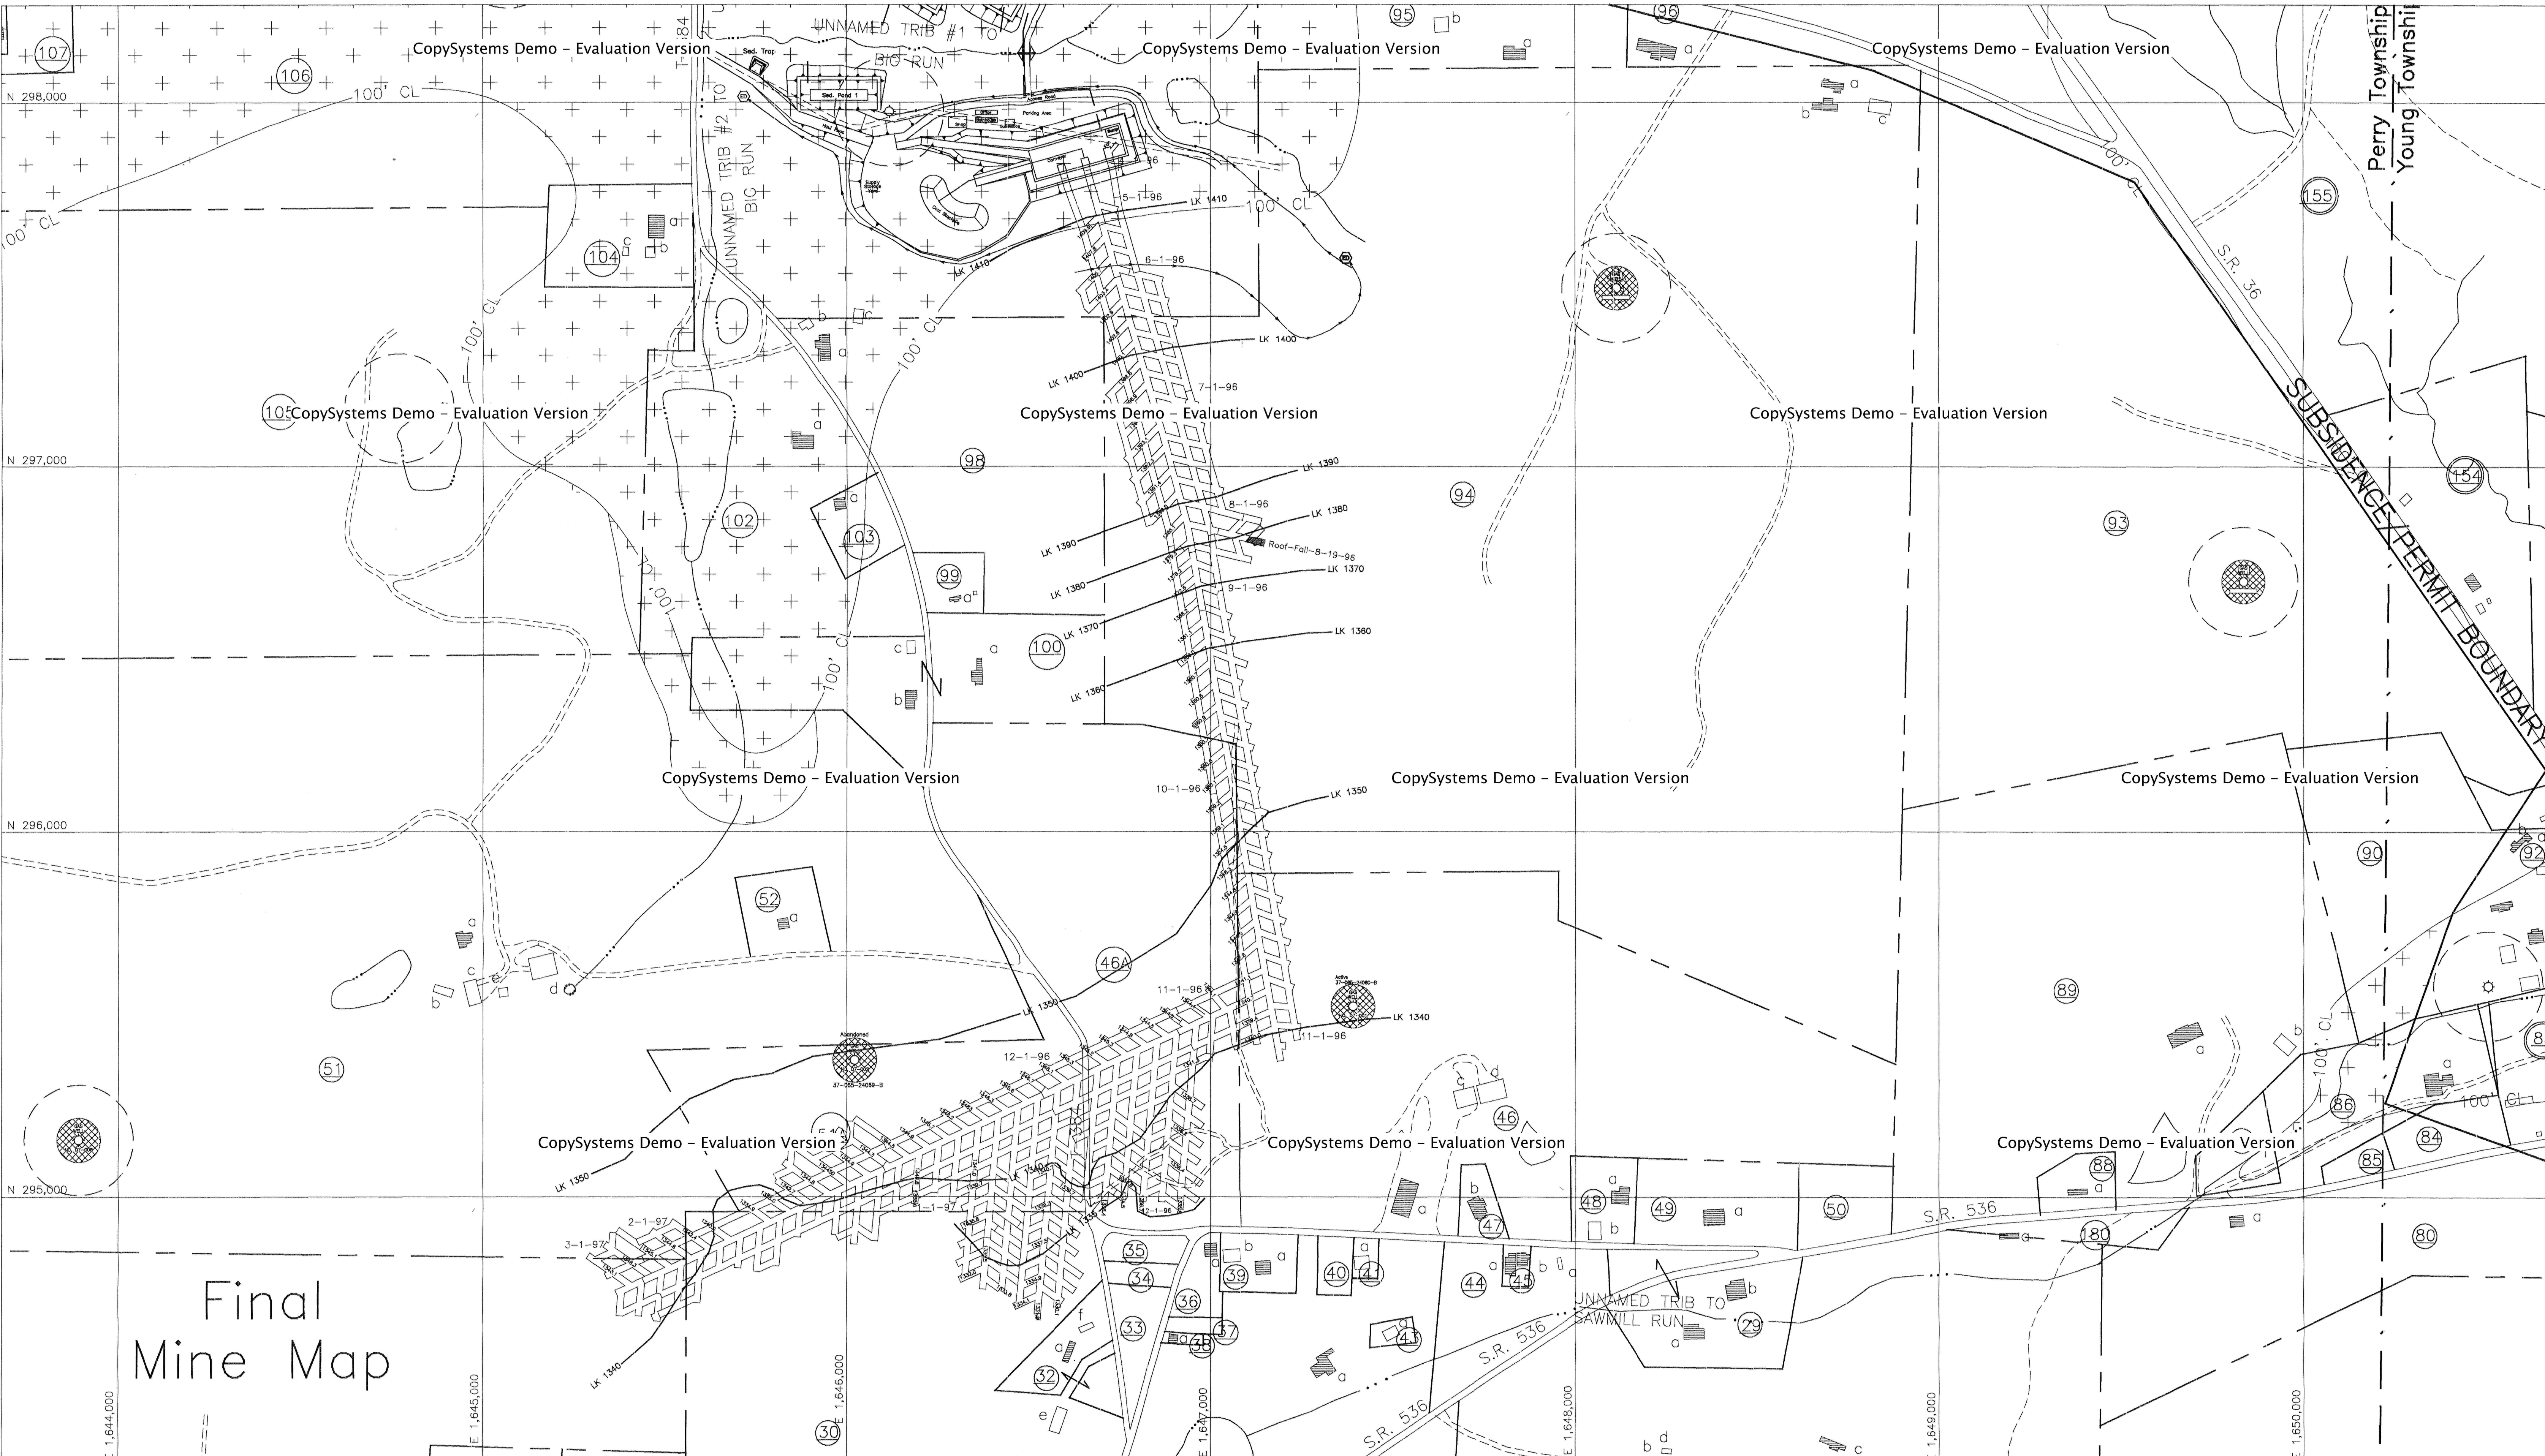

Final Mine Map

OMAP No. 33951301

**CopySystems Demo - Evaluation Version**

Doverspike Bros. Coal Co.
R.D. #4, Box 271, Punxsutawney, PA 15767
Perry & Young Twp., Jefferson County

DORA #7 MINE

SCALE: 1" = 200'

SHEET 1 of 1

MODULE 19.5

RECEIVED
JUL 24 1998
Dept. of Environmental Protection
Mining District Office

31

9

28

24

PERMIT AREA

PROPERTY LINES

PROPERTY OWNERS

CONT. PROPERTY OWNERS

STREAMS

DWELLINGS, STRUCTURES

PROT. ACT 54 STRUCTURES

L.K. COAL CONTOURS

⊙

—T L—

⊙

GAS LINE

GAS WELL

TELE./ELEC. LINES

GAS WELL BARRIER (No Mining Within Barrier Unless Approved)

CopySystems Demo - Evaluation Version

CopySystems Demo - Evaluation Version

CopySystems Demo - Evaluation Version

CopySystems Demo - Evaluation Version

CopySystems Demo - Evaluation Version

CopySystems Demo - Evaluation Version

CopySystems Demo - Evaluation Version


CopySystems Demo - Evaluation Version

CopySystems Demo - Evaluation Version

CopySystems Demo - Evaluation Version

CopySystems Demo - Evaluation Version

CopySystems Demo - Evaluation Version

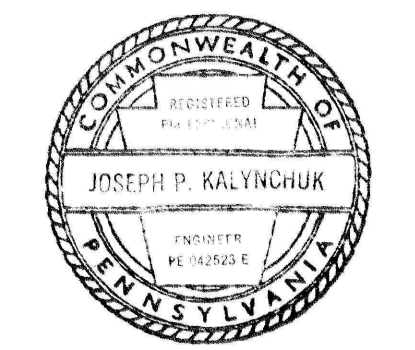
JOSEPH P. KALYNCHUK
PENNSYLVANIA

SIGNATURE: *Joseph P. Kalynchuk*

DATE: 7-24-98