DEEP MINE SAFETY 100

0 25 50 100 150 200 Feet

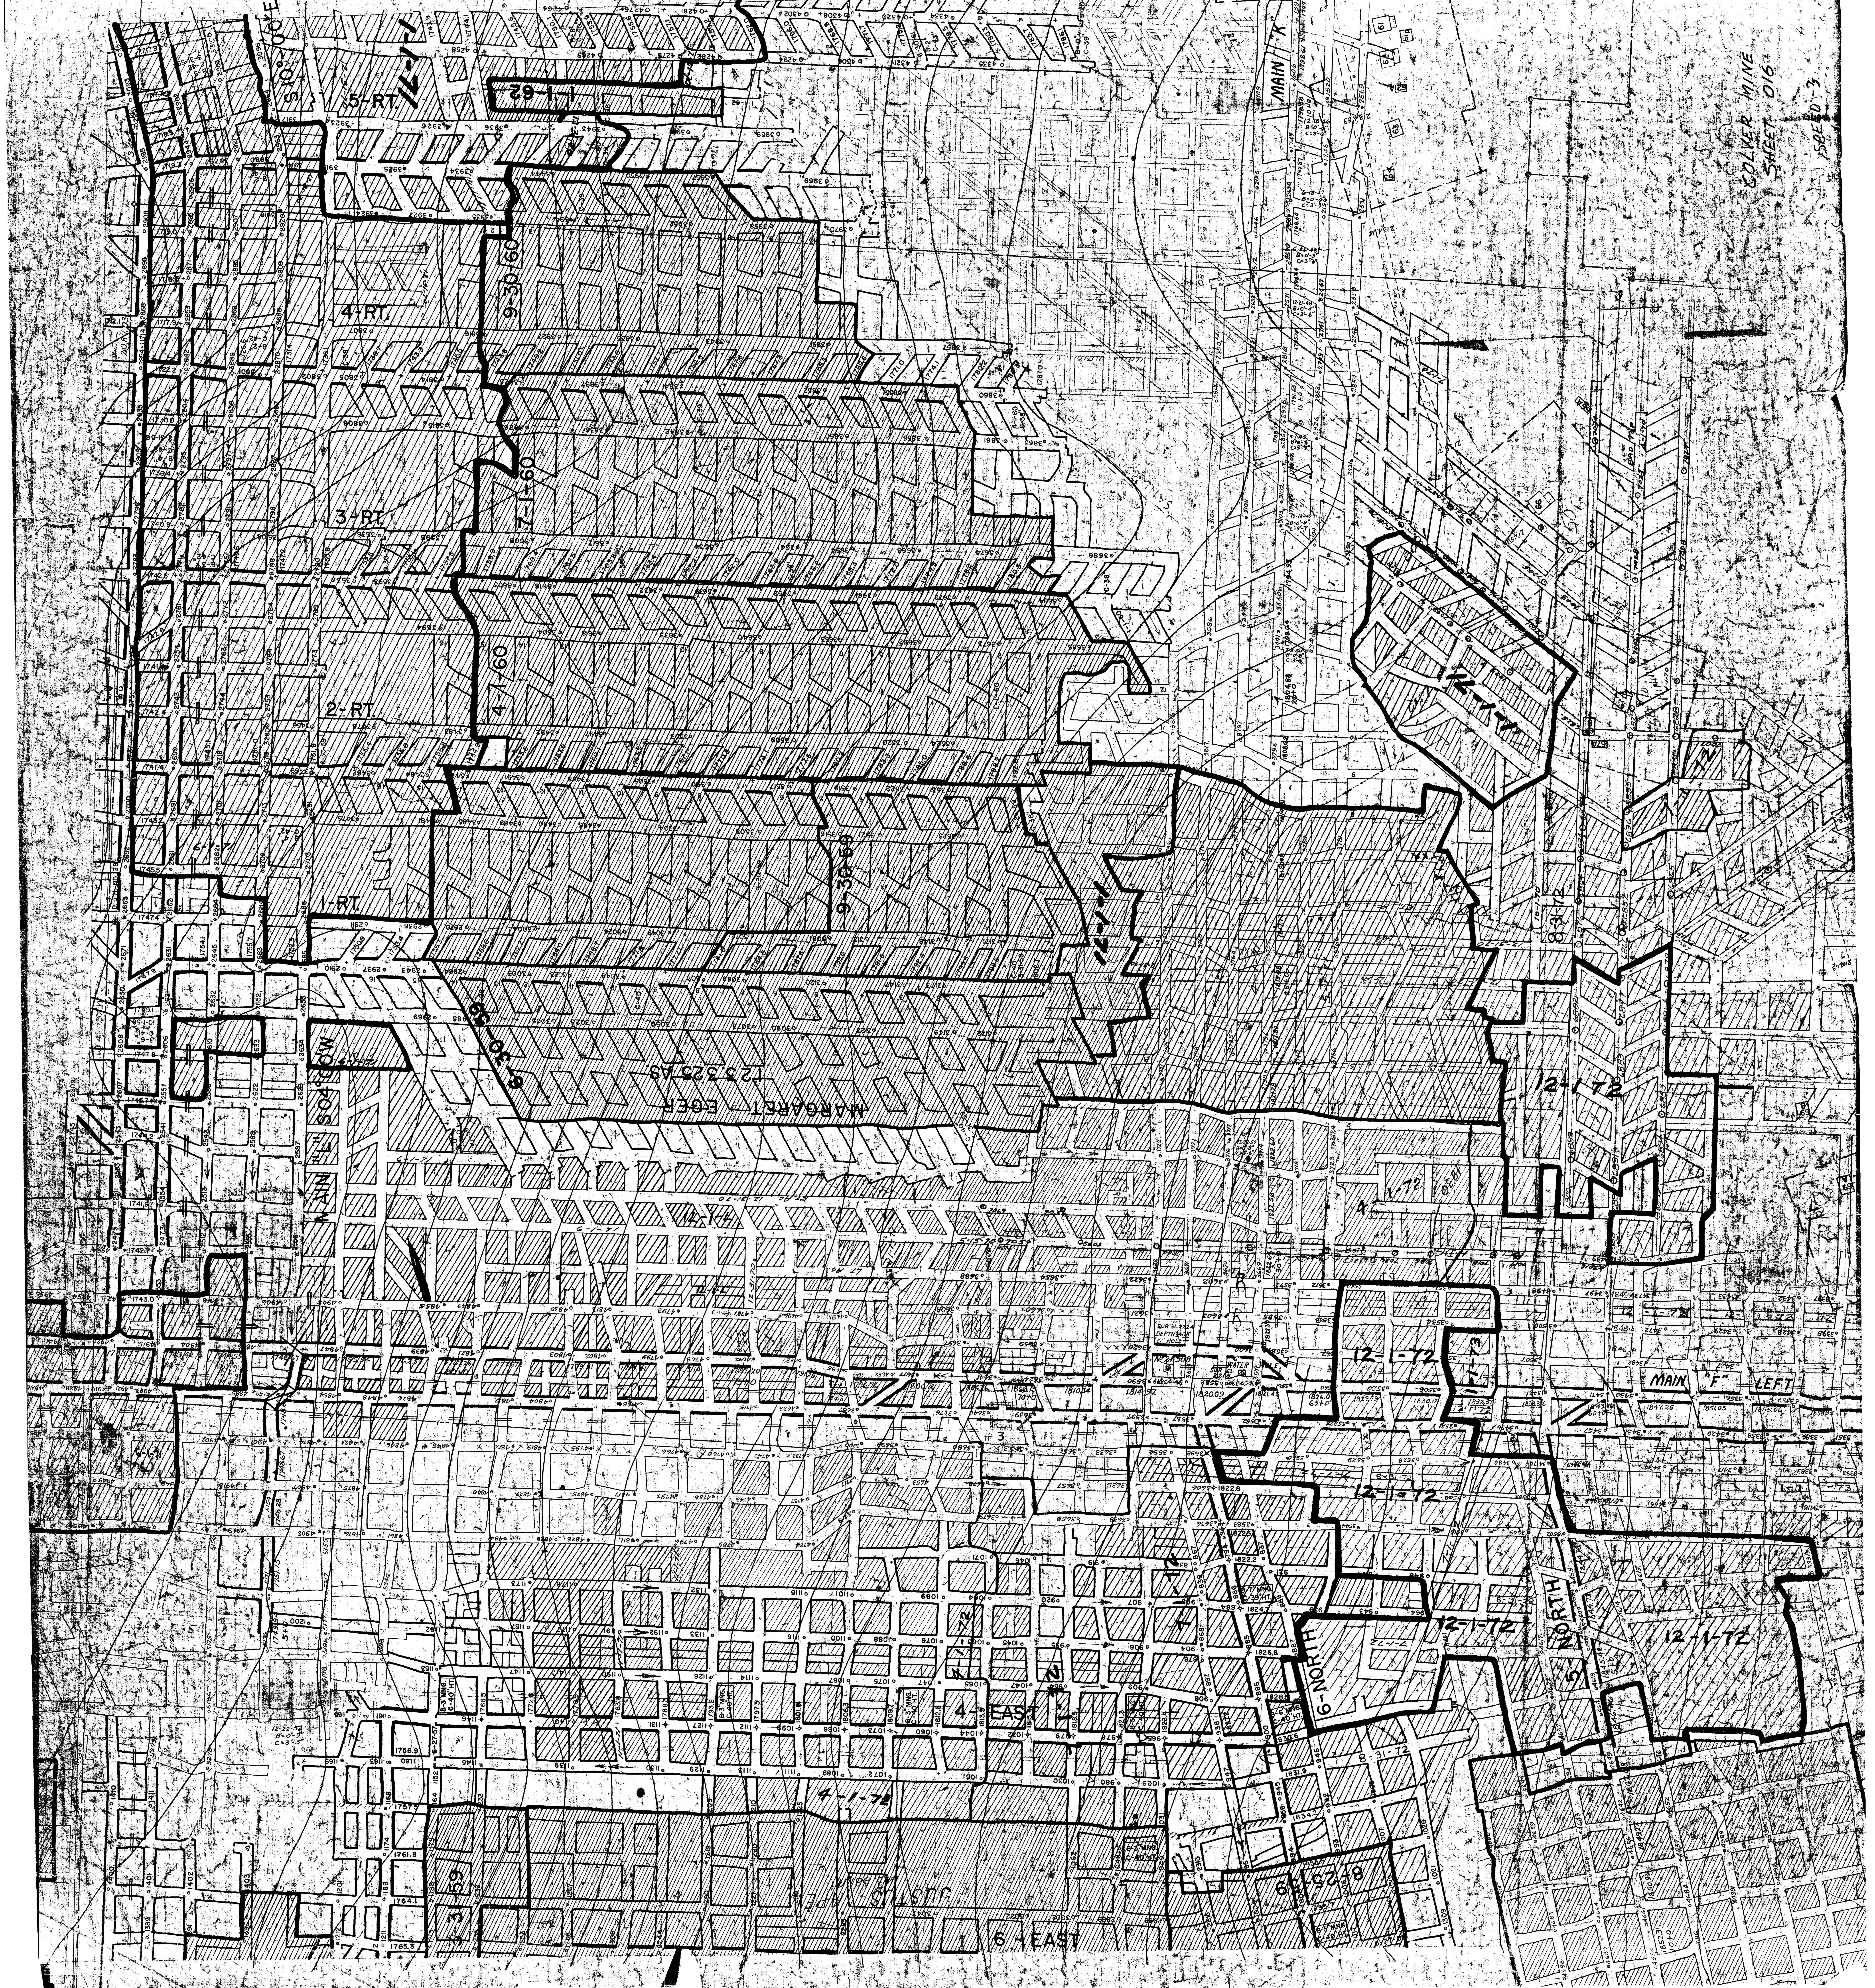
COLVER MINE
SHEET 016
SPEED-3
MAIN "K" LEFT
MAIN "F" LEFT
MAIN "L" SO4°00'W
S 10° 00' E
5-RT.
4-RT.
3-RT.
2-RT.
1-RT.
1-1-62
1-1-71
9-30-60
7-1-60
4-1-60
9-30-59
6-30-59
12-1-71
12-1-72
12-1-73
1-1-73
8-31-72
4-1-72
MARGARET EGER
123.325 AS
JUSTUS APE
6-NORTH
5-NORTH
4-EAST
6-EAST
8-25-69
3-3-59
SUR EL. 2224
DEPTH 1408
6" HOLE
No 21 SOB
WATER HOLE
B-3" MNG.
C-40" HT.
6-1-71
12-31-70
5-15-70
10-1-58
12-22-58
6-27-57