


SHEET 7-O-17
SHEET 3

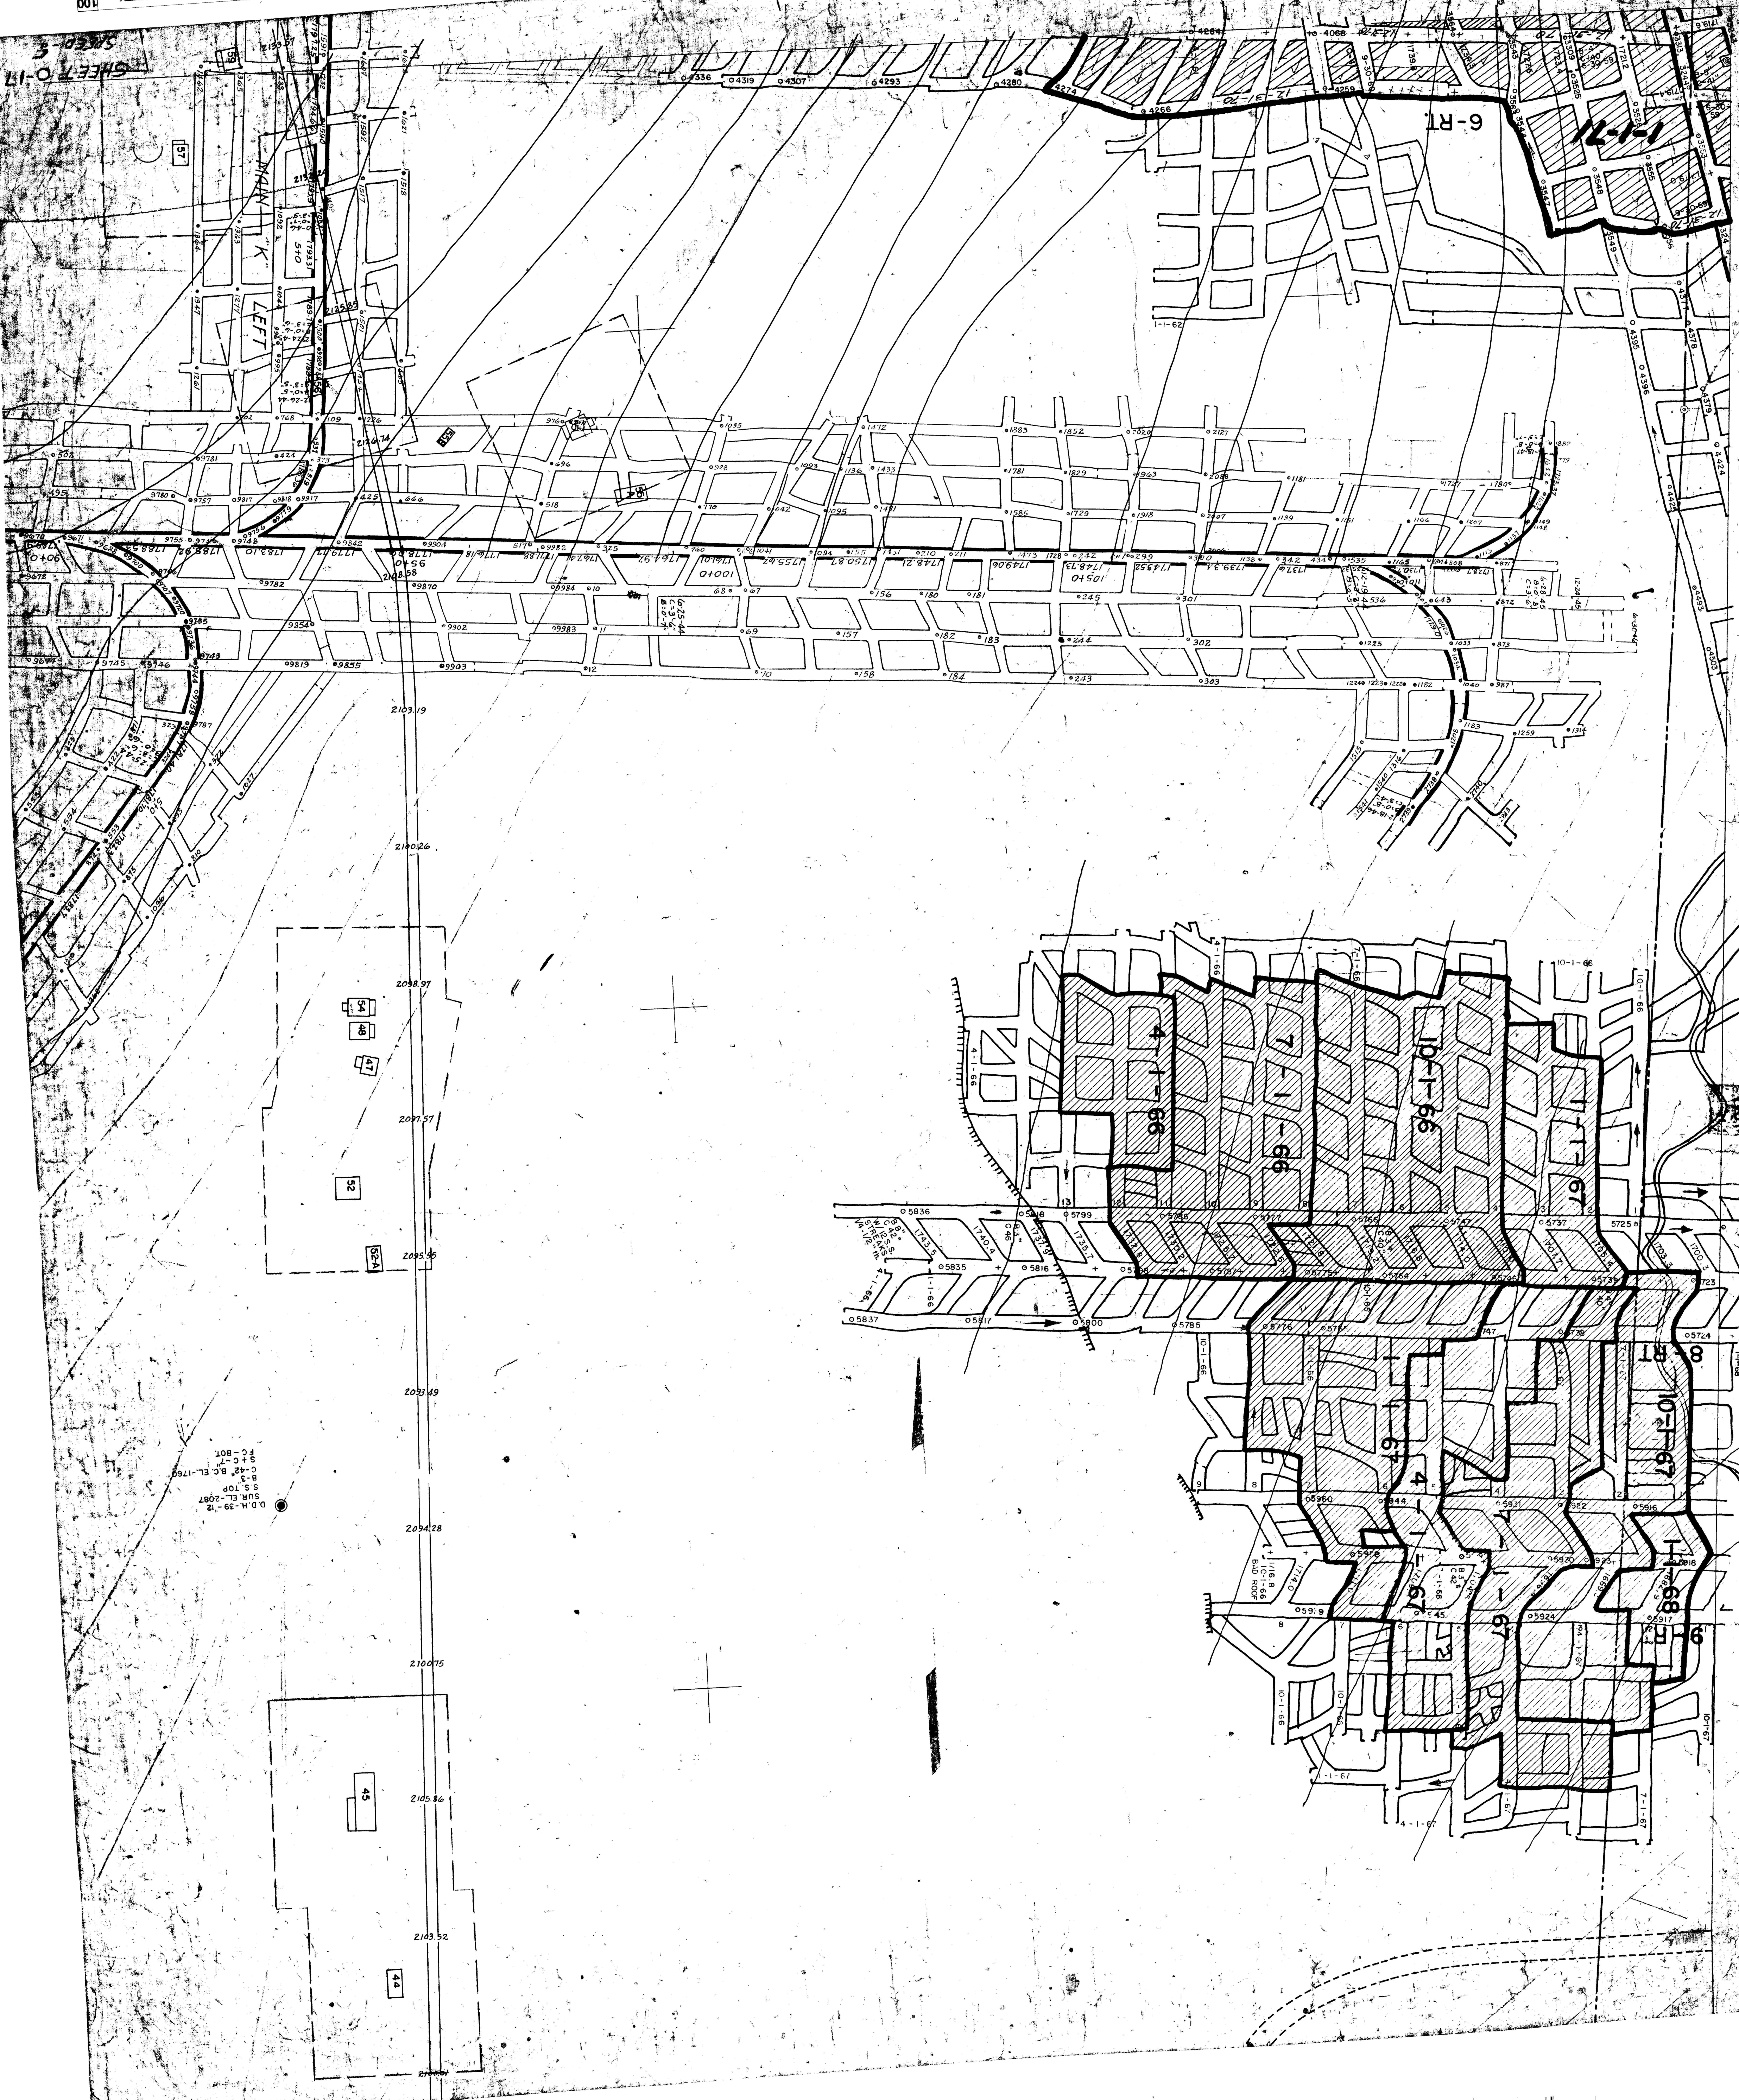

D.M. 39-12
SUR. EL. 2087
B.S. TOP
B-3
C-42 B.C. EL. 1760
S.C-7
F.C-BOT