




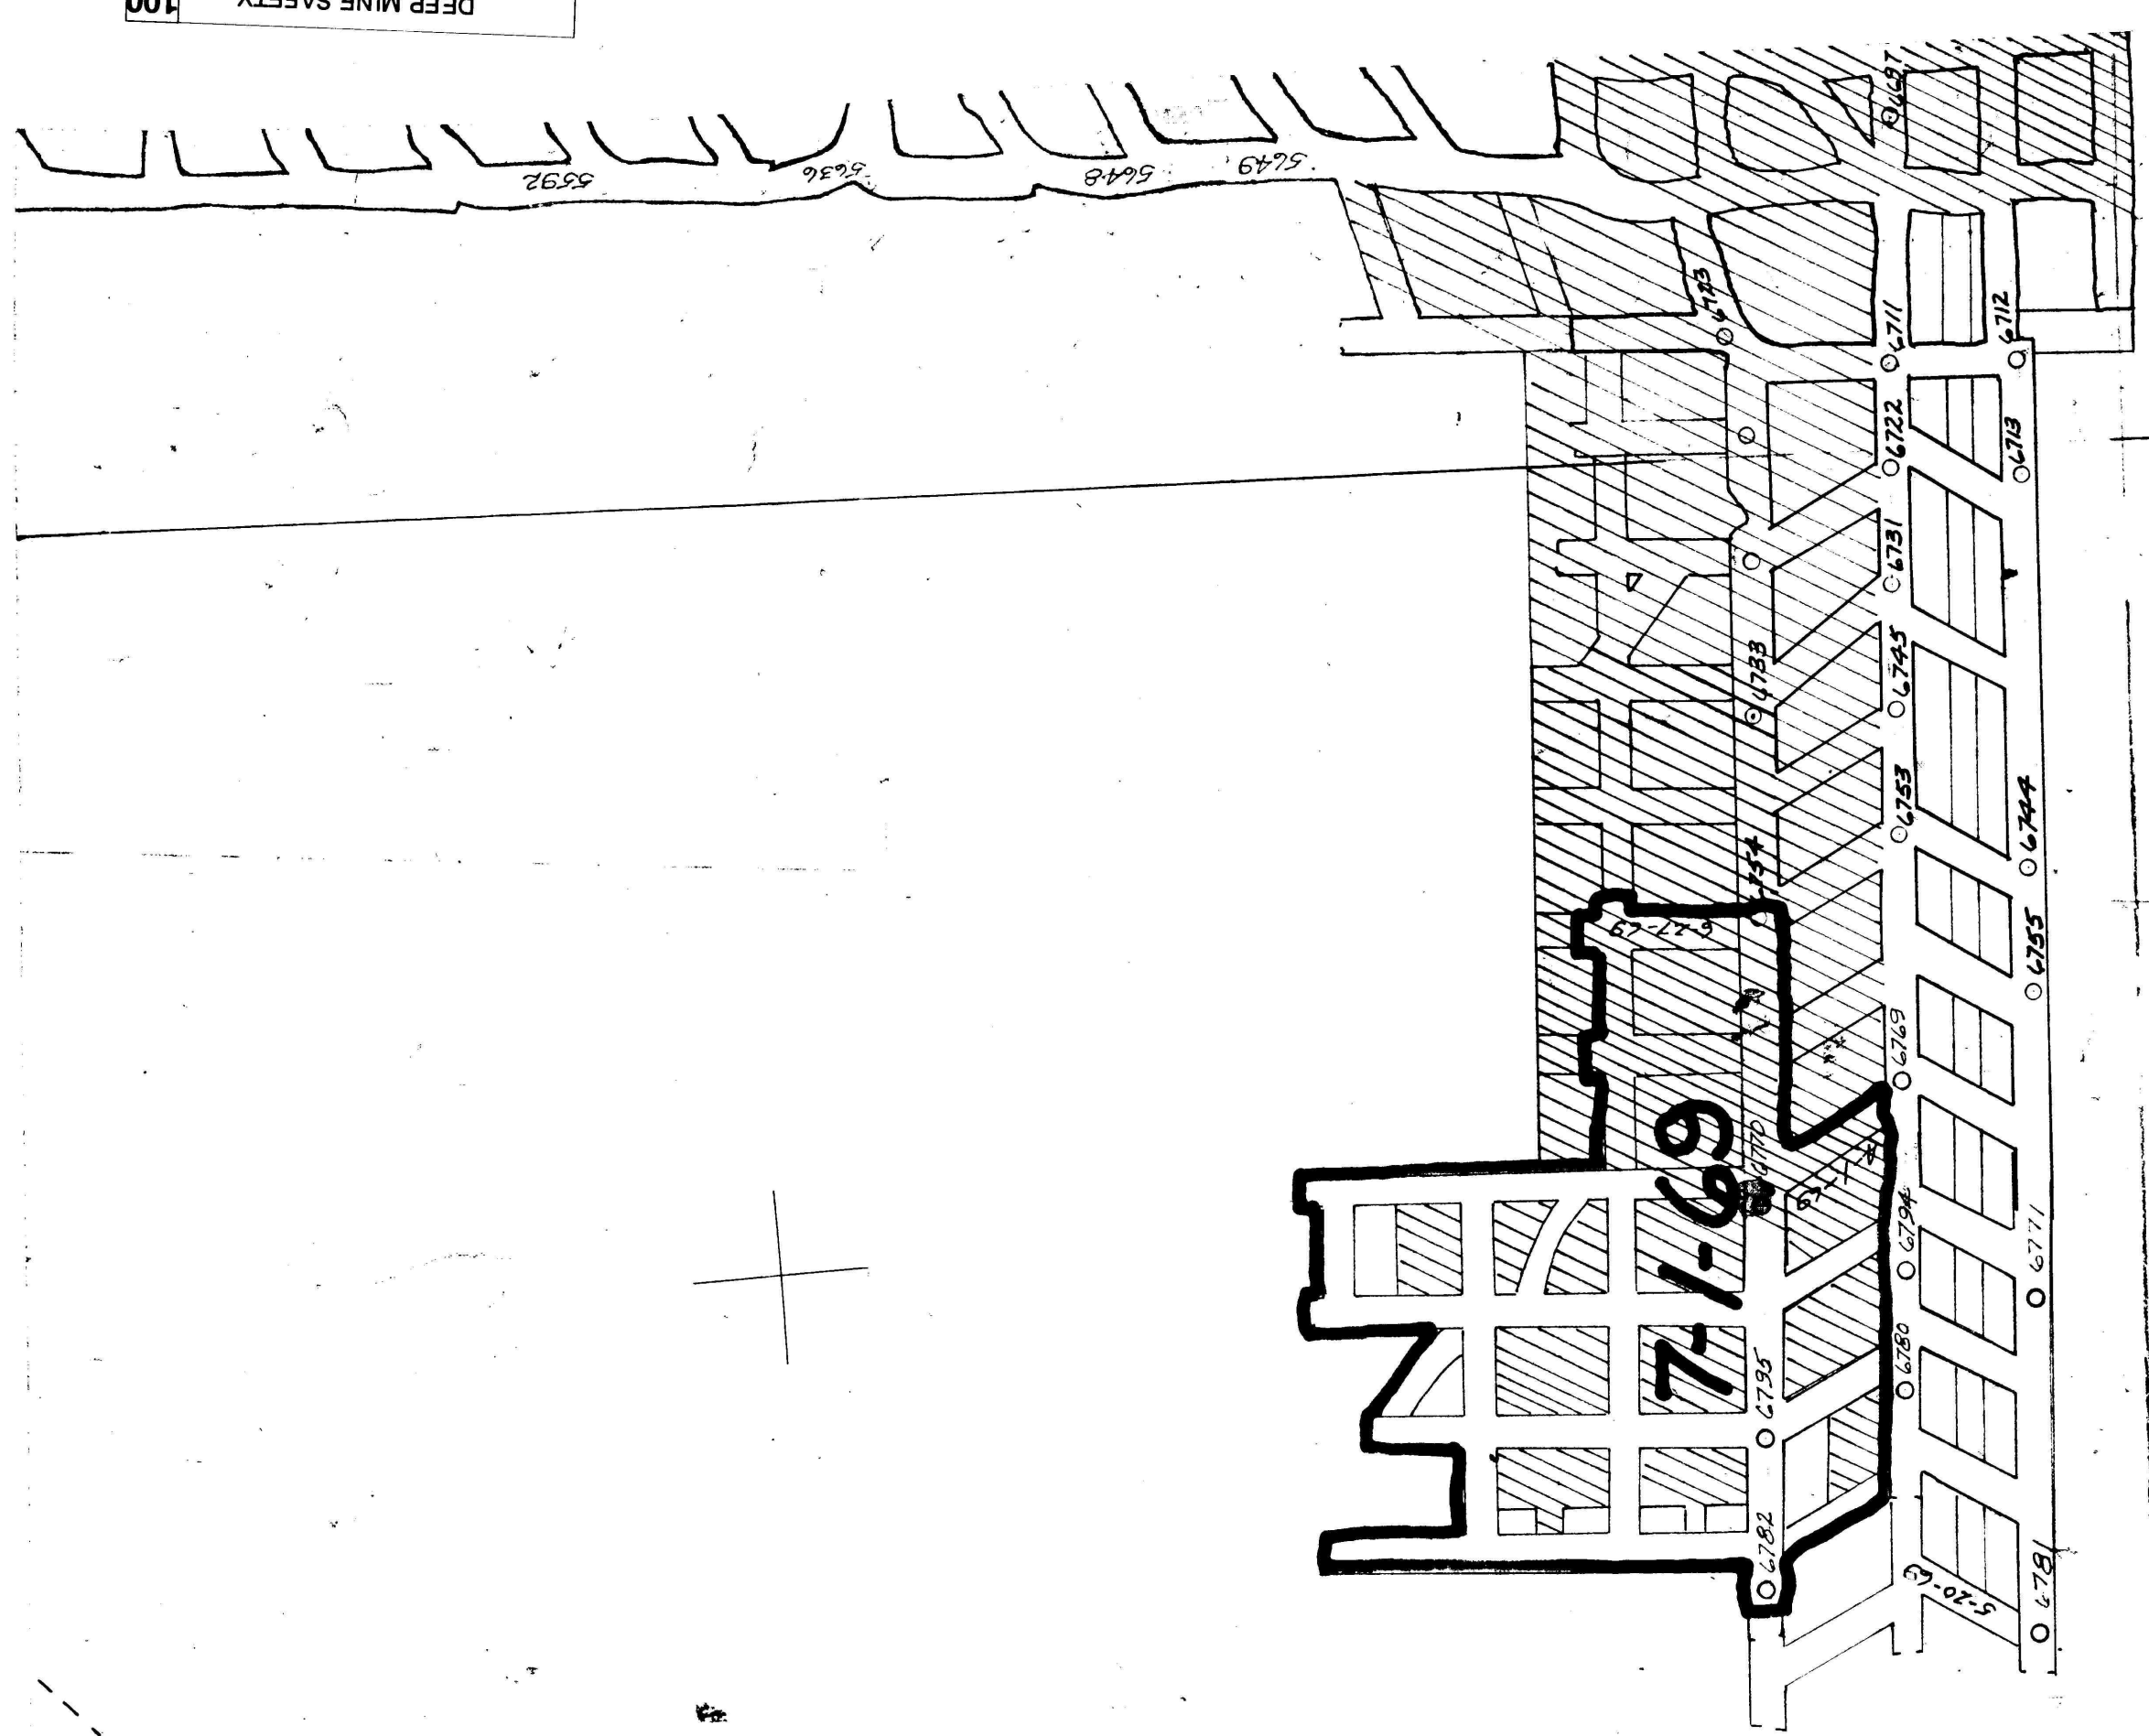

LDH-34.41
S-1-38.1 EC E11635
S-1-38.1 EC E11635
FC, Bct

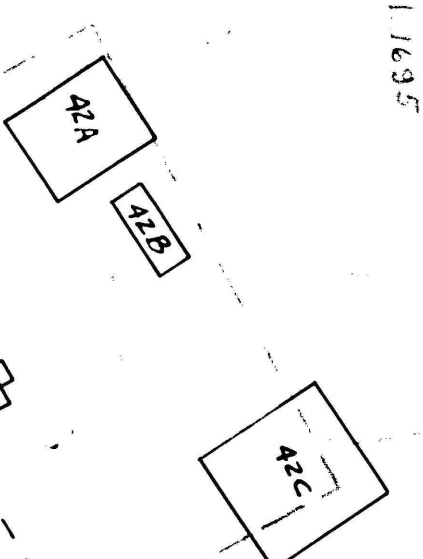

43

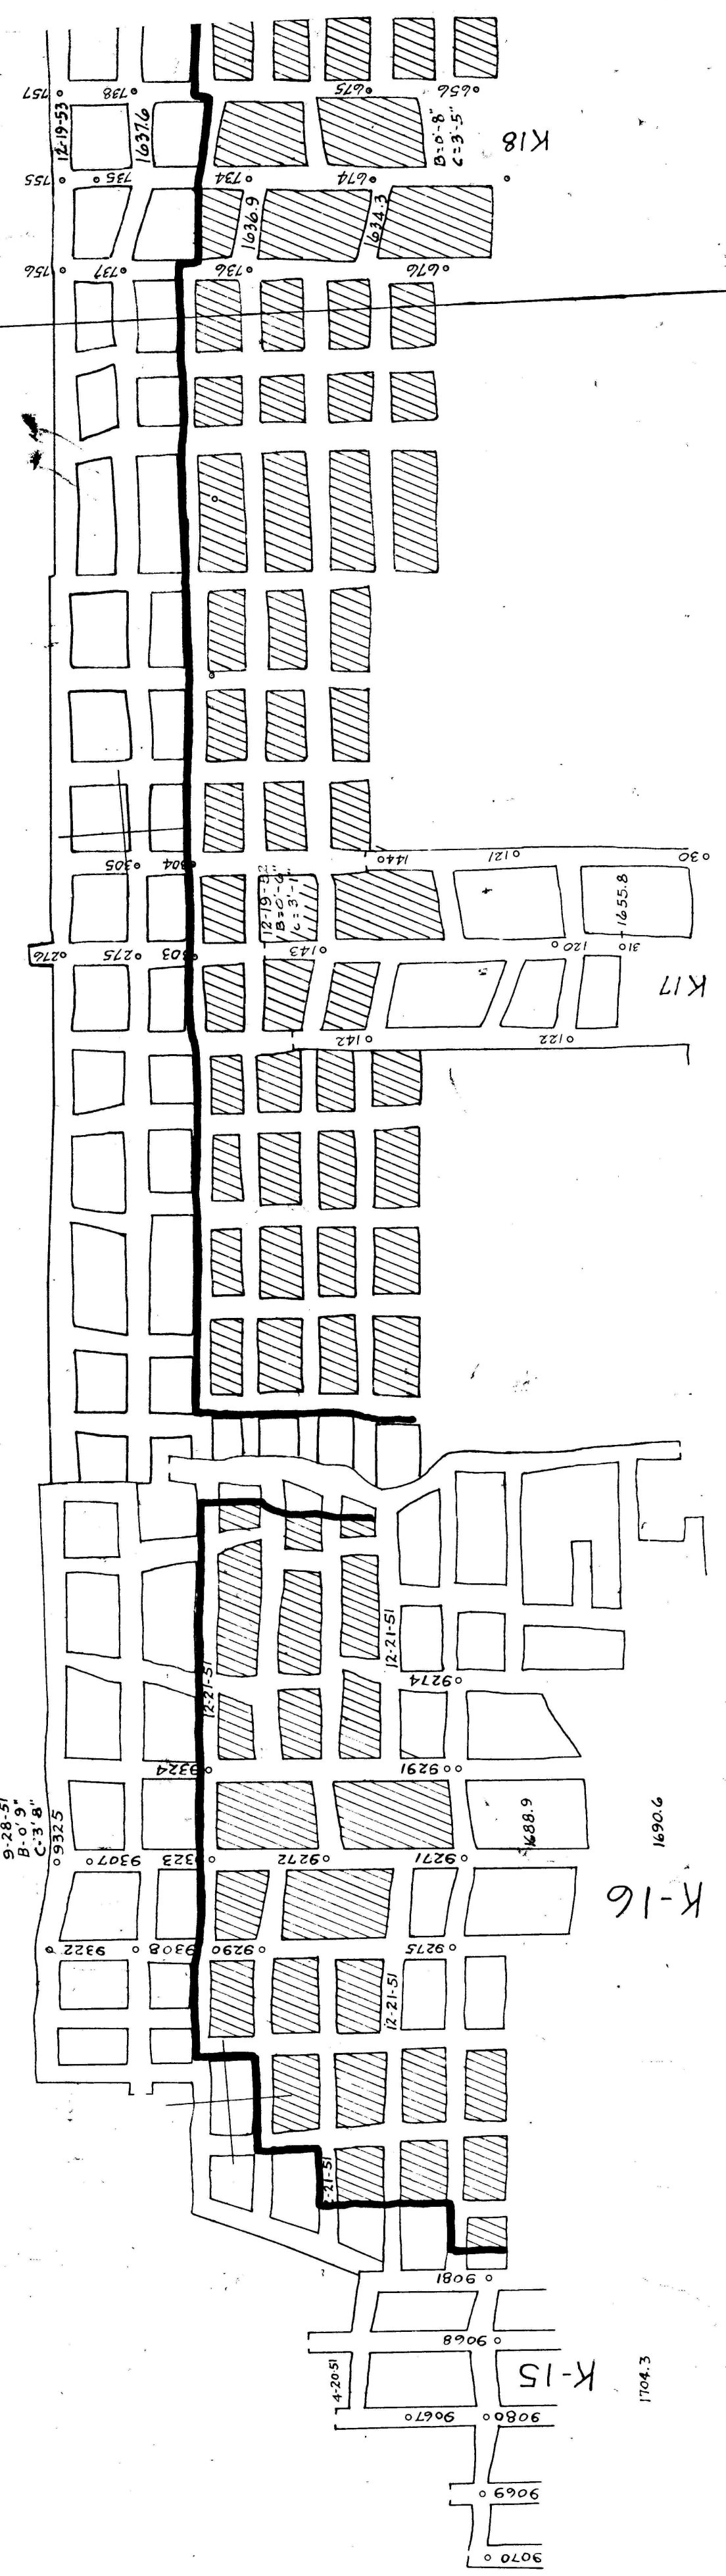

K-16

K-15