COLVER MINE
B SEAM
SHEET-04
LOWER KITTANNING
SPEED-10

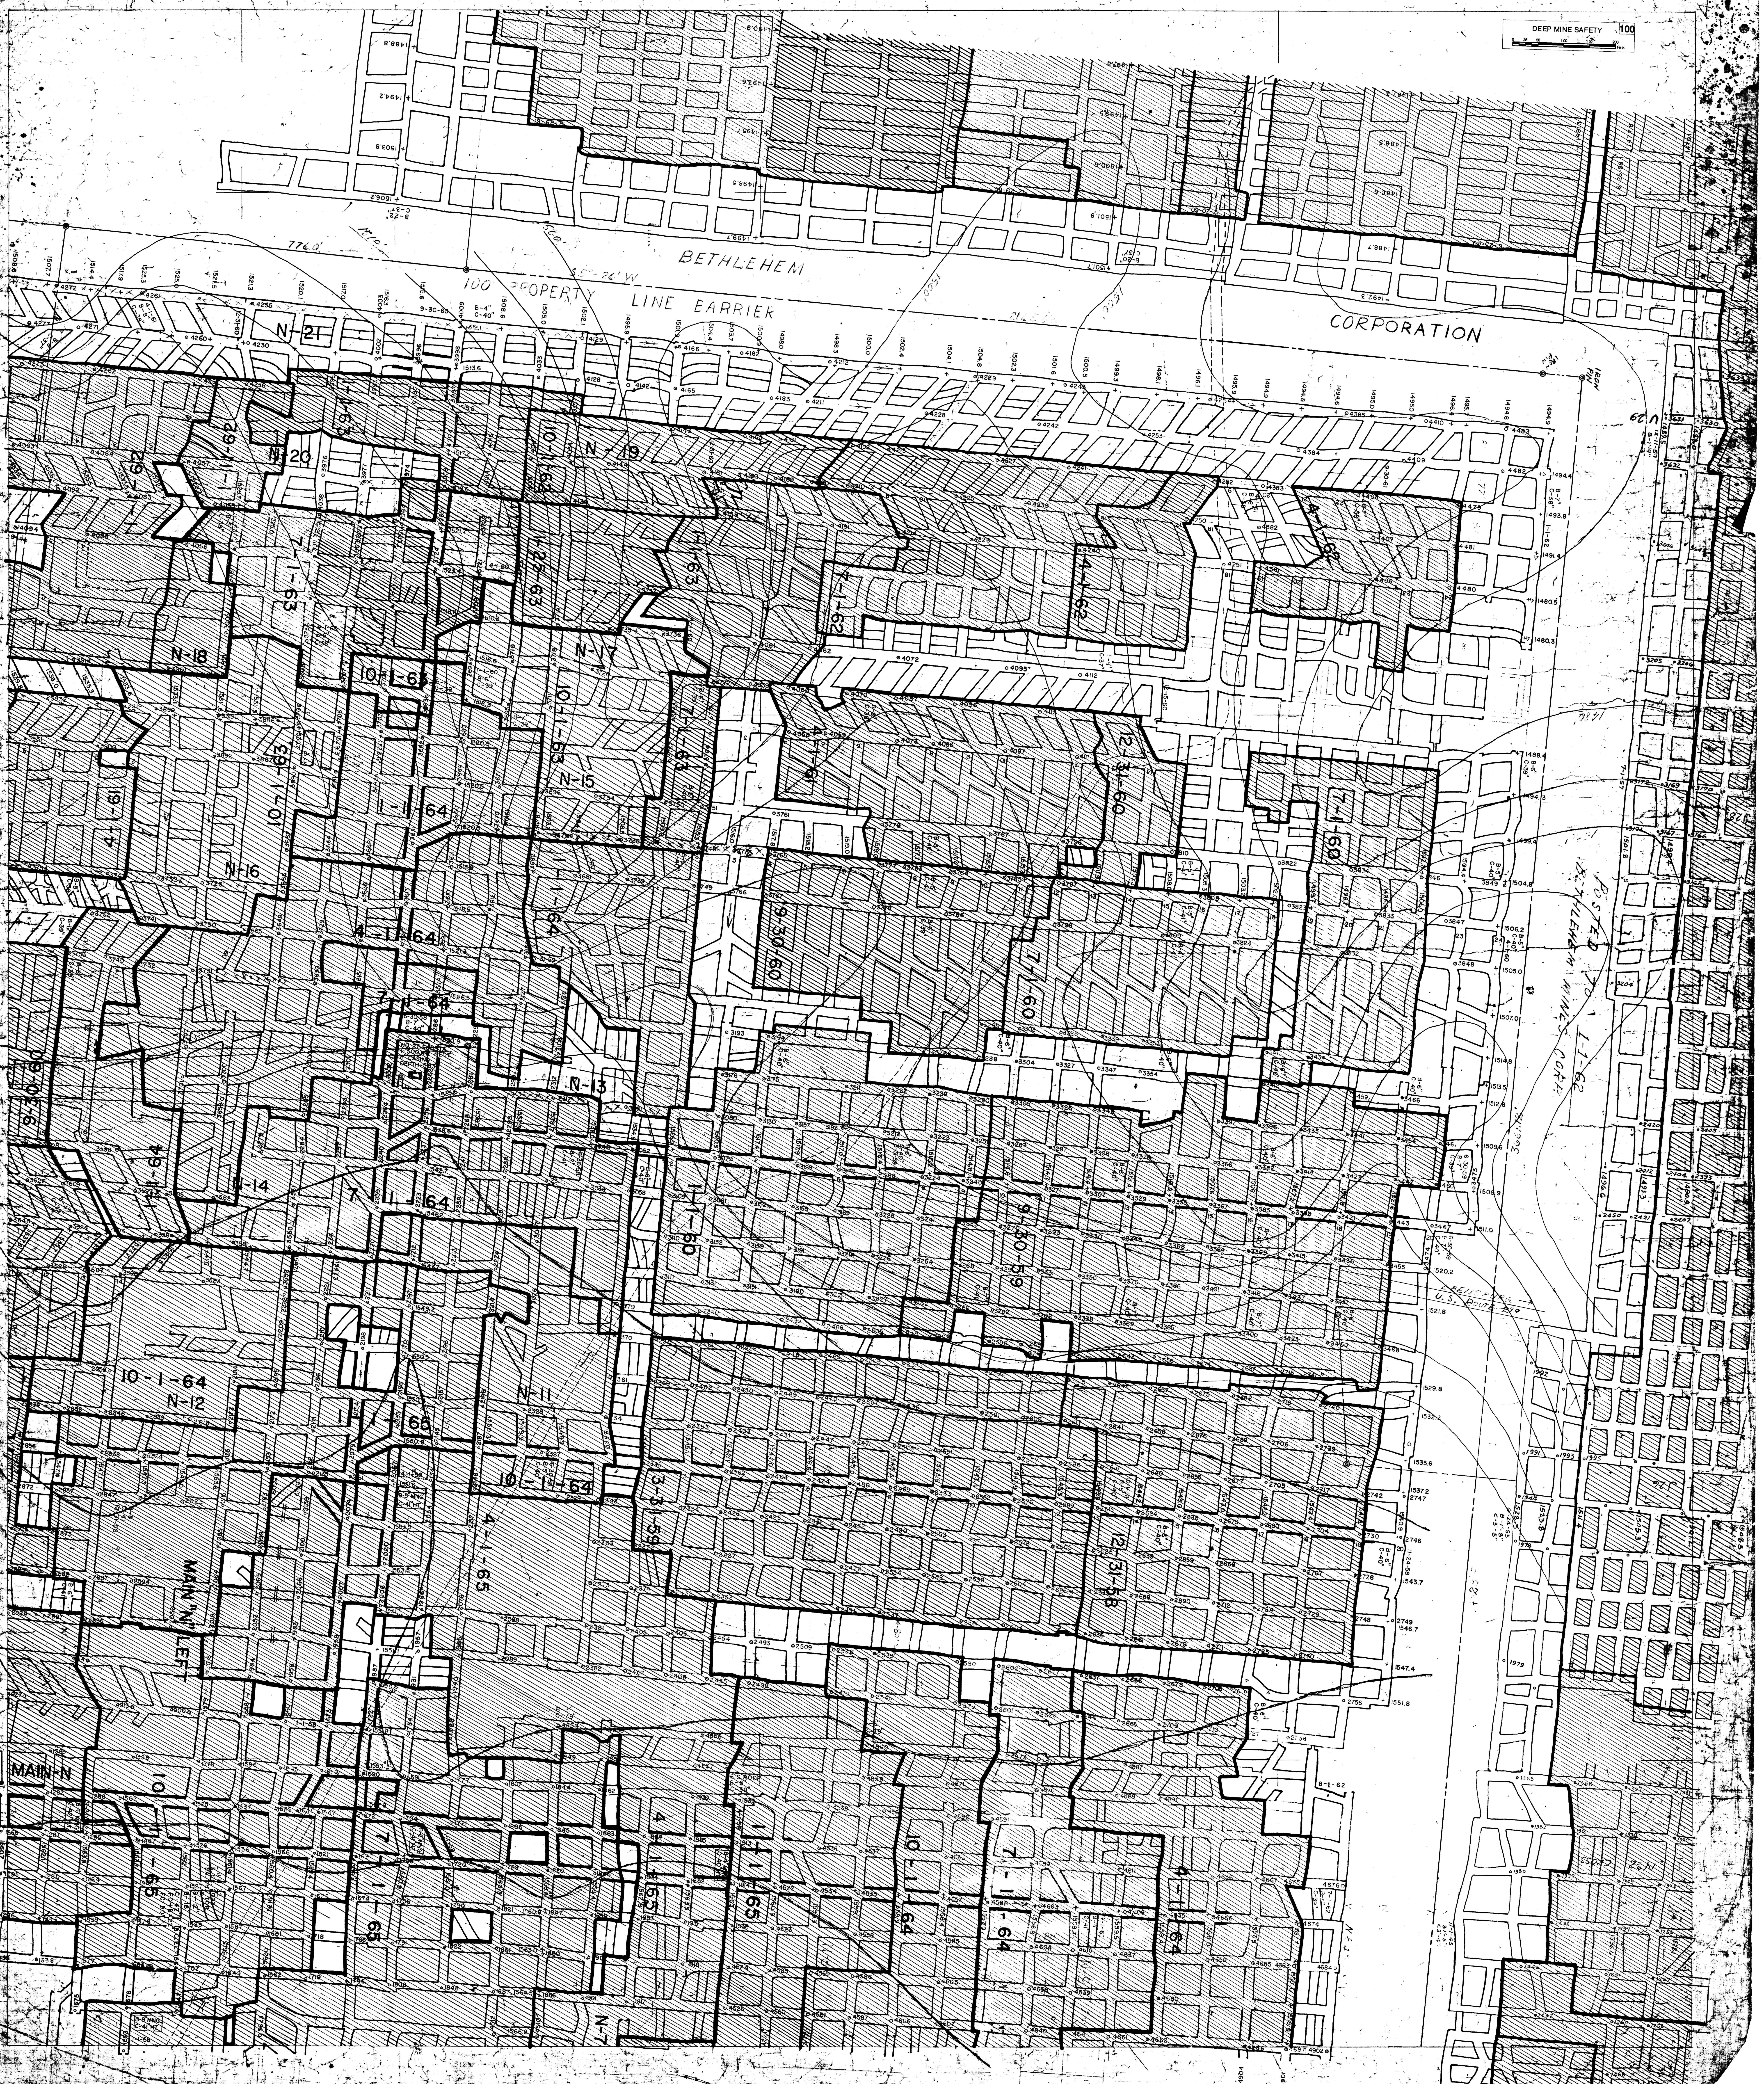
DEEP MINE SAFETY 100
0 25 50 100 150 200 Feet
BETHLEHEM
100 PROPERTY LINE BARRIER
CORPORATION
776.0'
IRON PIN
N-21
N-20
N-19
N-18
N-17
N-16
N-15
N-14
N-13
N-12
N-11
N-7
MAIN-N
MAIN "N" LEFT
N-22 CROSS
10-1-62
7-1-62
4-1-62
1-1-62
1-1-63
7-1-63
10-1-63
1-25-63
10-1-63
4-1-64
1-1-64
7-1-64
10-1-64
1-1-65
4-1-65
7-1-65
9-30-60
7-1-60
1-1-60
12-31-60
4-1-61
9-30-59
3-31-59
12-31-58
12-29-60
12-20-60
6-25-60
6-25-58
12-15-60
9-30-61
8-1-62
POSTED TO BETHLEHEM MINES CORP. 1-1-62
EBENSBURG
U.S. ROUTE 219
NO. 27 SUBSIDENCE
DEPTH
B-8 MNG.
C-41 HT.
1-1-58
6-30-58
B-7"
C-40"