DEEP MINE SAFETY 100

0 25 50 100 150 200 Feet

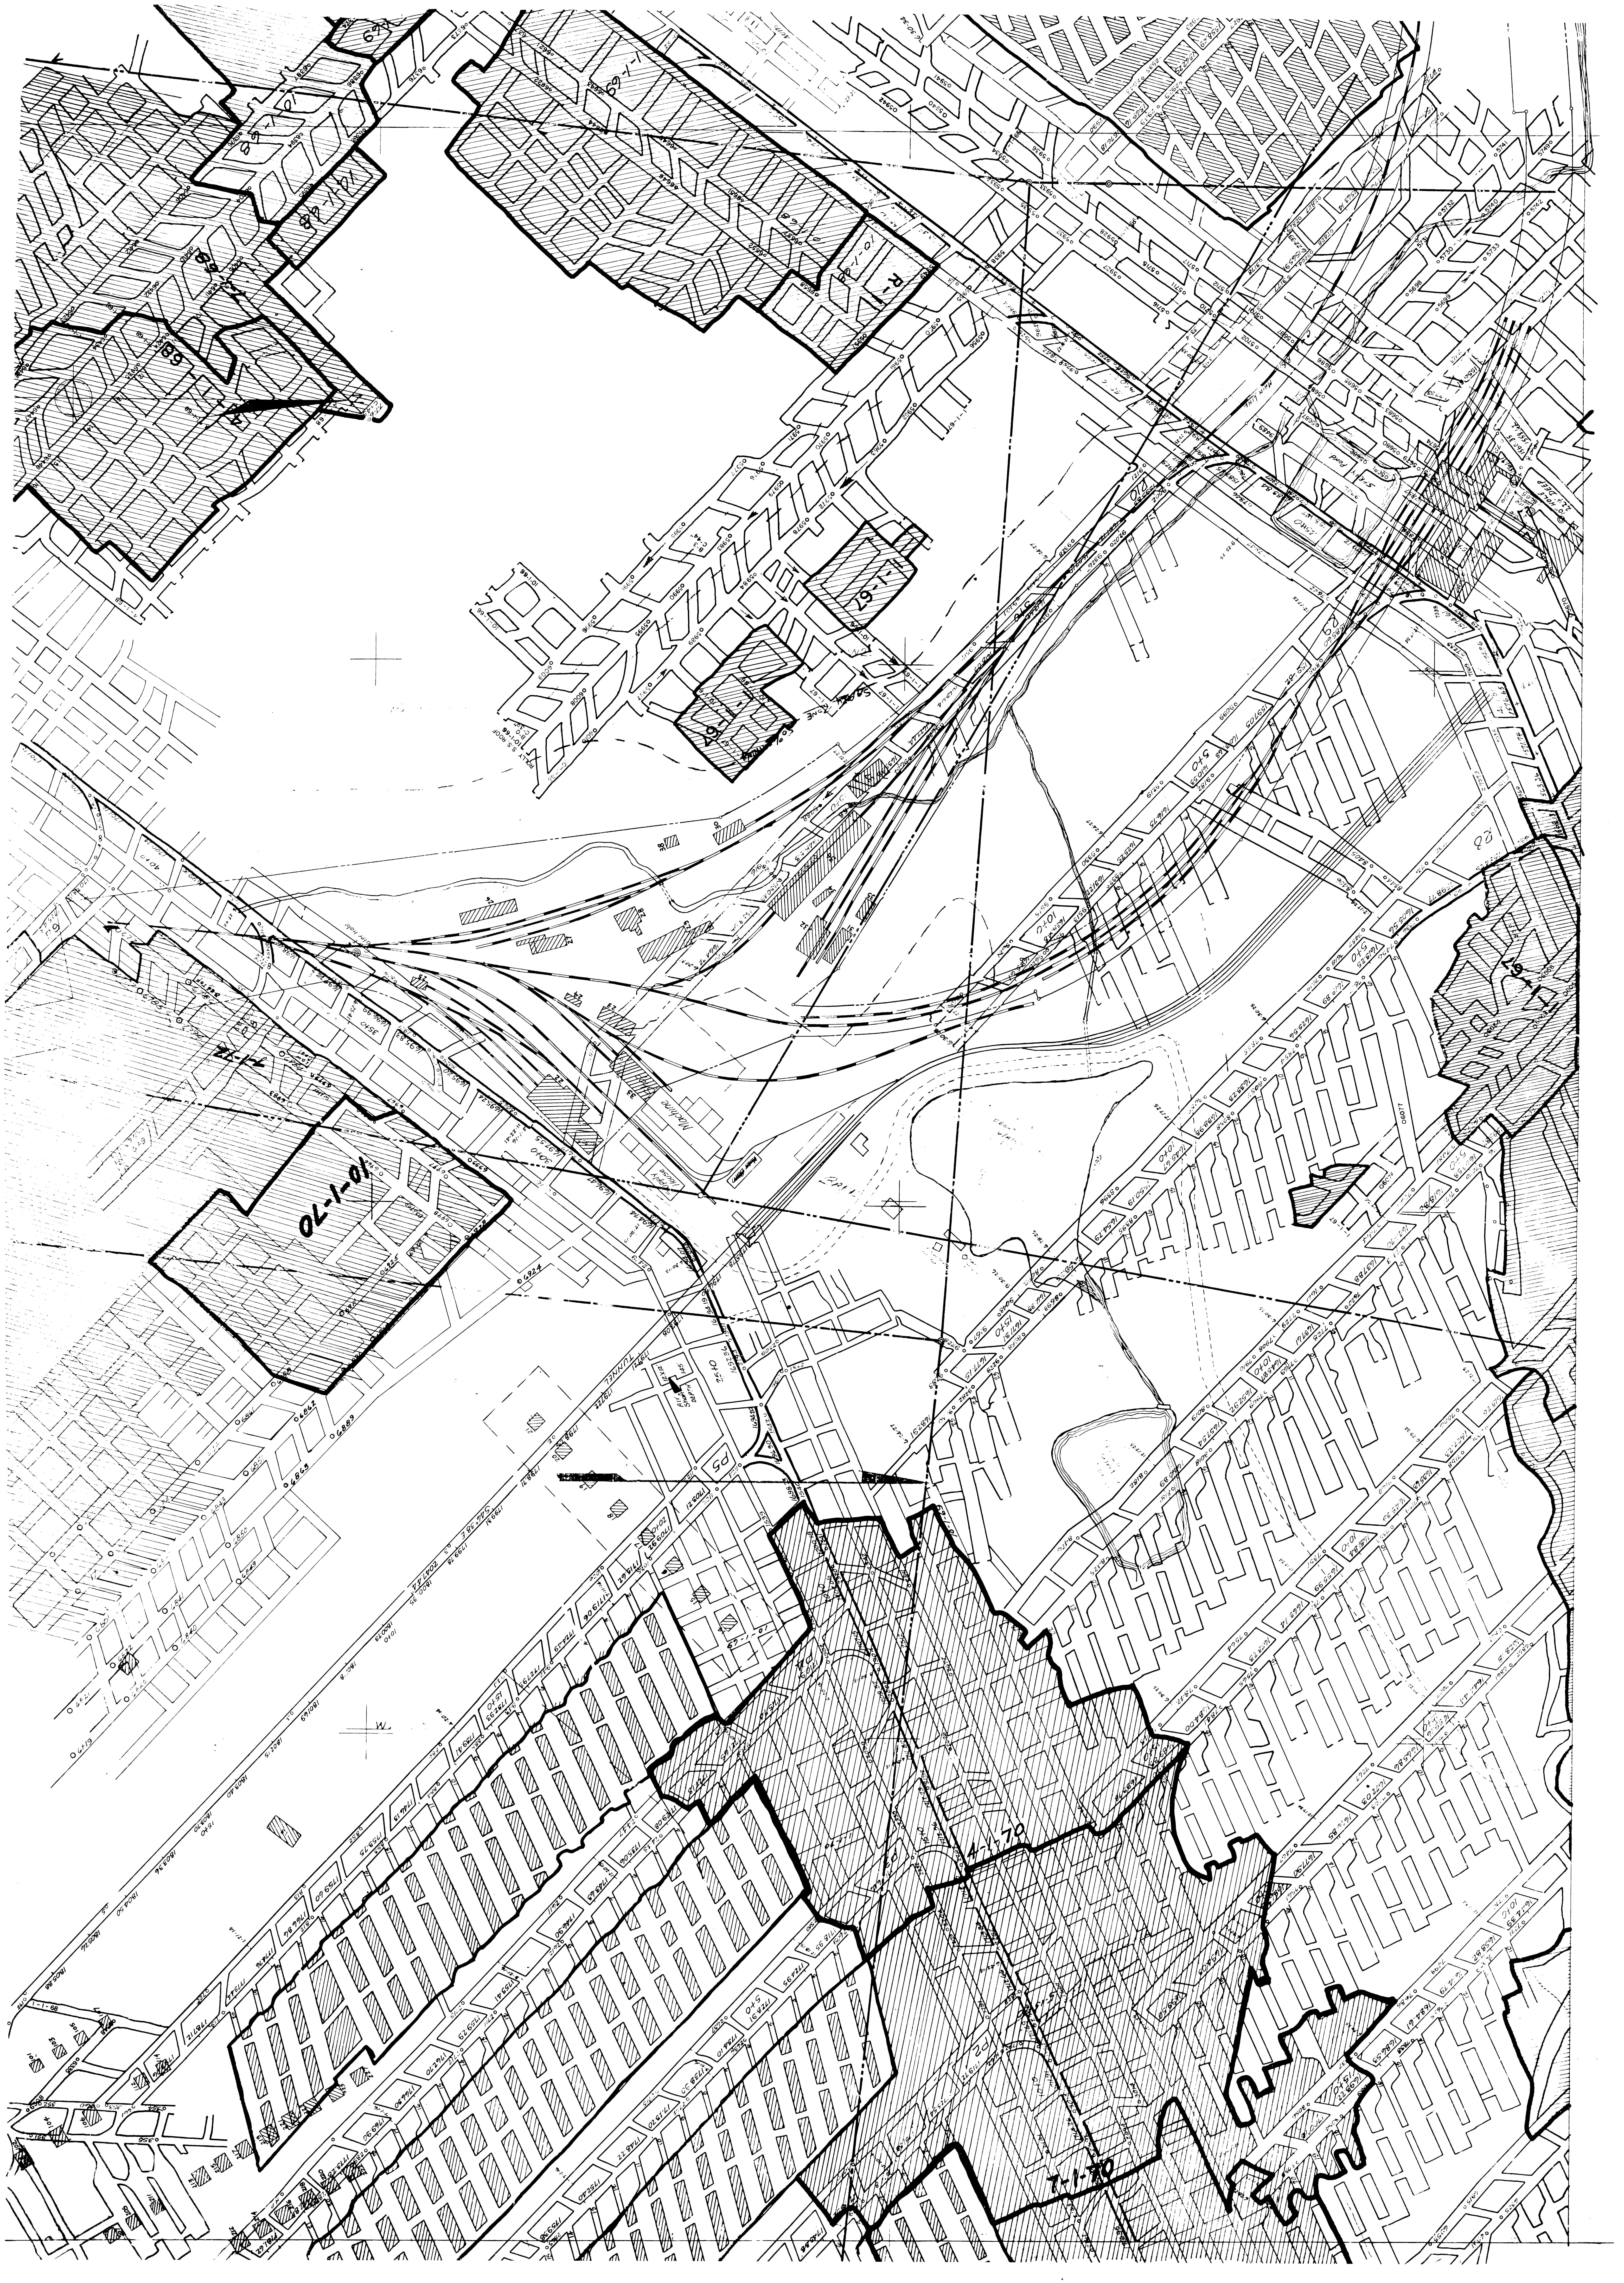
10-1-68
1-1-69
1-1-68
R-1
10-1-66
ROLLY S.S. ROOF
1-1-67
Main Line
S-Ray Pond
10-1-70
7-1-72
Machine
Supply House
Motor Barn
TUNNEL
Air Shaft
Depth
P5
P4
P2
R8
R9
R10
540
1040
1540
4-1-70
7-1-70
10-1-69
S46°38'E

EASTERN ASSOCIATED COAL CORPORATION

SCALE: 1"=100'

SHEET OF 45