


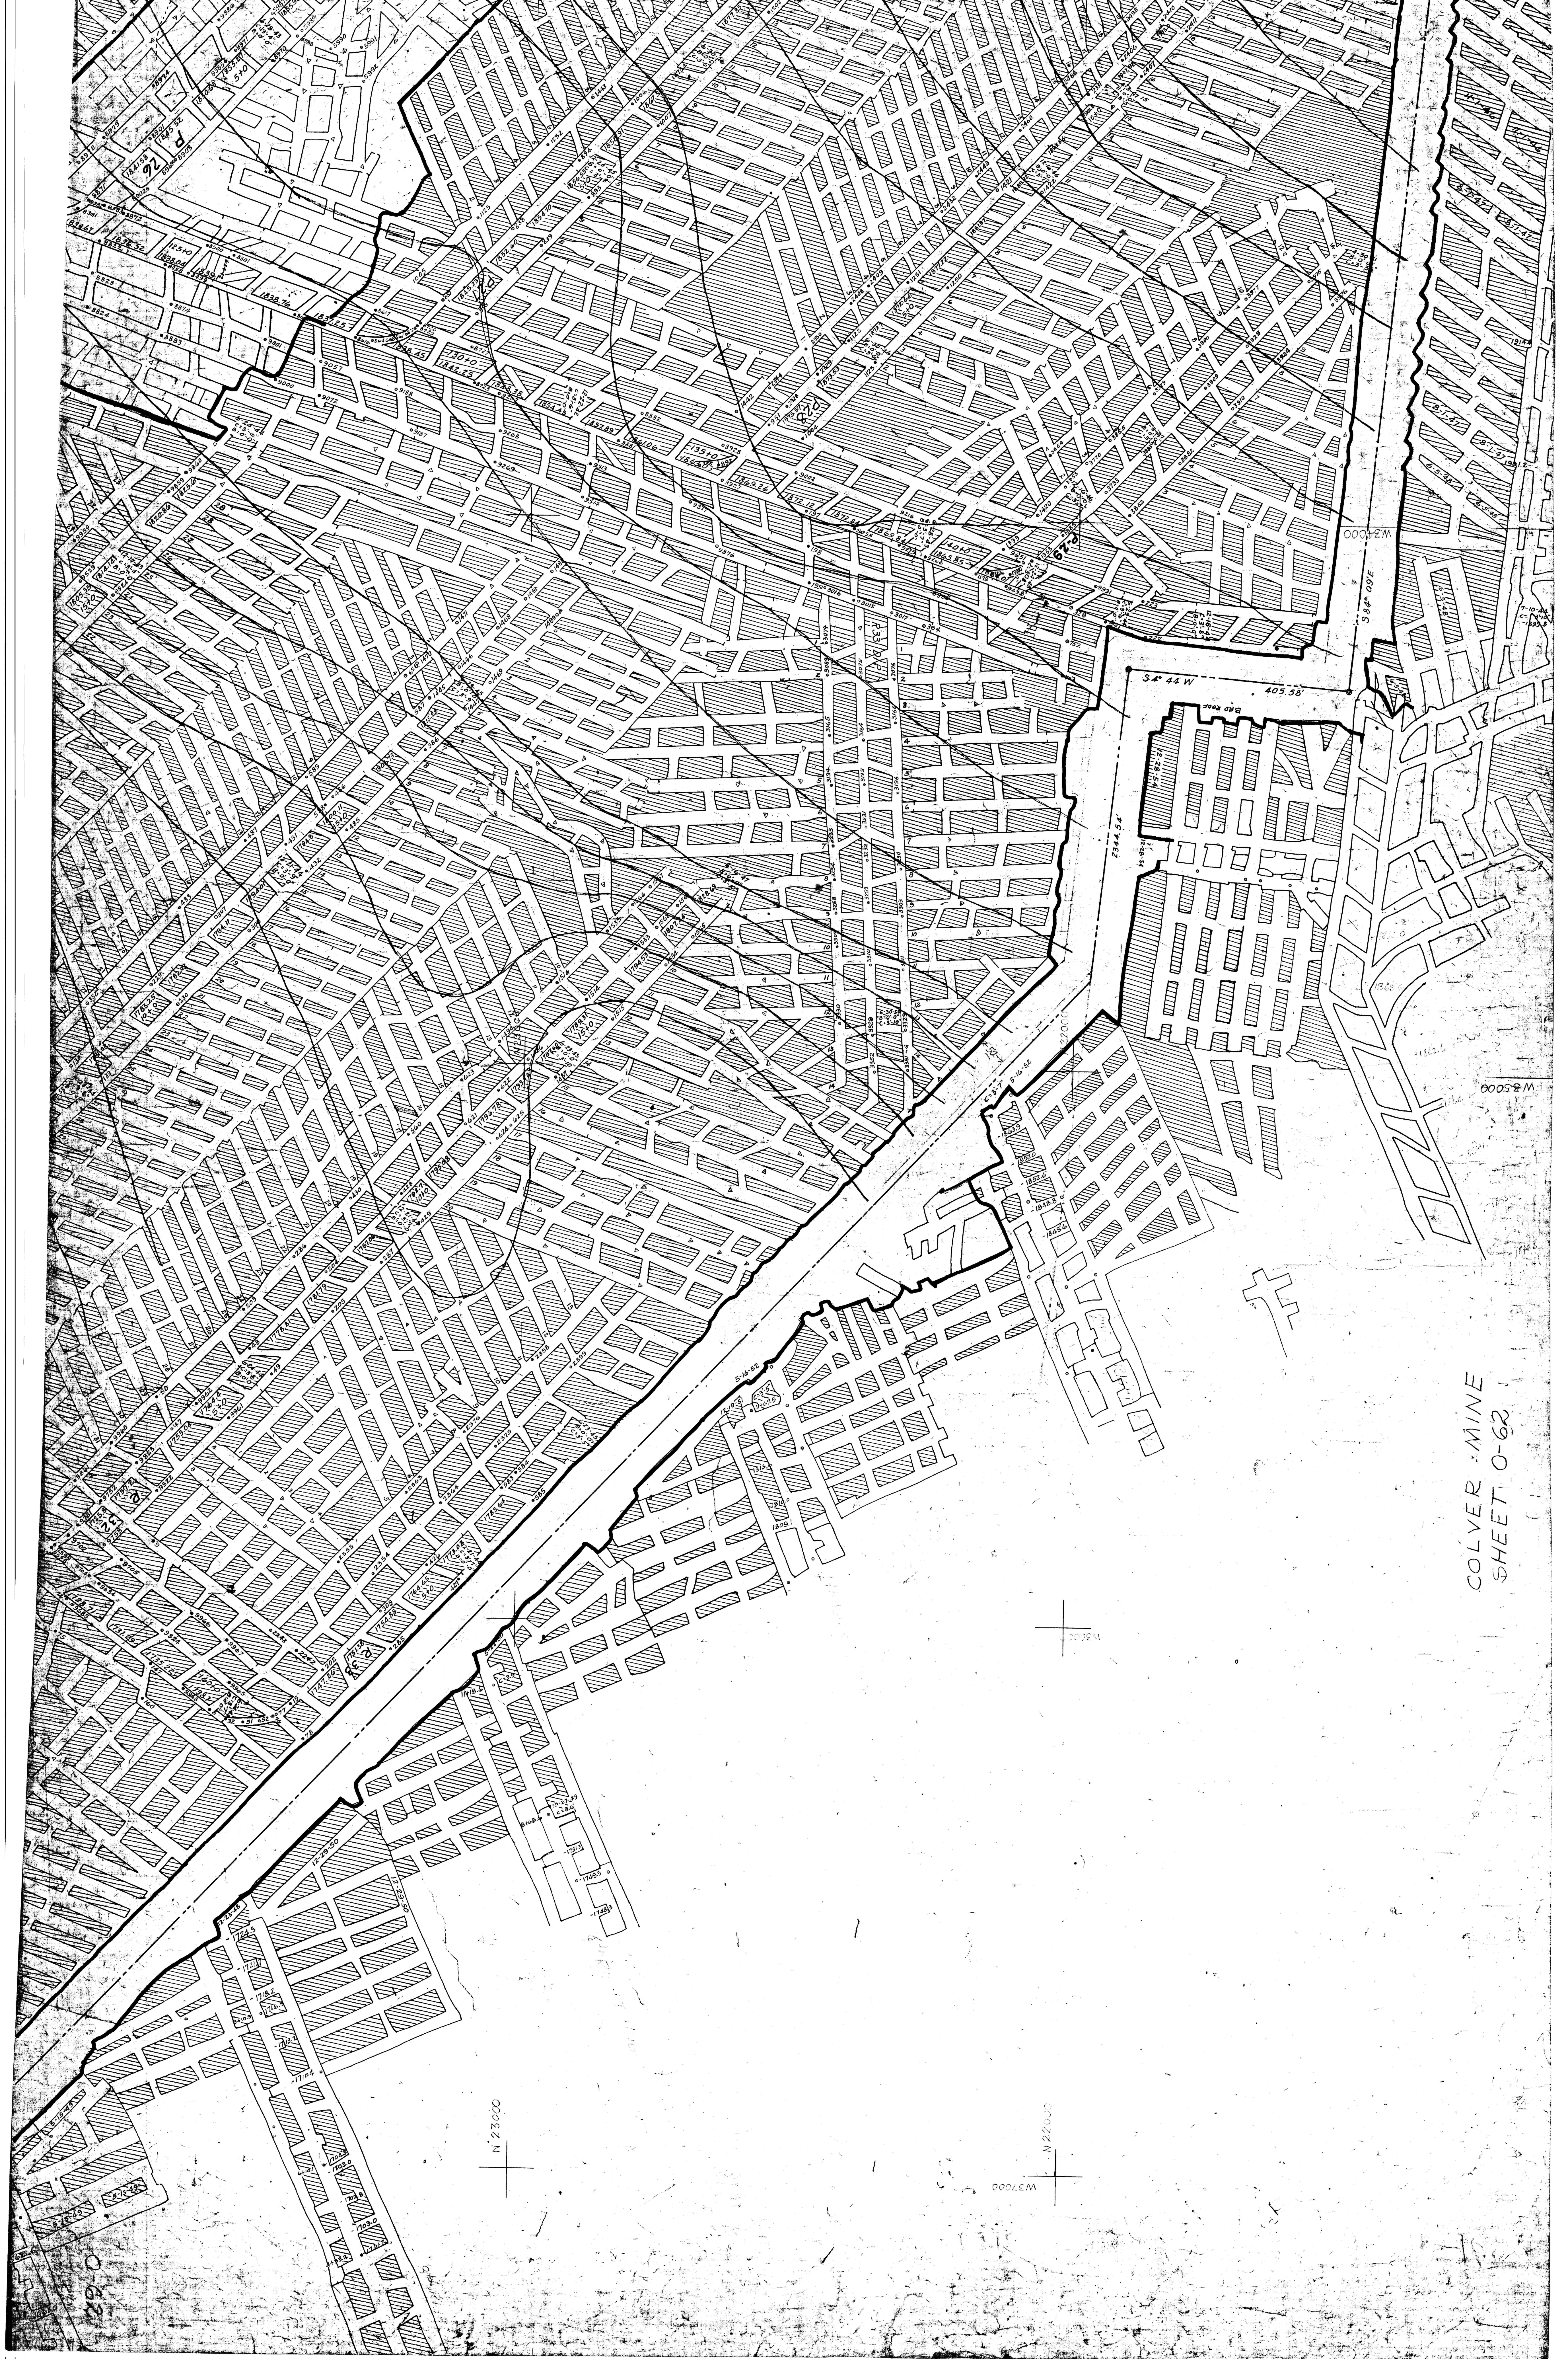

COLVER MINE
SHEET 0-62