


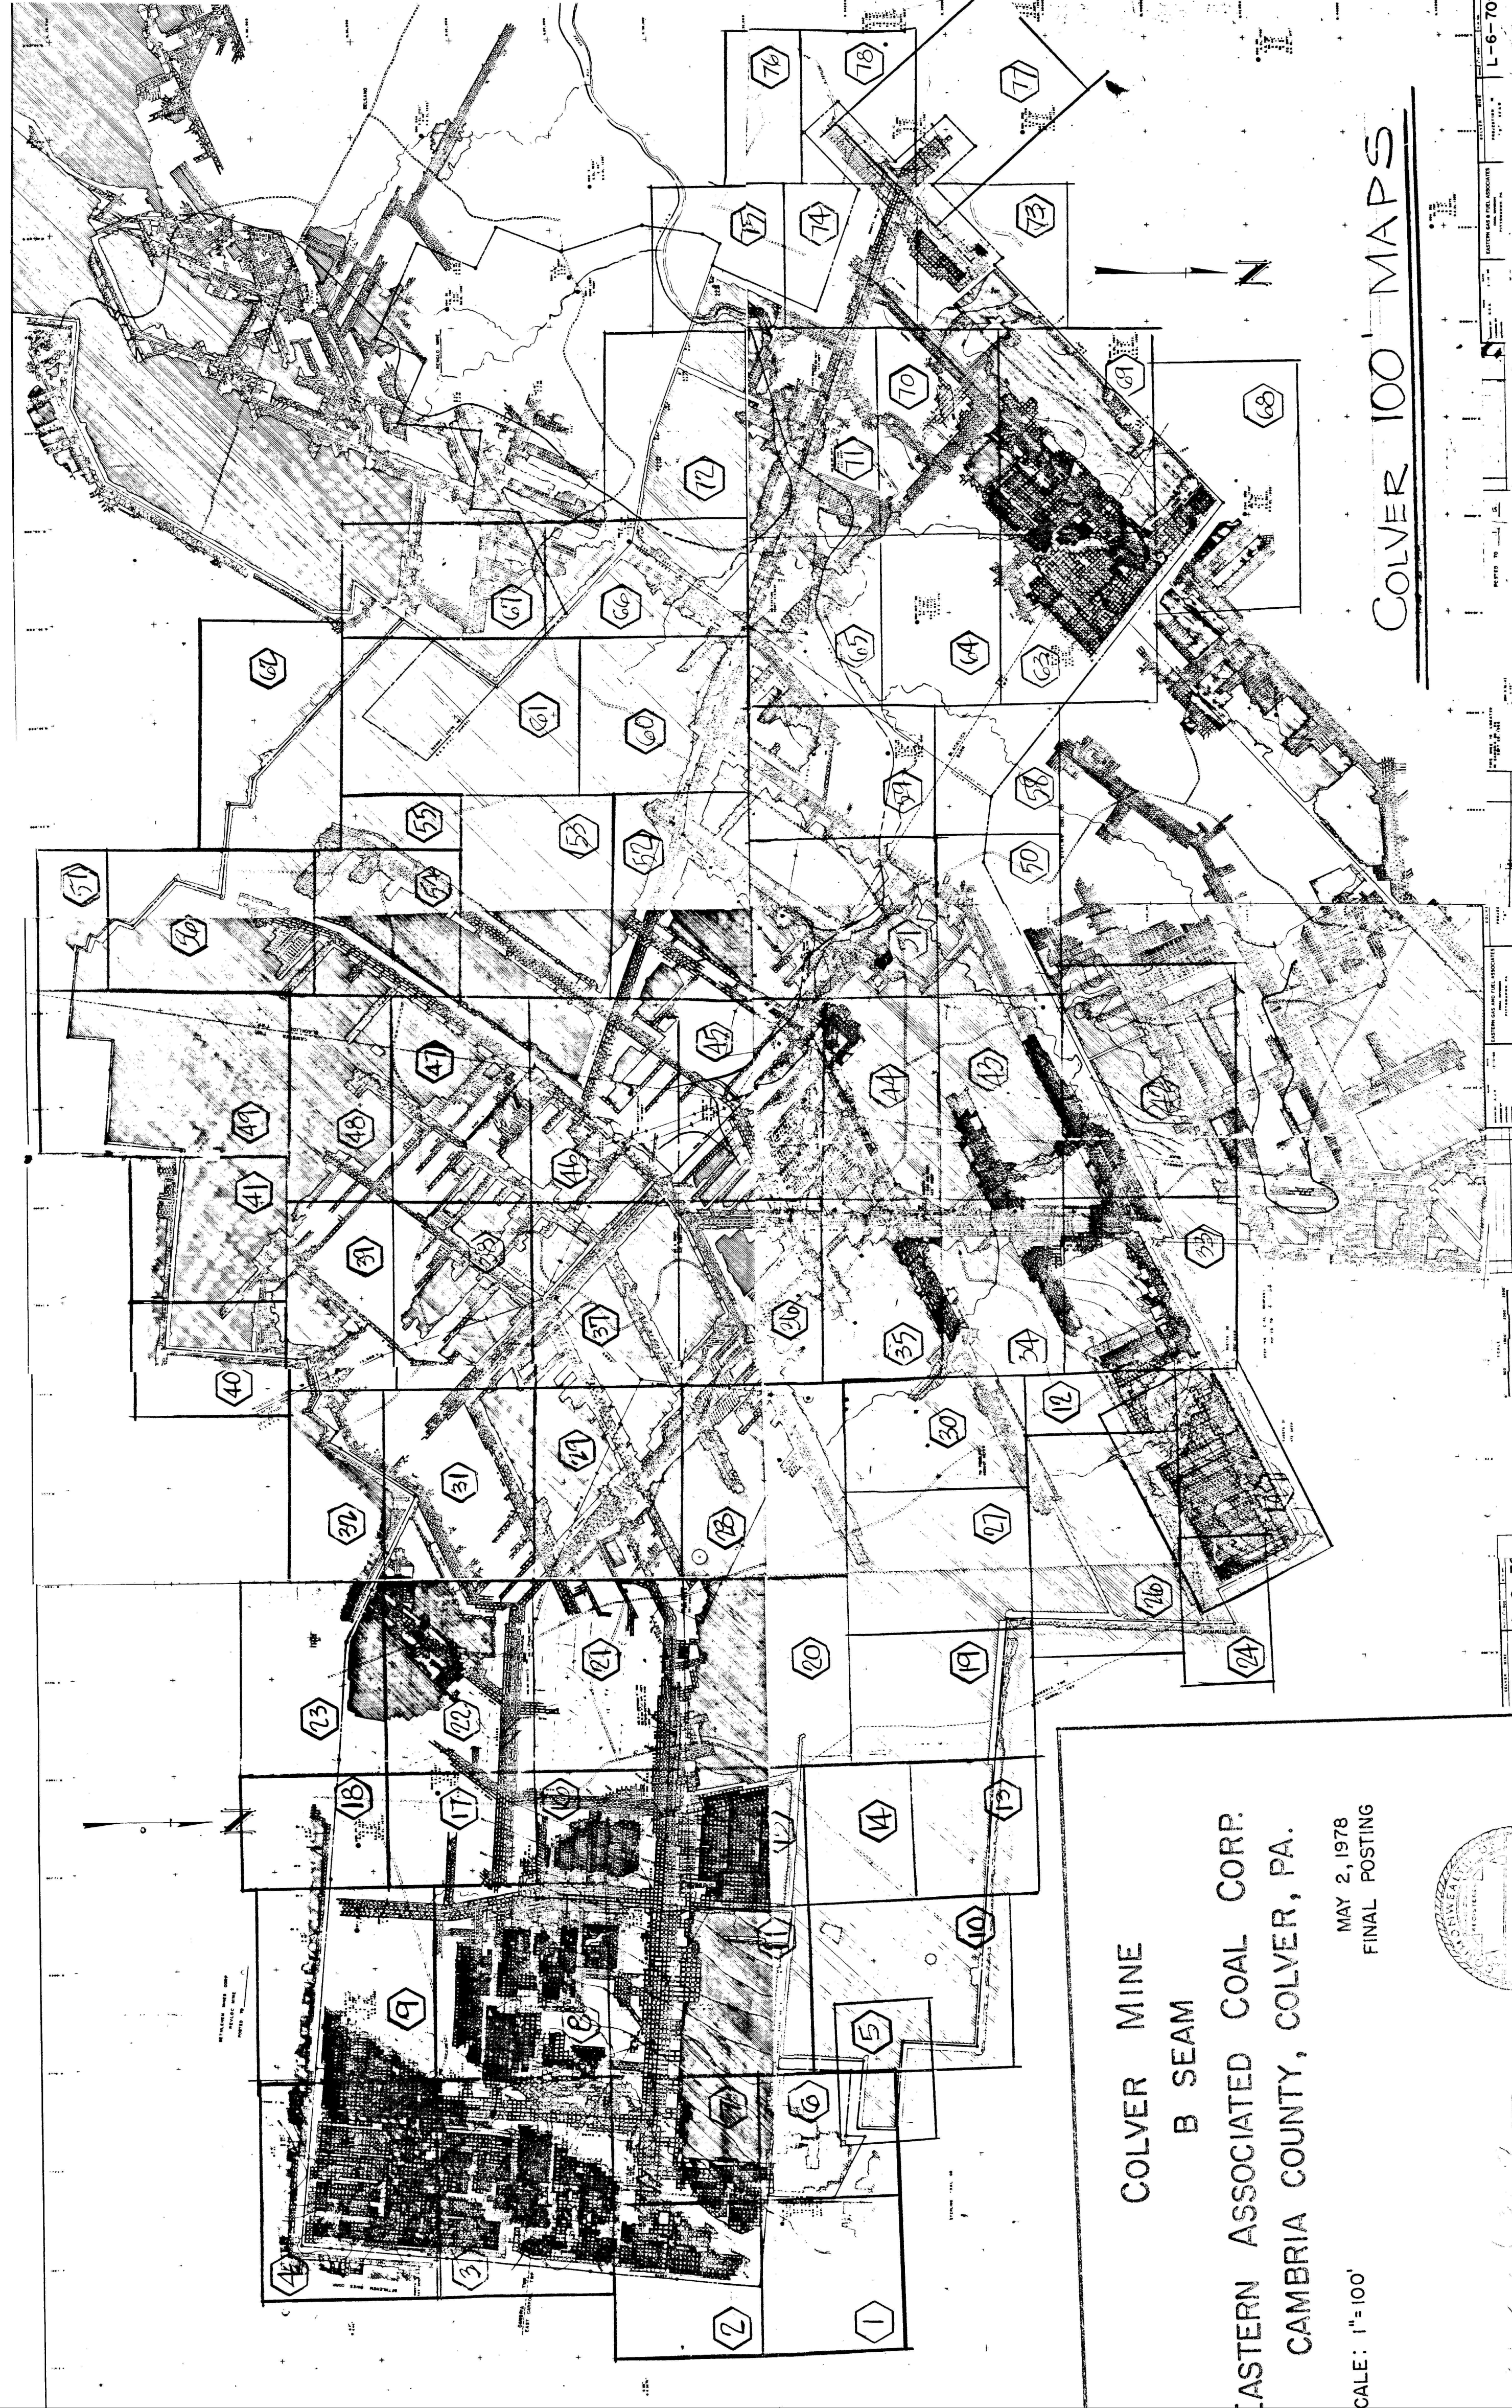


COLVER MINE  
B SEAM

EASTERN ASSOCIATED COAL CORP.  
CAMBRIA COUNTY, COLVER, PA.

MAY 2, 1978  
FINAL POSTING

SCALE: 1"=100'

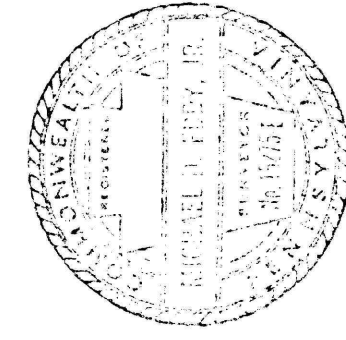

REGISTRATION NO. \_\_\_\_\_