


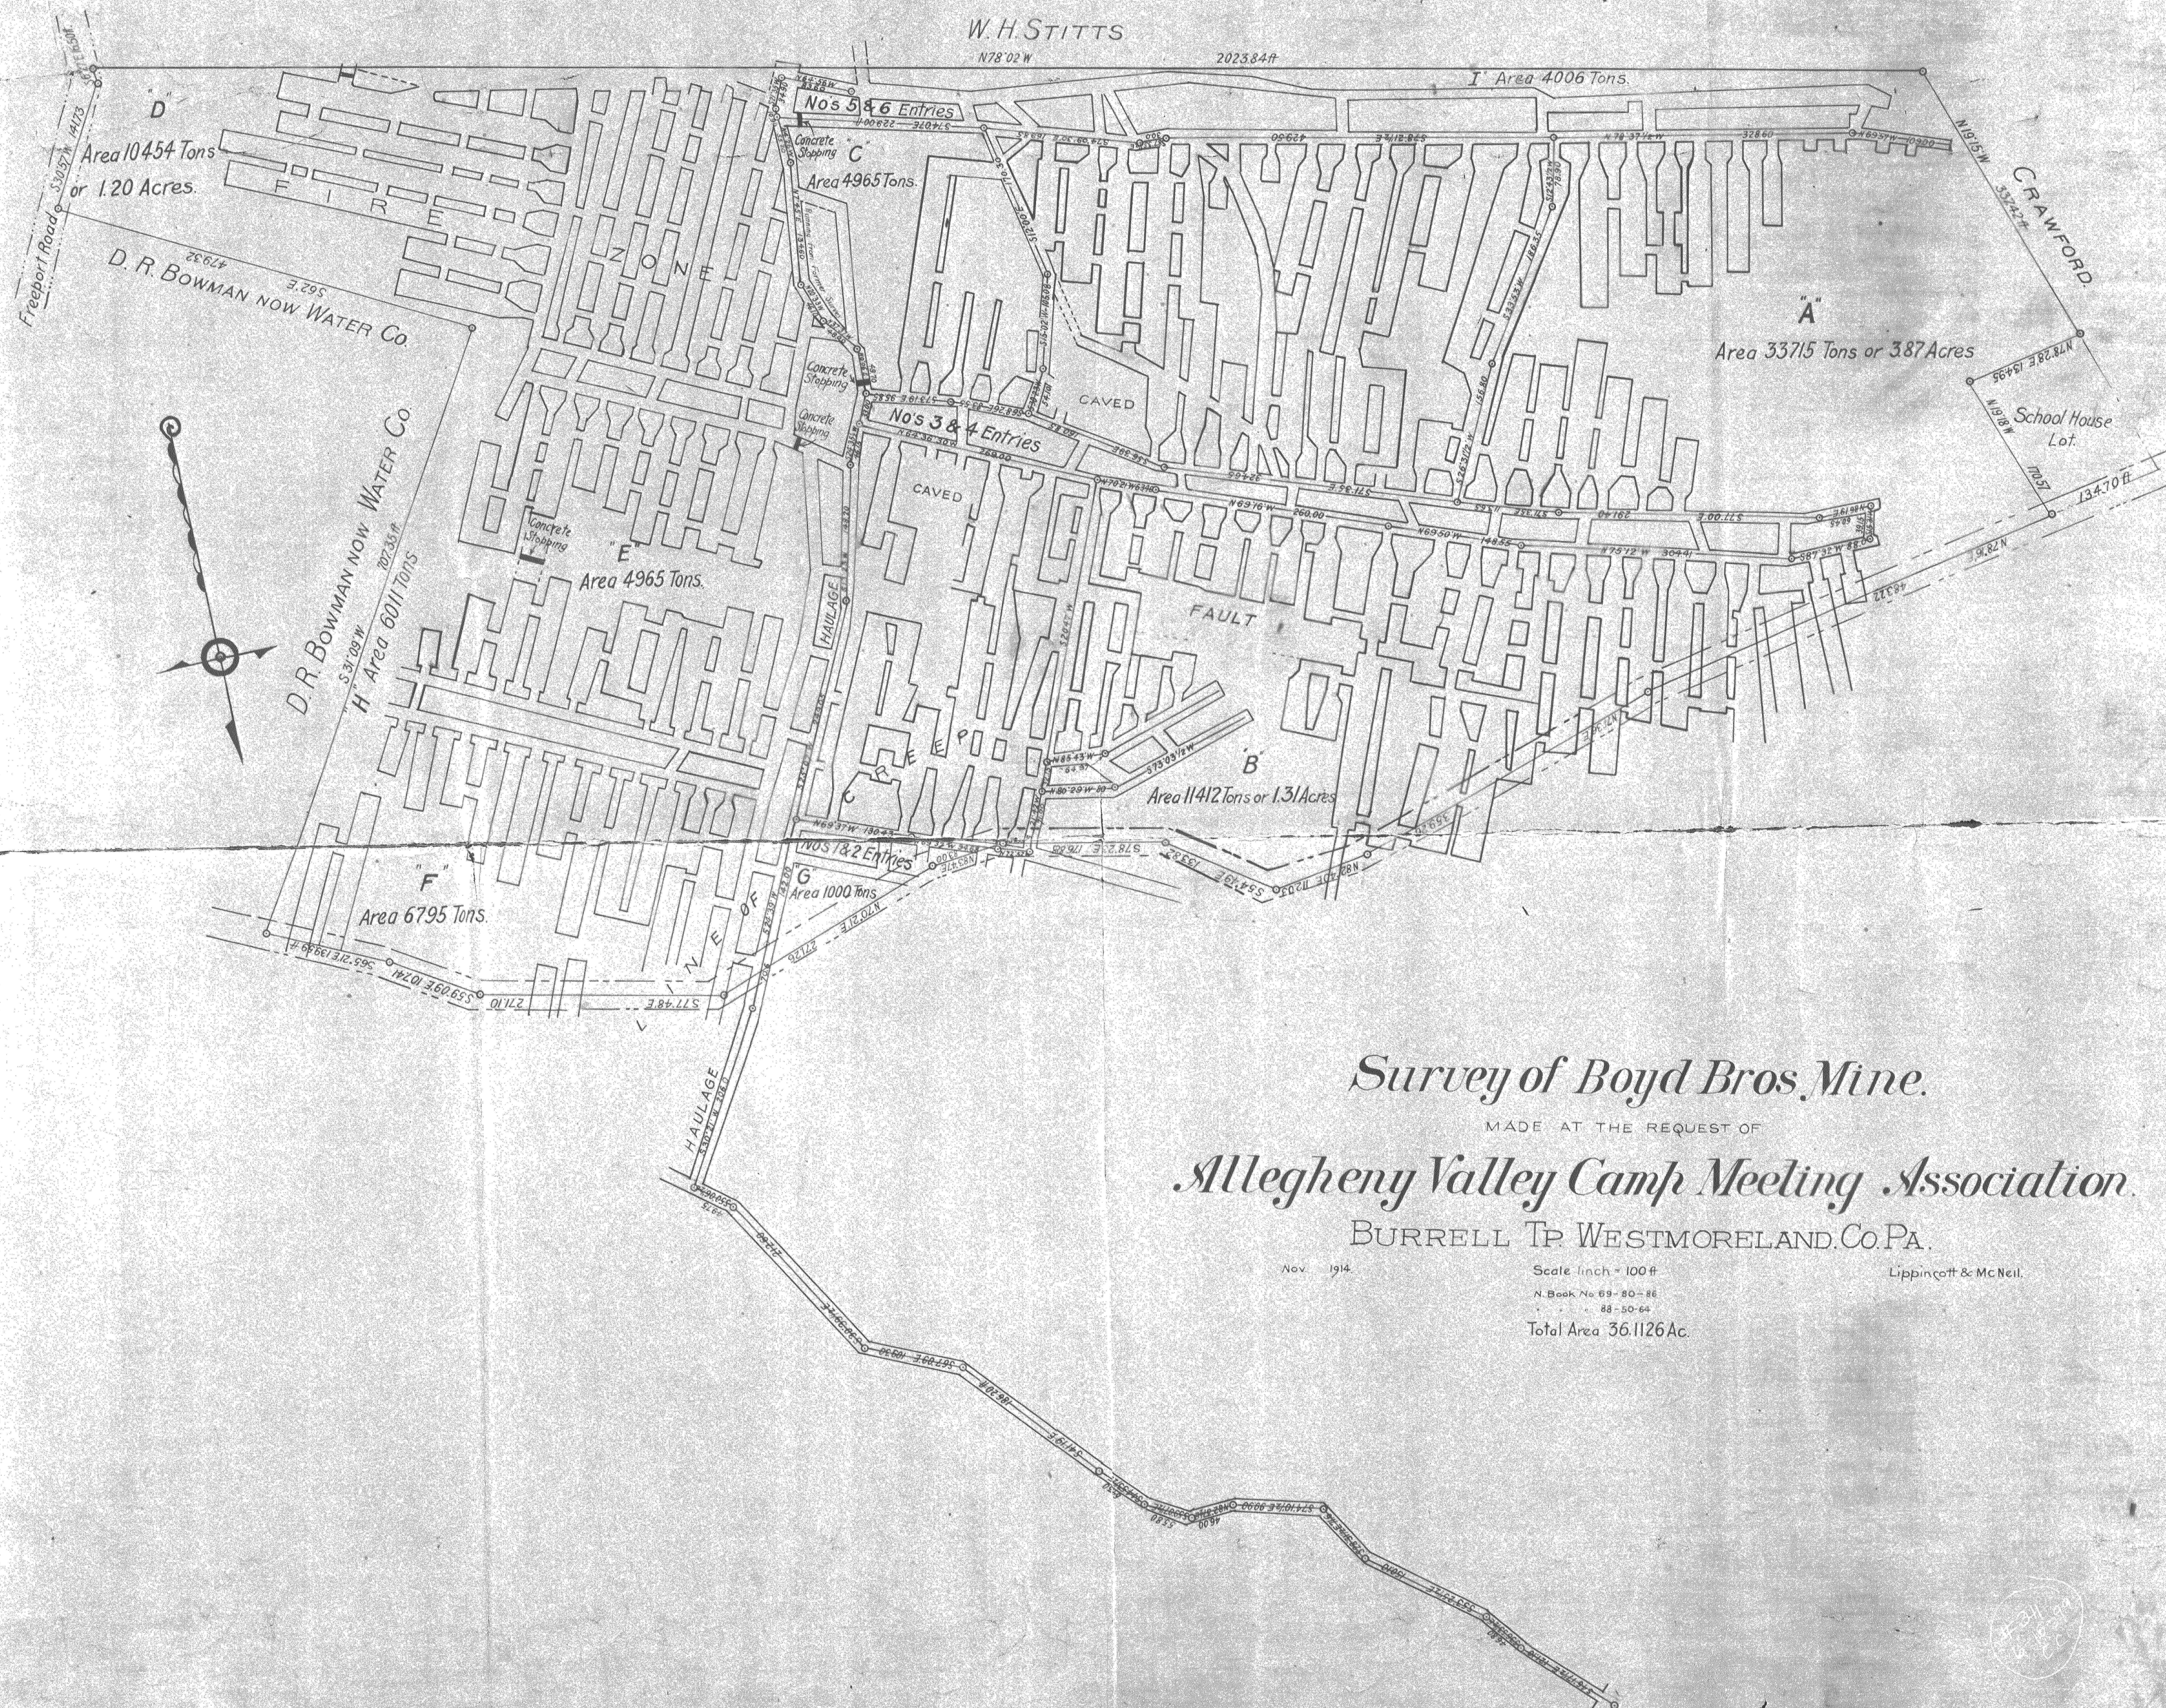

Survey of Boyd Bros. Mine.

MADE AT THE REQUEST OF

Allegheny Valley Camp Meeting Association.

BURRELL TP. WESTMORELAND CO. PA.

Nov. 1914.

Scale 1 inch = 100 ft.

Lippincott & McNeil.

N. Book No. 89 - 80 - 88

88 - 50 - 64

Total Area 36.1126 Ac.