


 


FINAL MINE MAP

CANTERBURY COAL CO.
DIANNE MINE
LOWER KITTANNING SEAM
PERMIT NO. 3841302
MSHA I.D. #36-05708
CMAP # 03841302

DATE: 7-19-00

LEGEND

- STOPPING:
- PERMANENT
- PERMANENT WITH HOLE
- OR
- INTAKE AIR
- RETURN AIR
- BELT AIR
- OVERCAST
- DOOR
- EQUIPMENT DOOR
- REGULATOR
- BELT
- TRACK
- SEALS
- CHECK CURTAIN

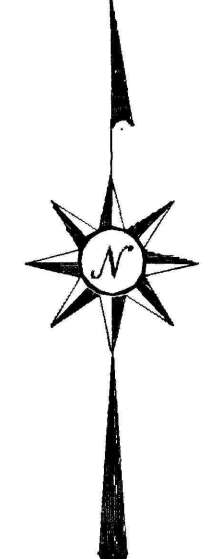

CANTERBURY GRID NORTH
GRAPHIC SCALE (1"=400')