


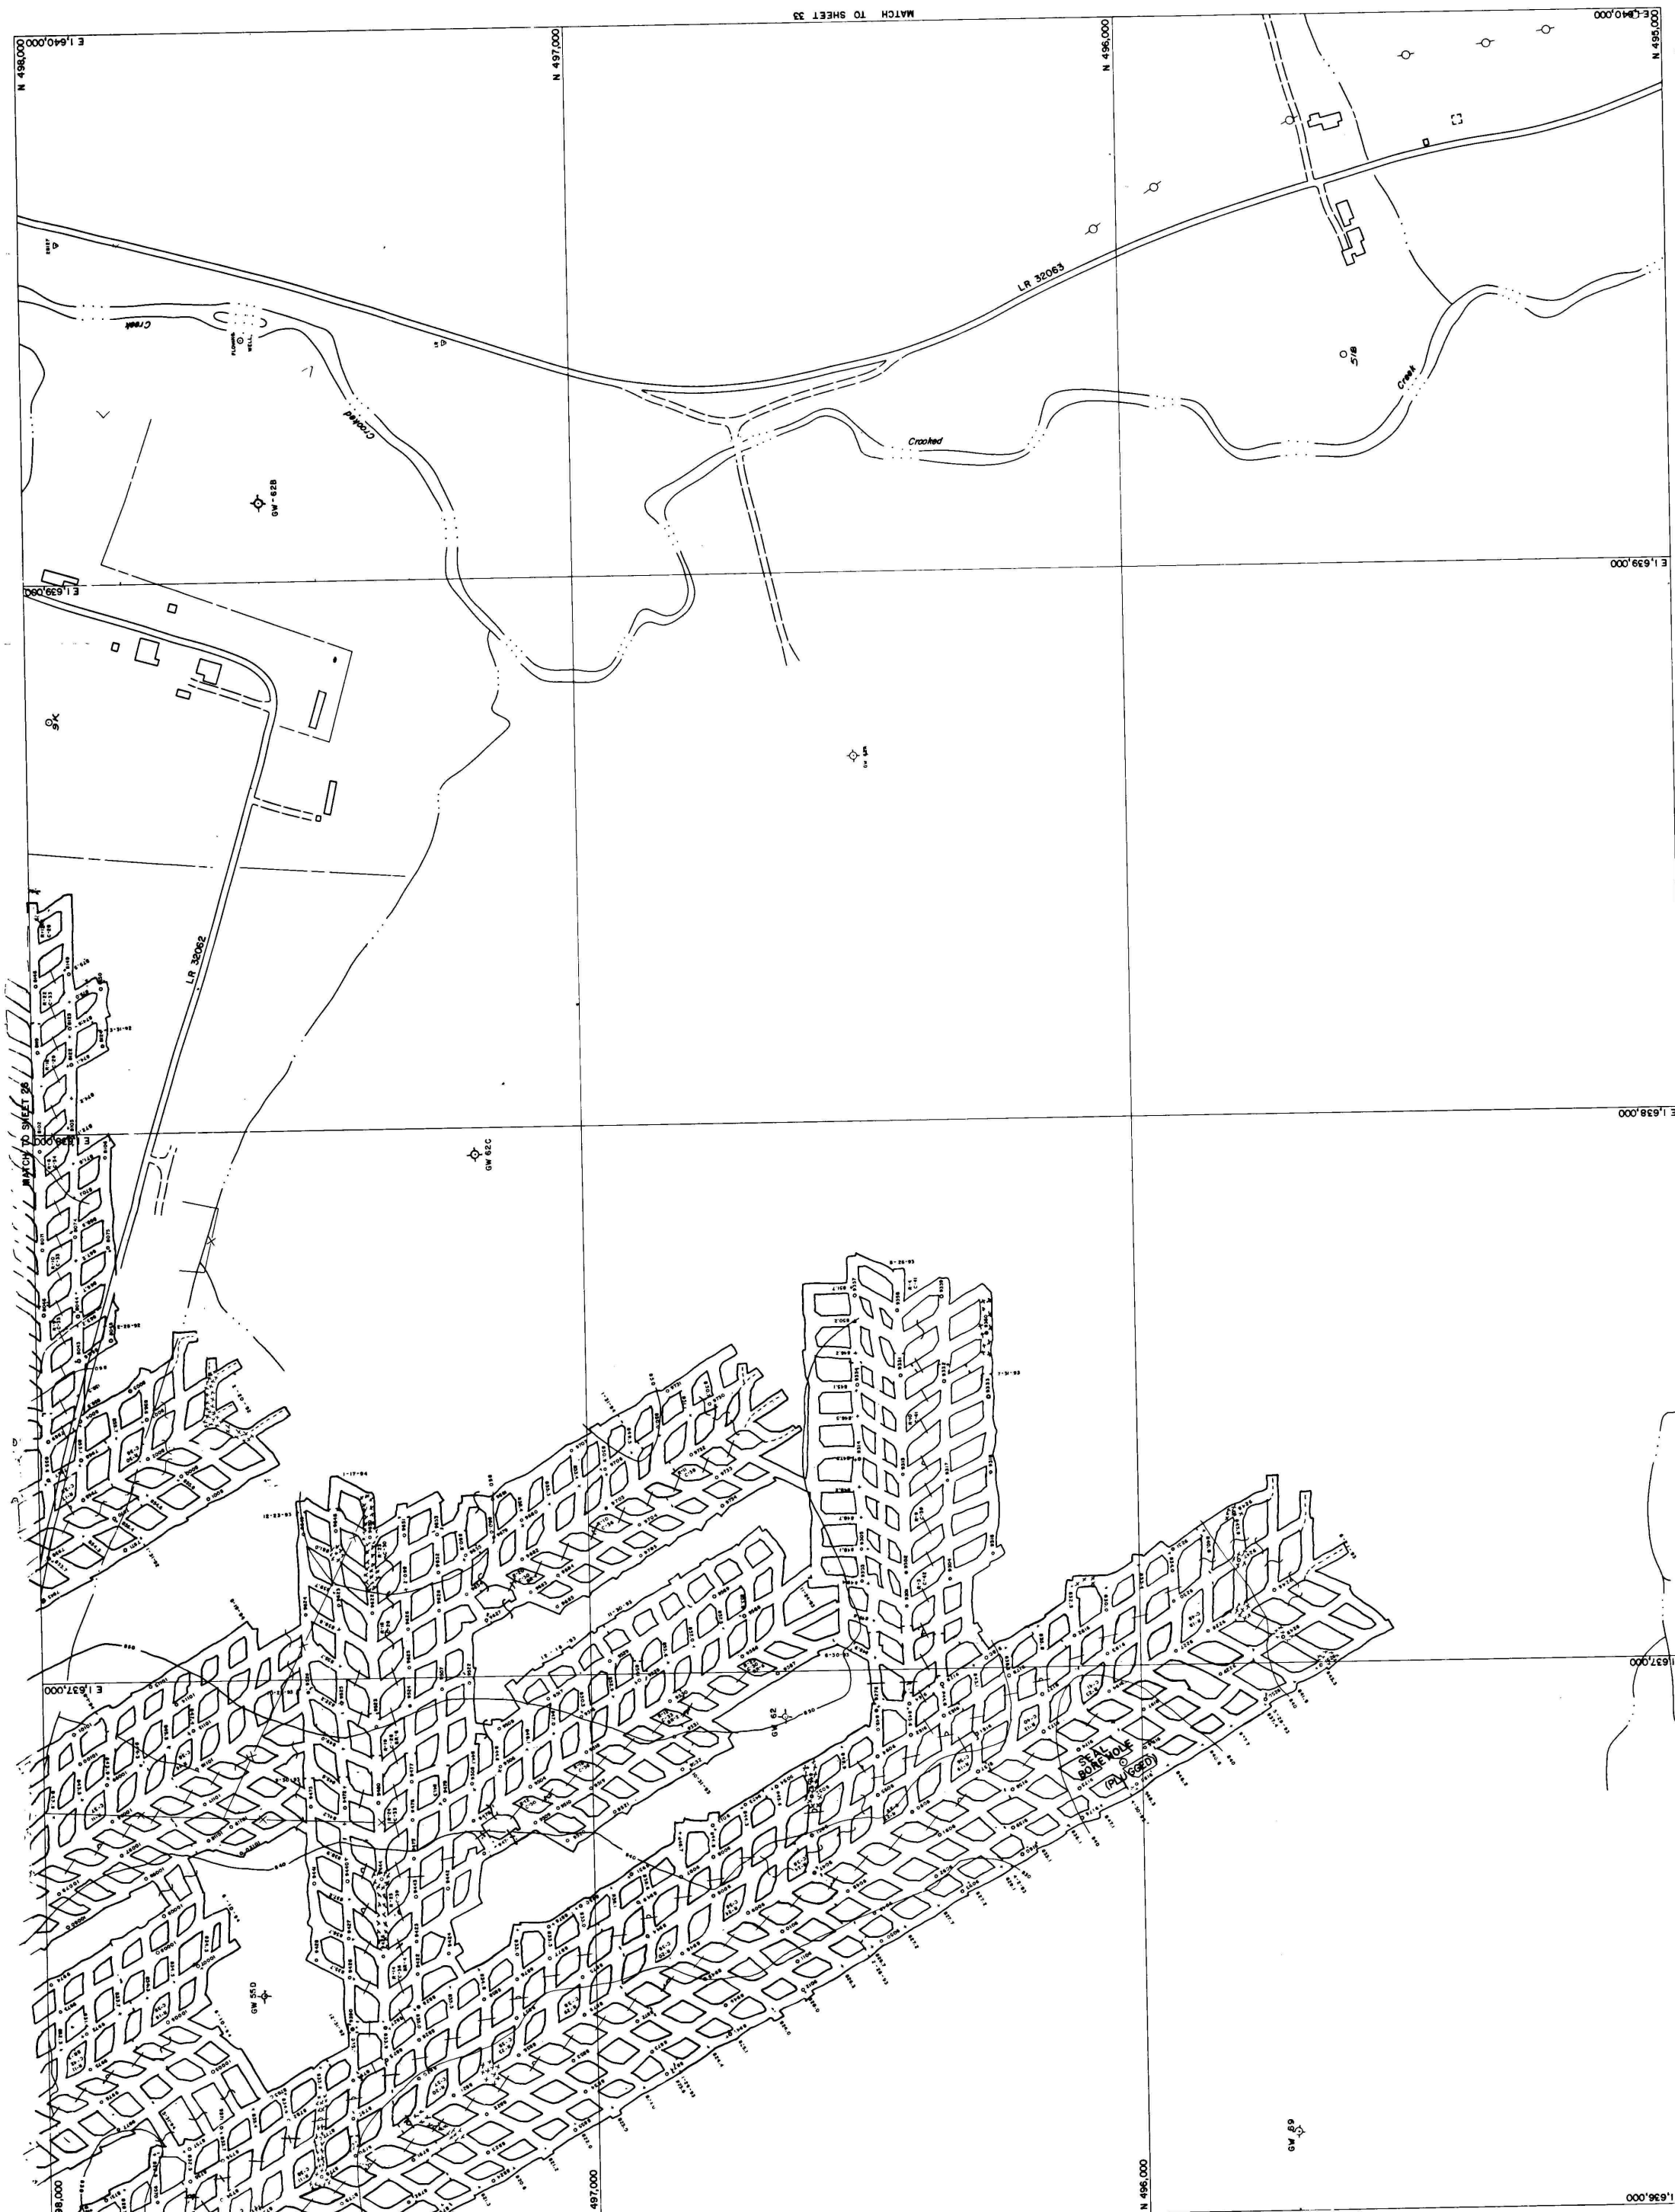

- LEGEND
- MONUMENT & ELEVATION
 - MONUMENT
 - PROPERTY CORNER
 - GAS WELL
 - IRON PIN
 - DIAMOND & ROTARY
 - DRILL HOLE

MATCH TO SHEET 37

PLANIMETRIC MAP
TANOMA MINE
RAYNE TOWNSHIP, INDIANA CO. PA.
SCALE: 1" = 100'

This map compiled from aerial photographs taken April, 1979
L. Robert Kimball, Consulting Engineer, Pennsylvania for
BARNES & TUCKER COMPANY

N 495,000

E 1,636,000

MATCH TO SHEET 31

N 497,000

N 496,000

E 1,637,000

E 1,639,000

E 1,639,000

E 1,640,000

N 497,000

N 496,000

N 495,000

N 498,000

E 1,640,000