


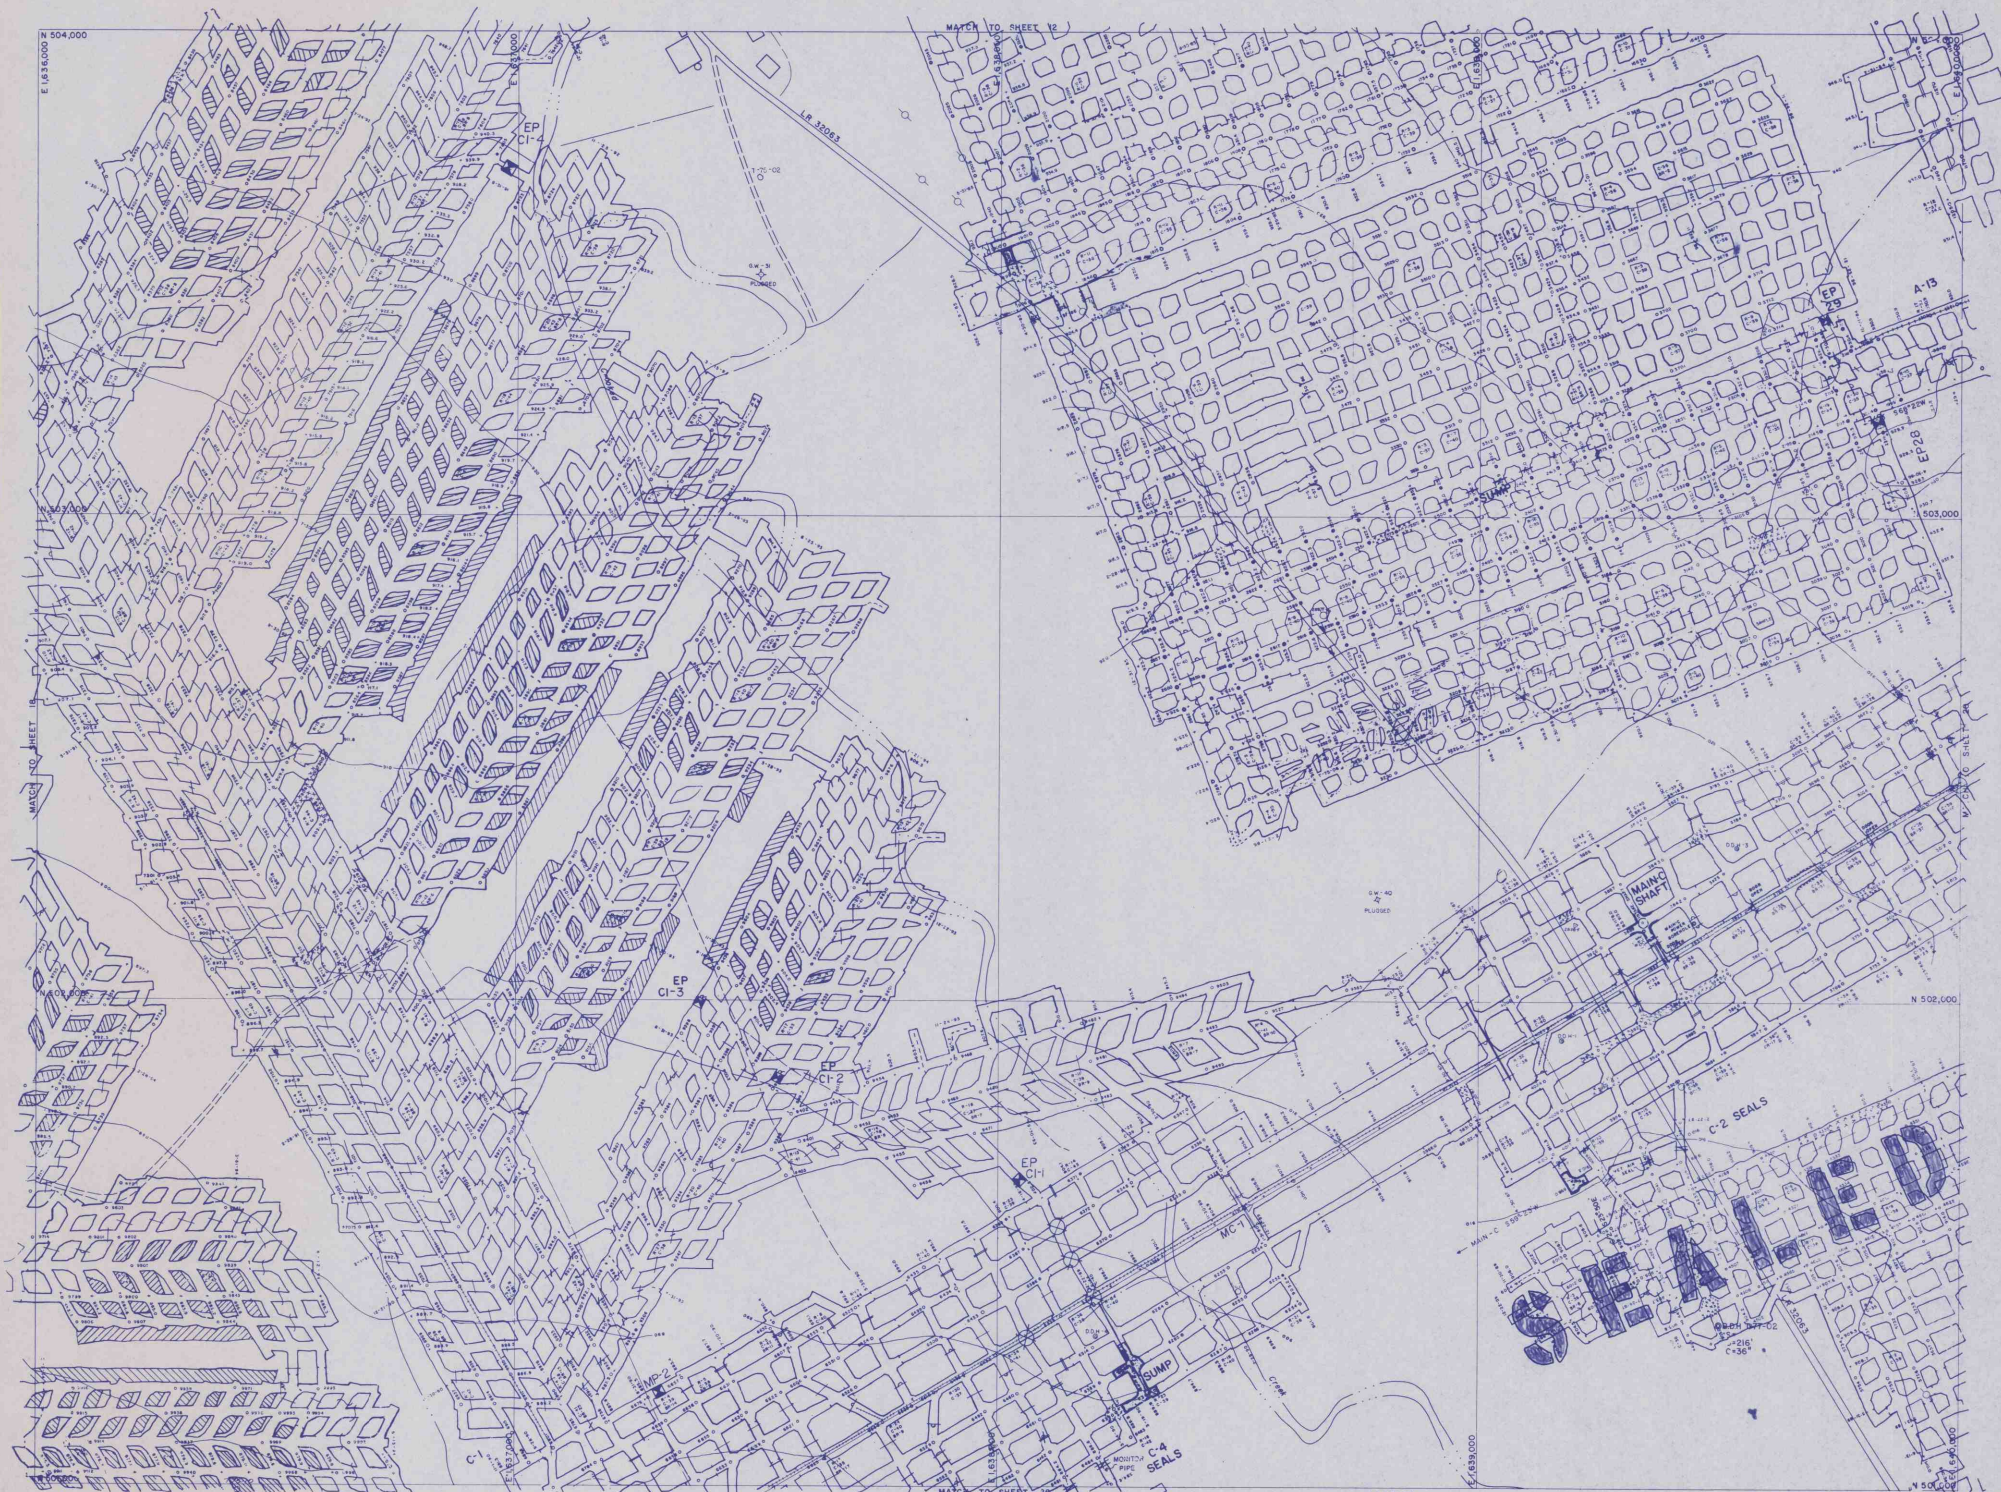

This map compiled from aerial photography taken April, 1979
 L. Robert Kimball, Consulting Engineers, Pennsylvania for
 BARNES & TUCKER COMPANY



- LEGEND
- MONUMENT & ELEVATION
 - △ MONUMENT
 - PROPERTY CORNER
 - GAS WELL
 - △ IRON PIN
 - DIAMOND & ROTARY DRILL HOLE

PLANIMETRIC M-AP
 TANOMA MINE
 RAYNE TOWNSHIP, INDIANA CO. PA.
 SCALE: 1" = 100'