




Map compiled from aerial photography taken April, 1979
L. Robert Kimball, Consulting Engineers, Pennsylvania for
BARNES & TUCKER COMPANY

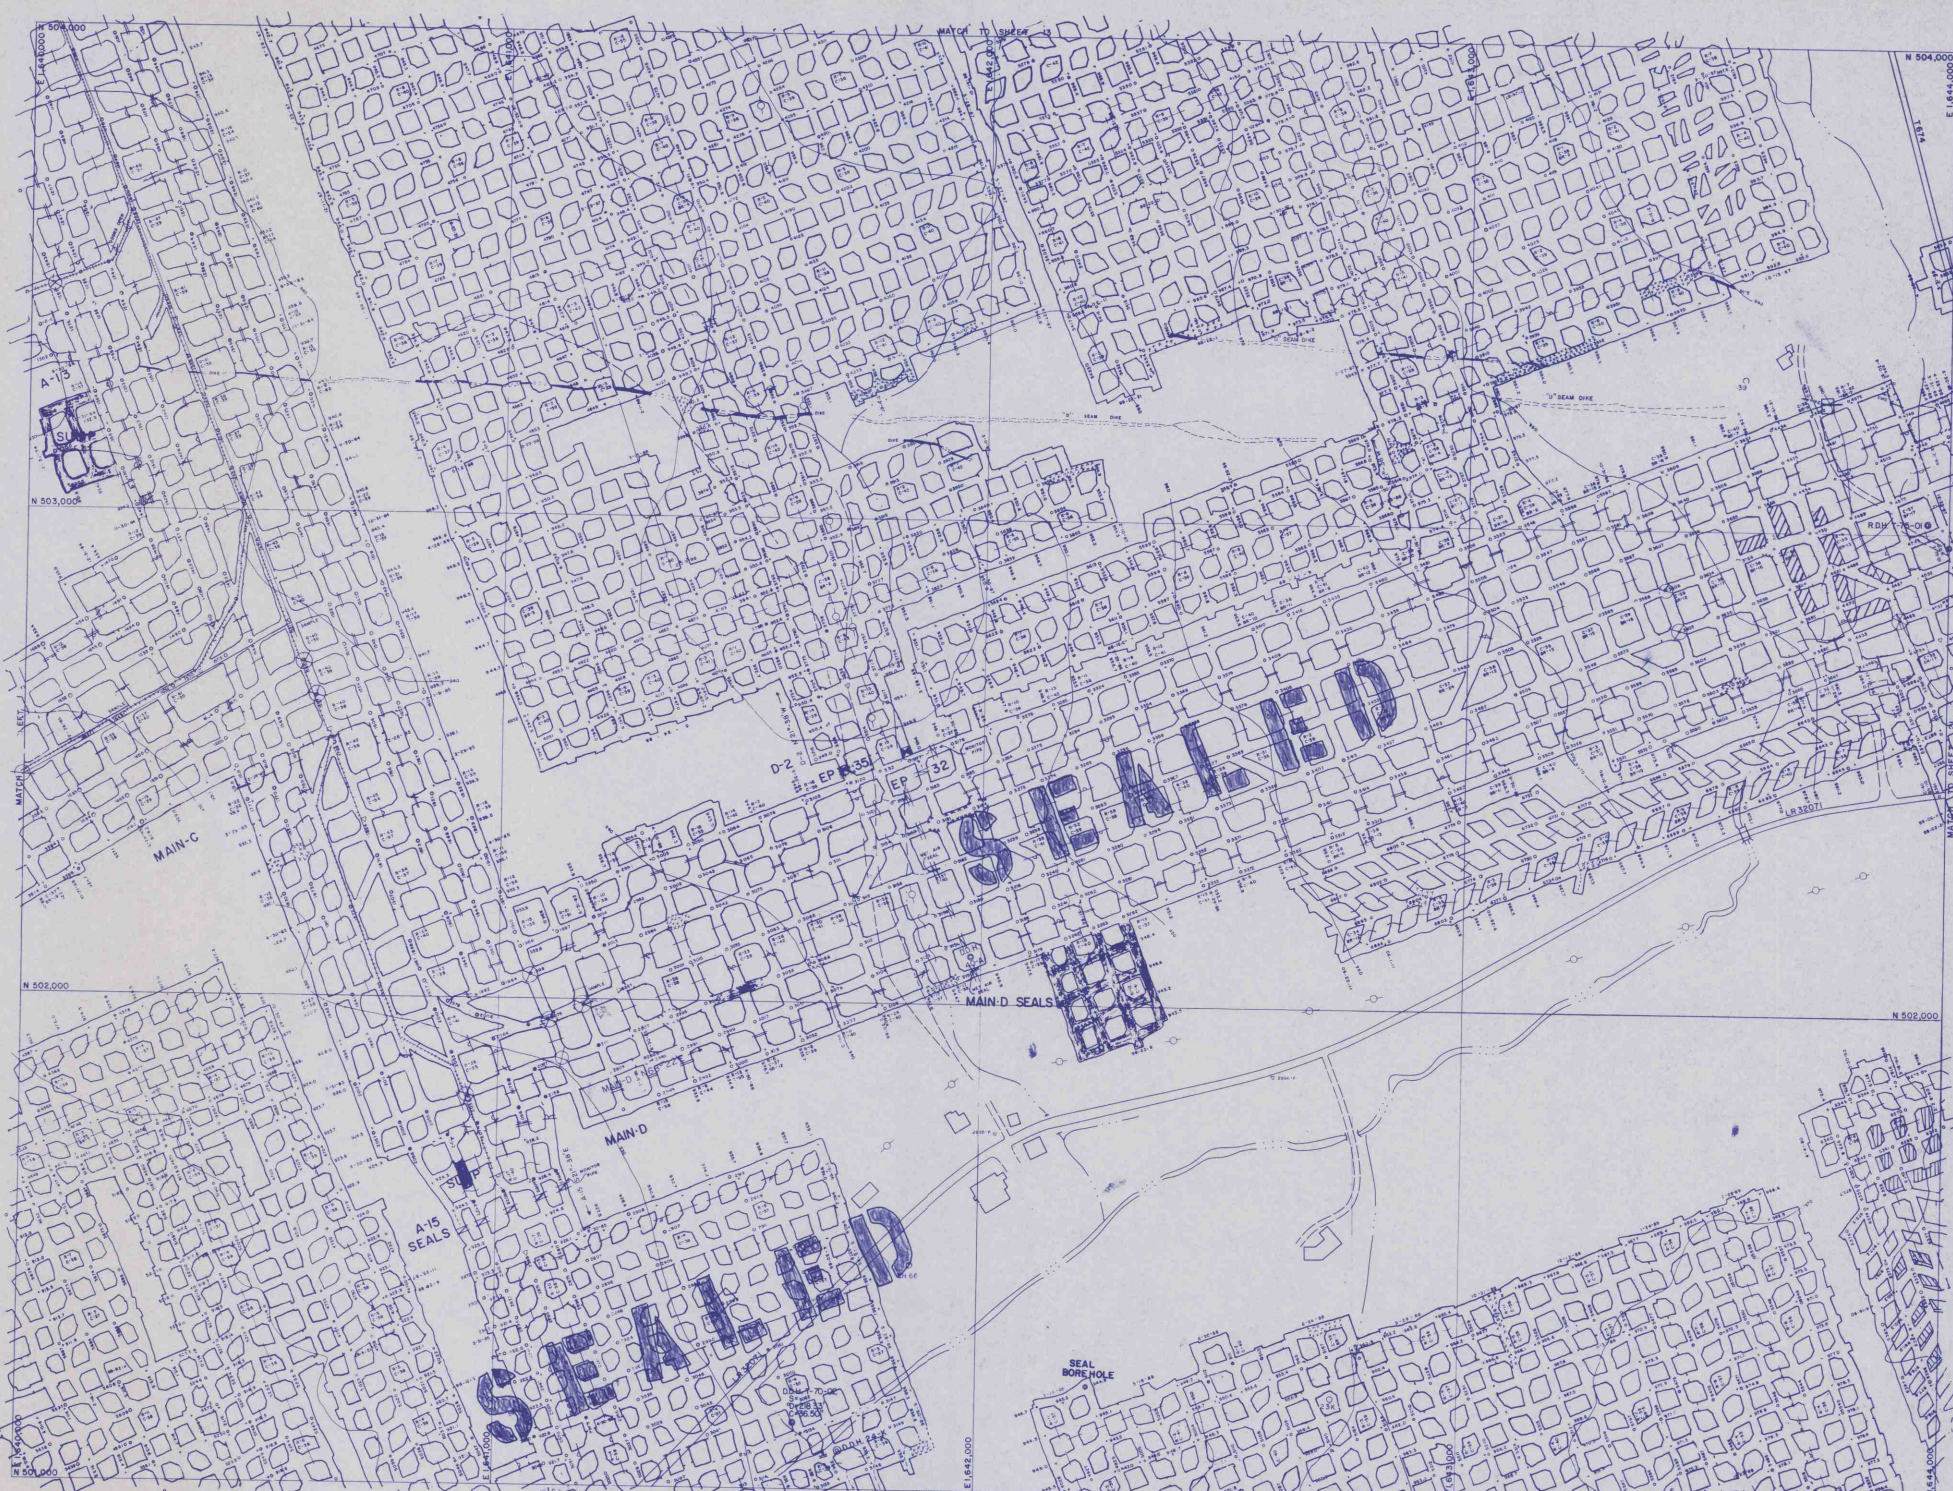

MATCH TO SHEET 27

- LEGEND
- MONUMENT & ELEVATION
 - △ MONUMENT
 - PROPERTY CORNER
 - GAS WELL
 - △ IRON PIN
 - DIAMOND & ROYALTY DRILL HOLE

PLANIMETRIC MAP
TANOMA MINE
RAYNE TOWNSHIP, INDIANA CO. PA.
SCALE: 1" = 100'