


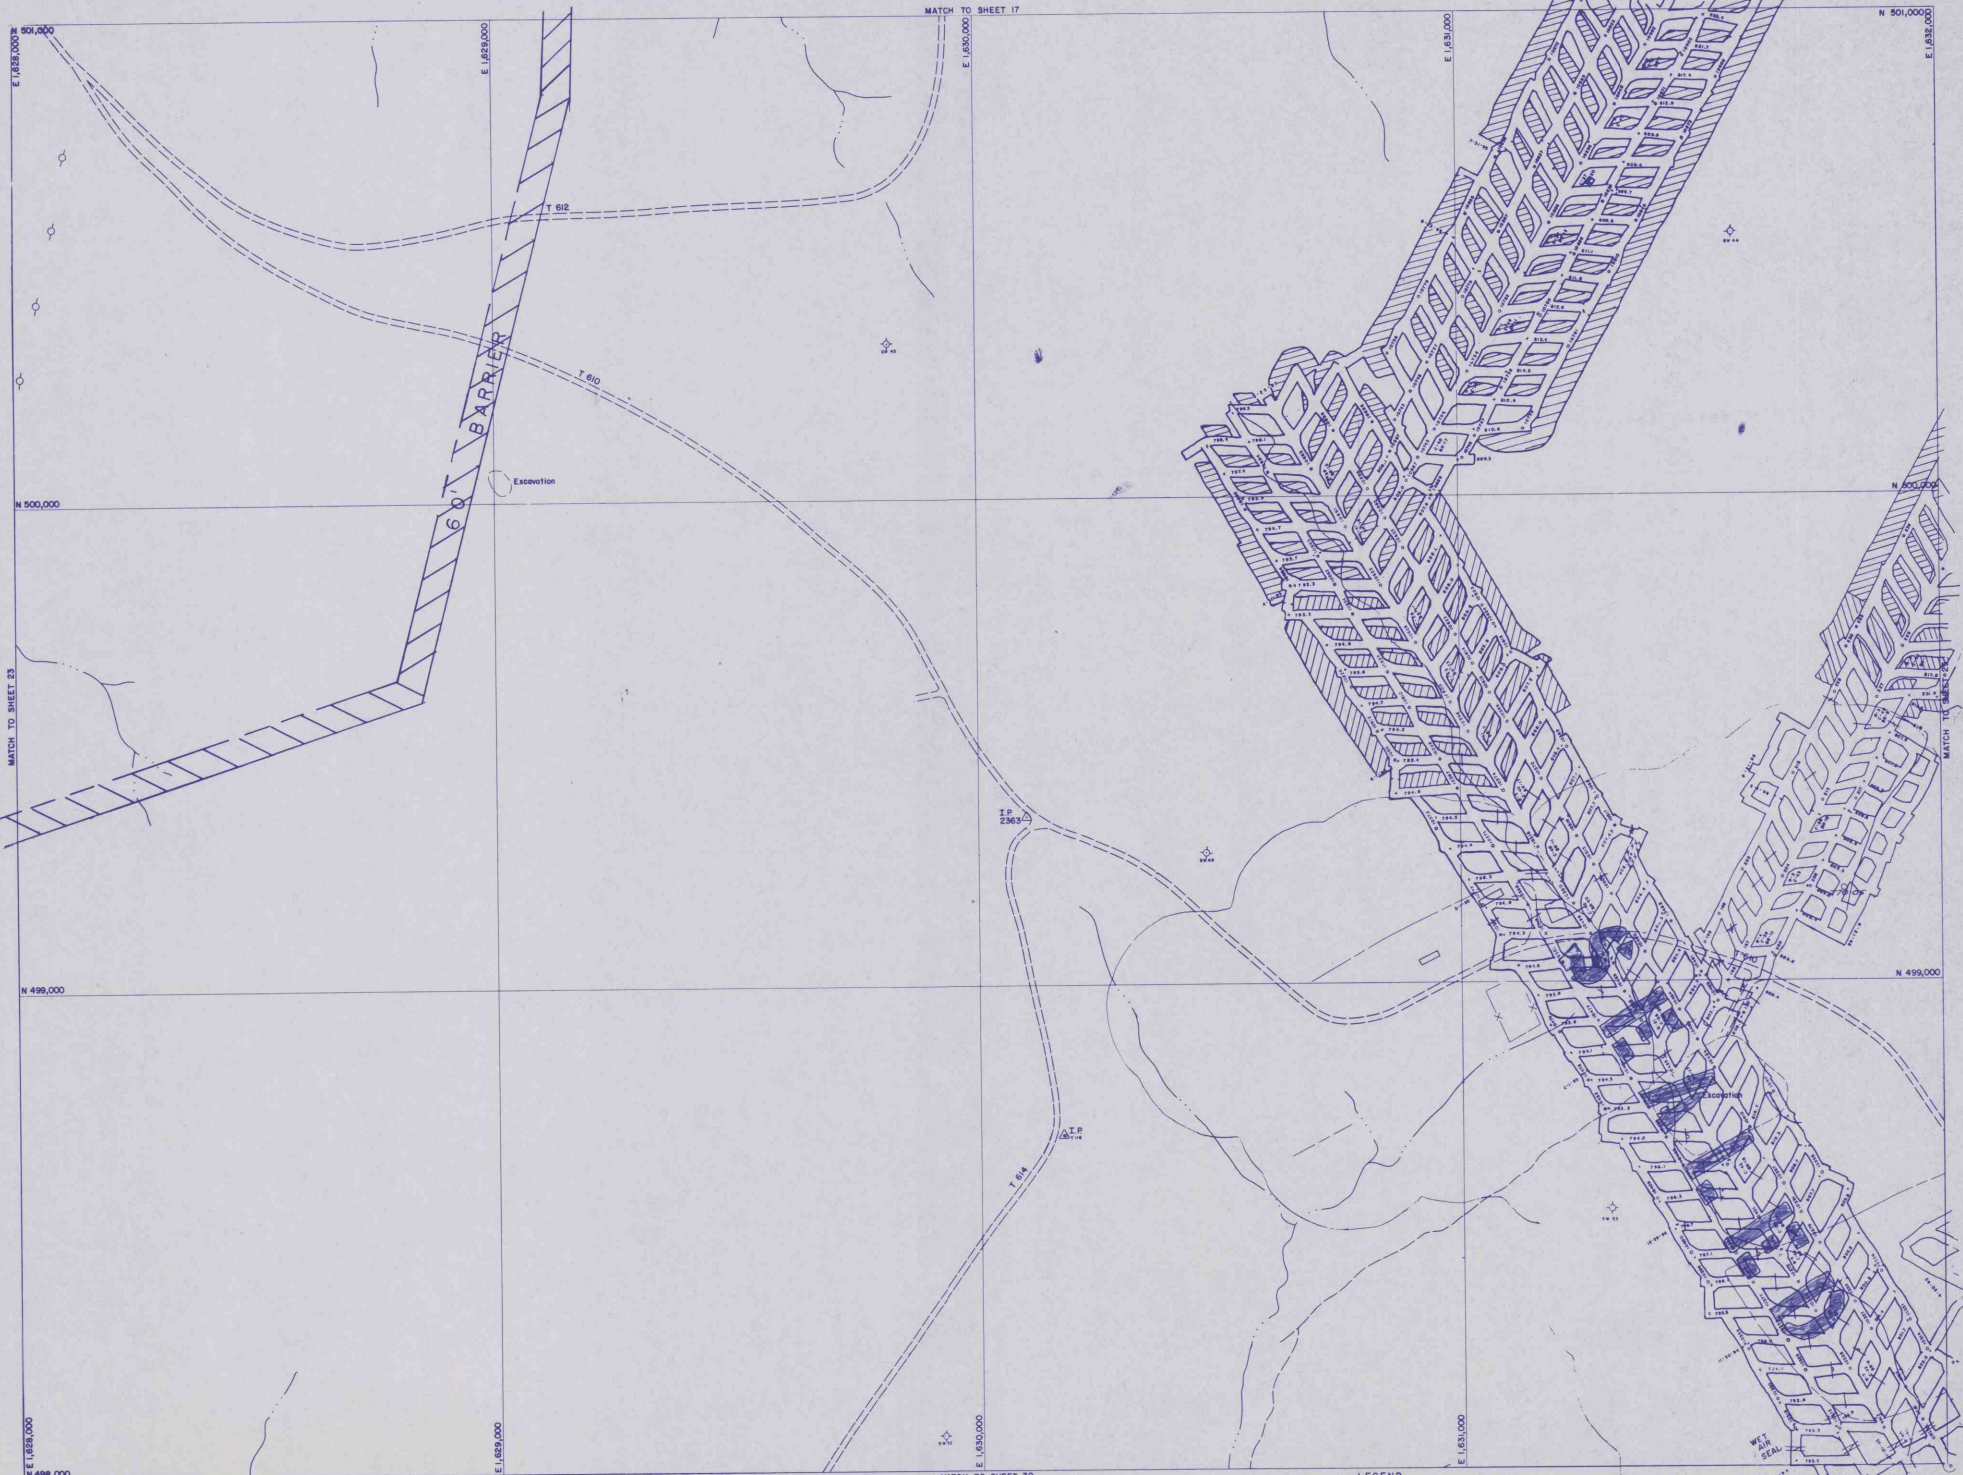

This map compiled from aerial photography taken April, 1979
 L. Robert Kibball, Consulting Engineers, Pennsylvania for
 BARNET & TUCKER COMPANY



- LEGEND
- MONUMENT & ELEVATION
 - △ MONUMENT
 - ⊙ PROPERTY CORNER
 - ⊕ GAS WELL
 - ⊙ IRON PIN
 - ⊙ DIAMOND & ROTARY
 - ⊙ DRILL HOLE

PLANIMETRIC MAP
 TANOMA MINE
 RAYNE TOWNSHIP, INDIANA CO. PA.
 SCALE: 1" = 100'