


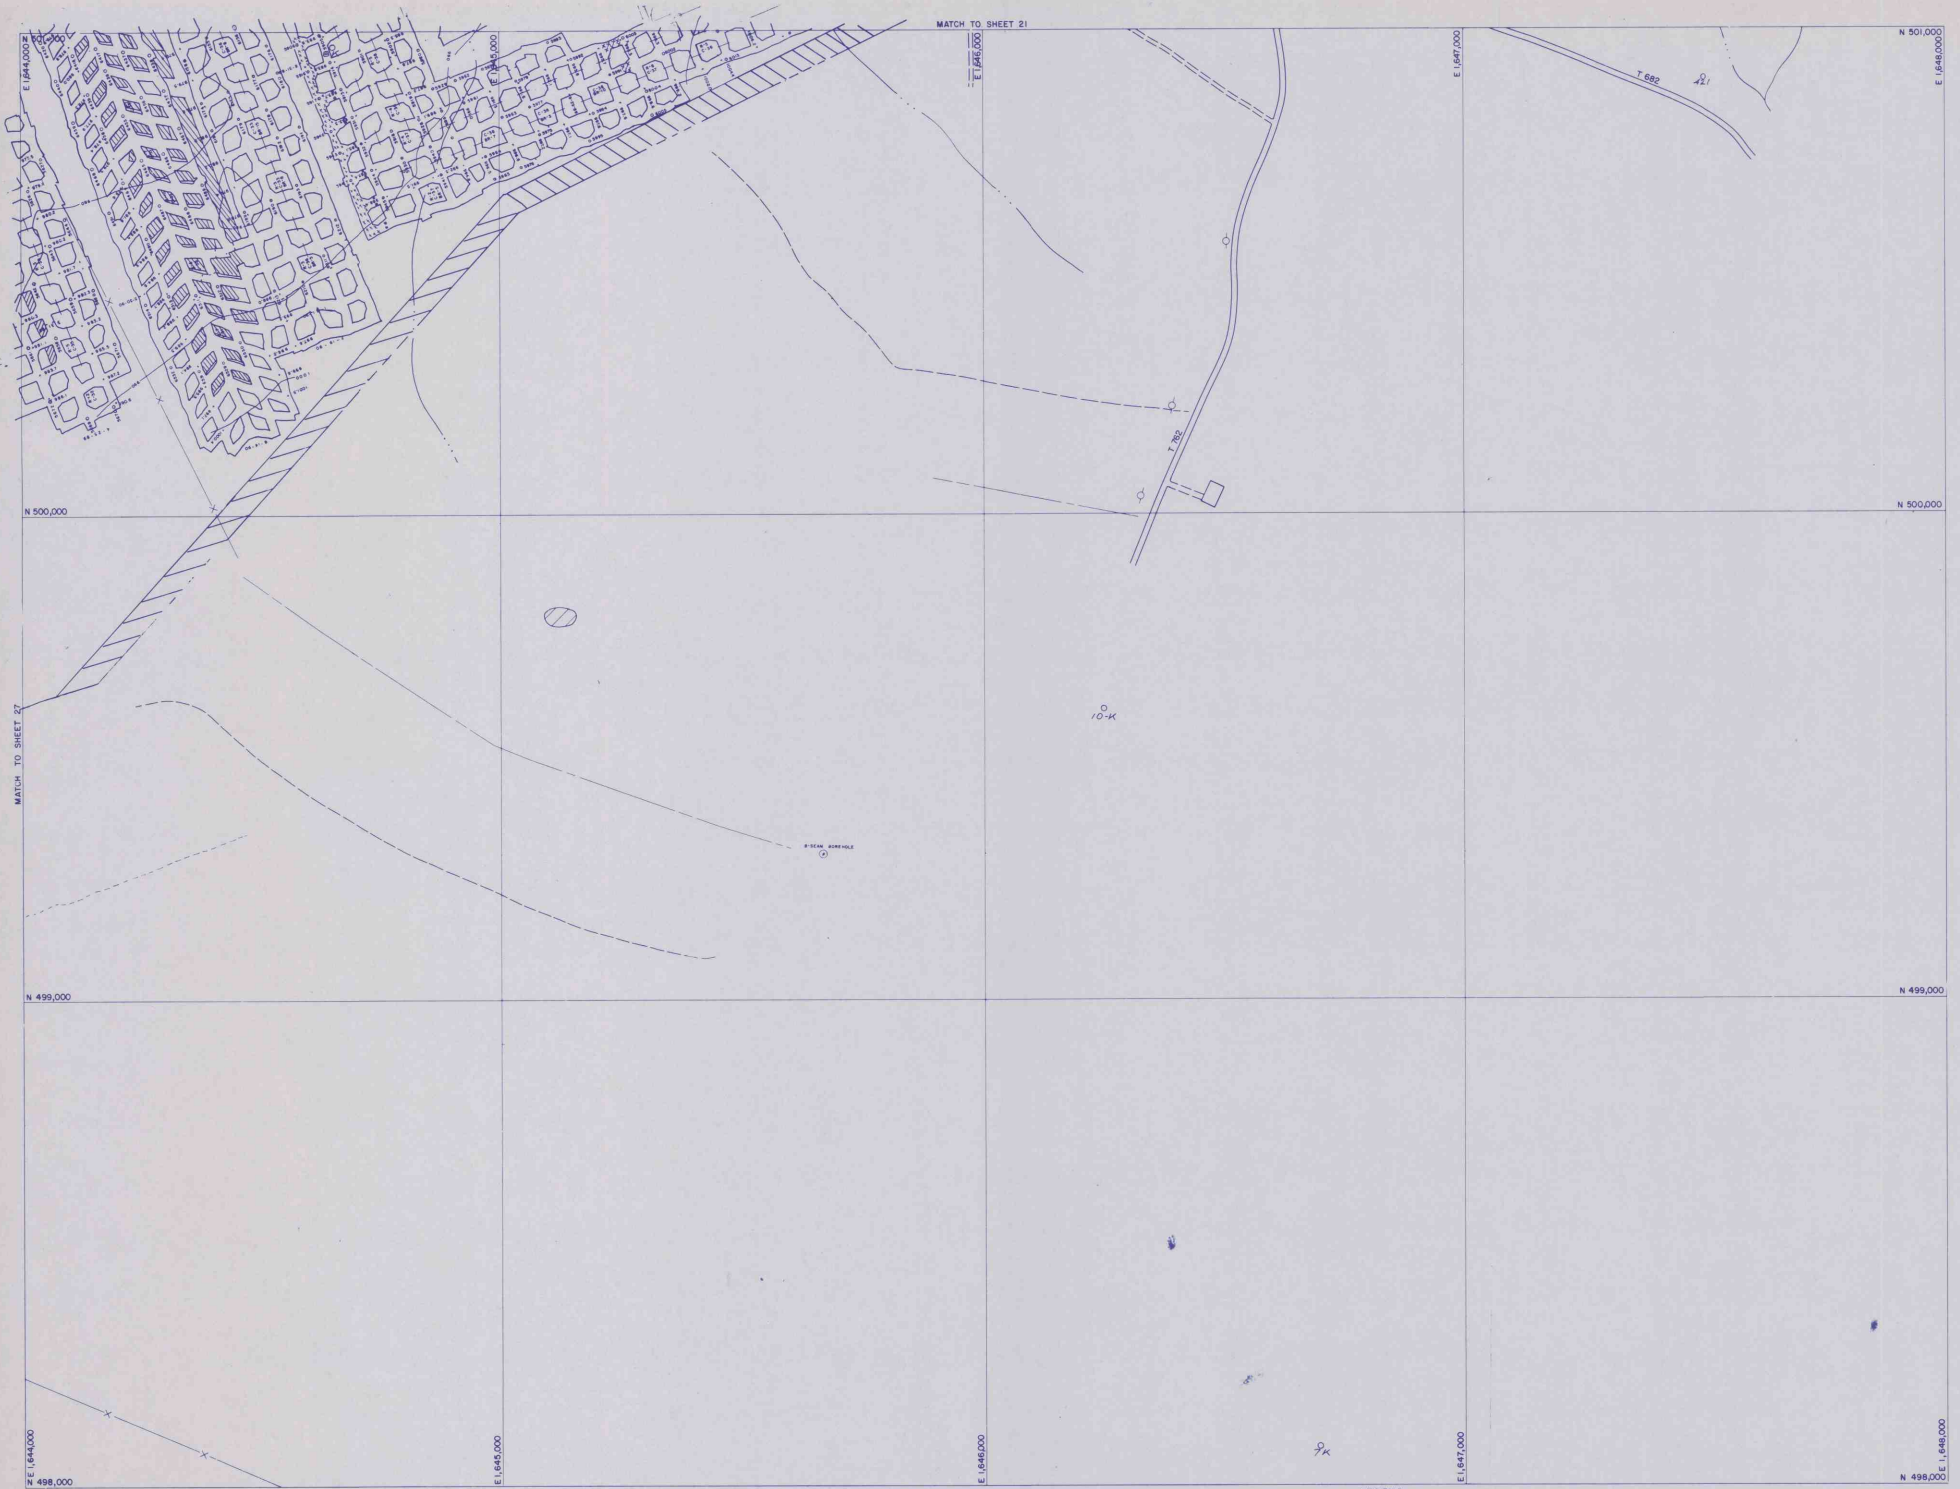

This map compiled from aerial photography taken April, 1979
 L. Robert Kimball, Consulting Engineers, Pennsylvania for
 BARNES & TUCKER COMPANY



- LEGEND
- MONUMENT & ELEVATION
 - △ MONUMENT
 - ⊙ PROPERTY CORNER
 - ⊕ GAS WELL
 - △ IRON PIN
 - ⊙ DIAMOND & ROTARY DRILL HOLE

PLANIMETRIC MAP
TANOMA MINE
 RAYNE TOWNSHIP, INDIANA CO. PA.
 28 OF 59