


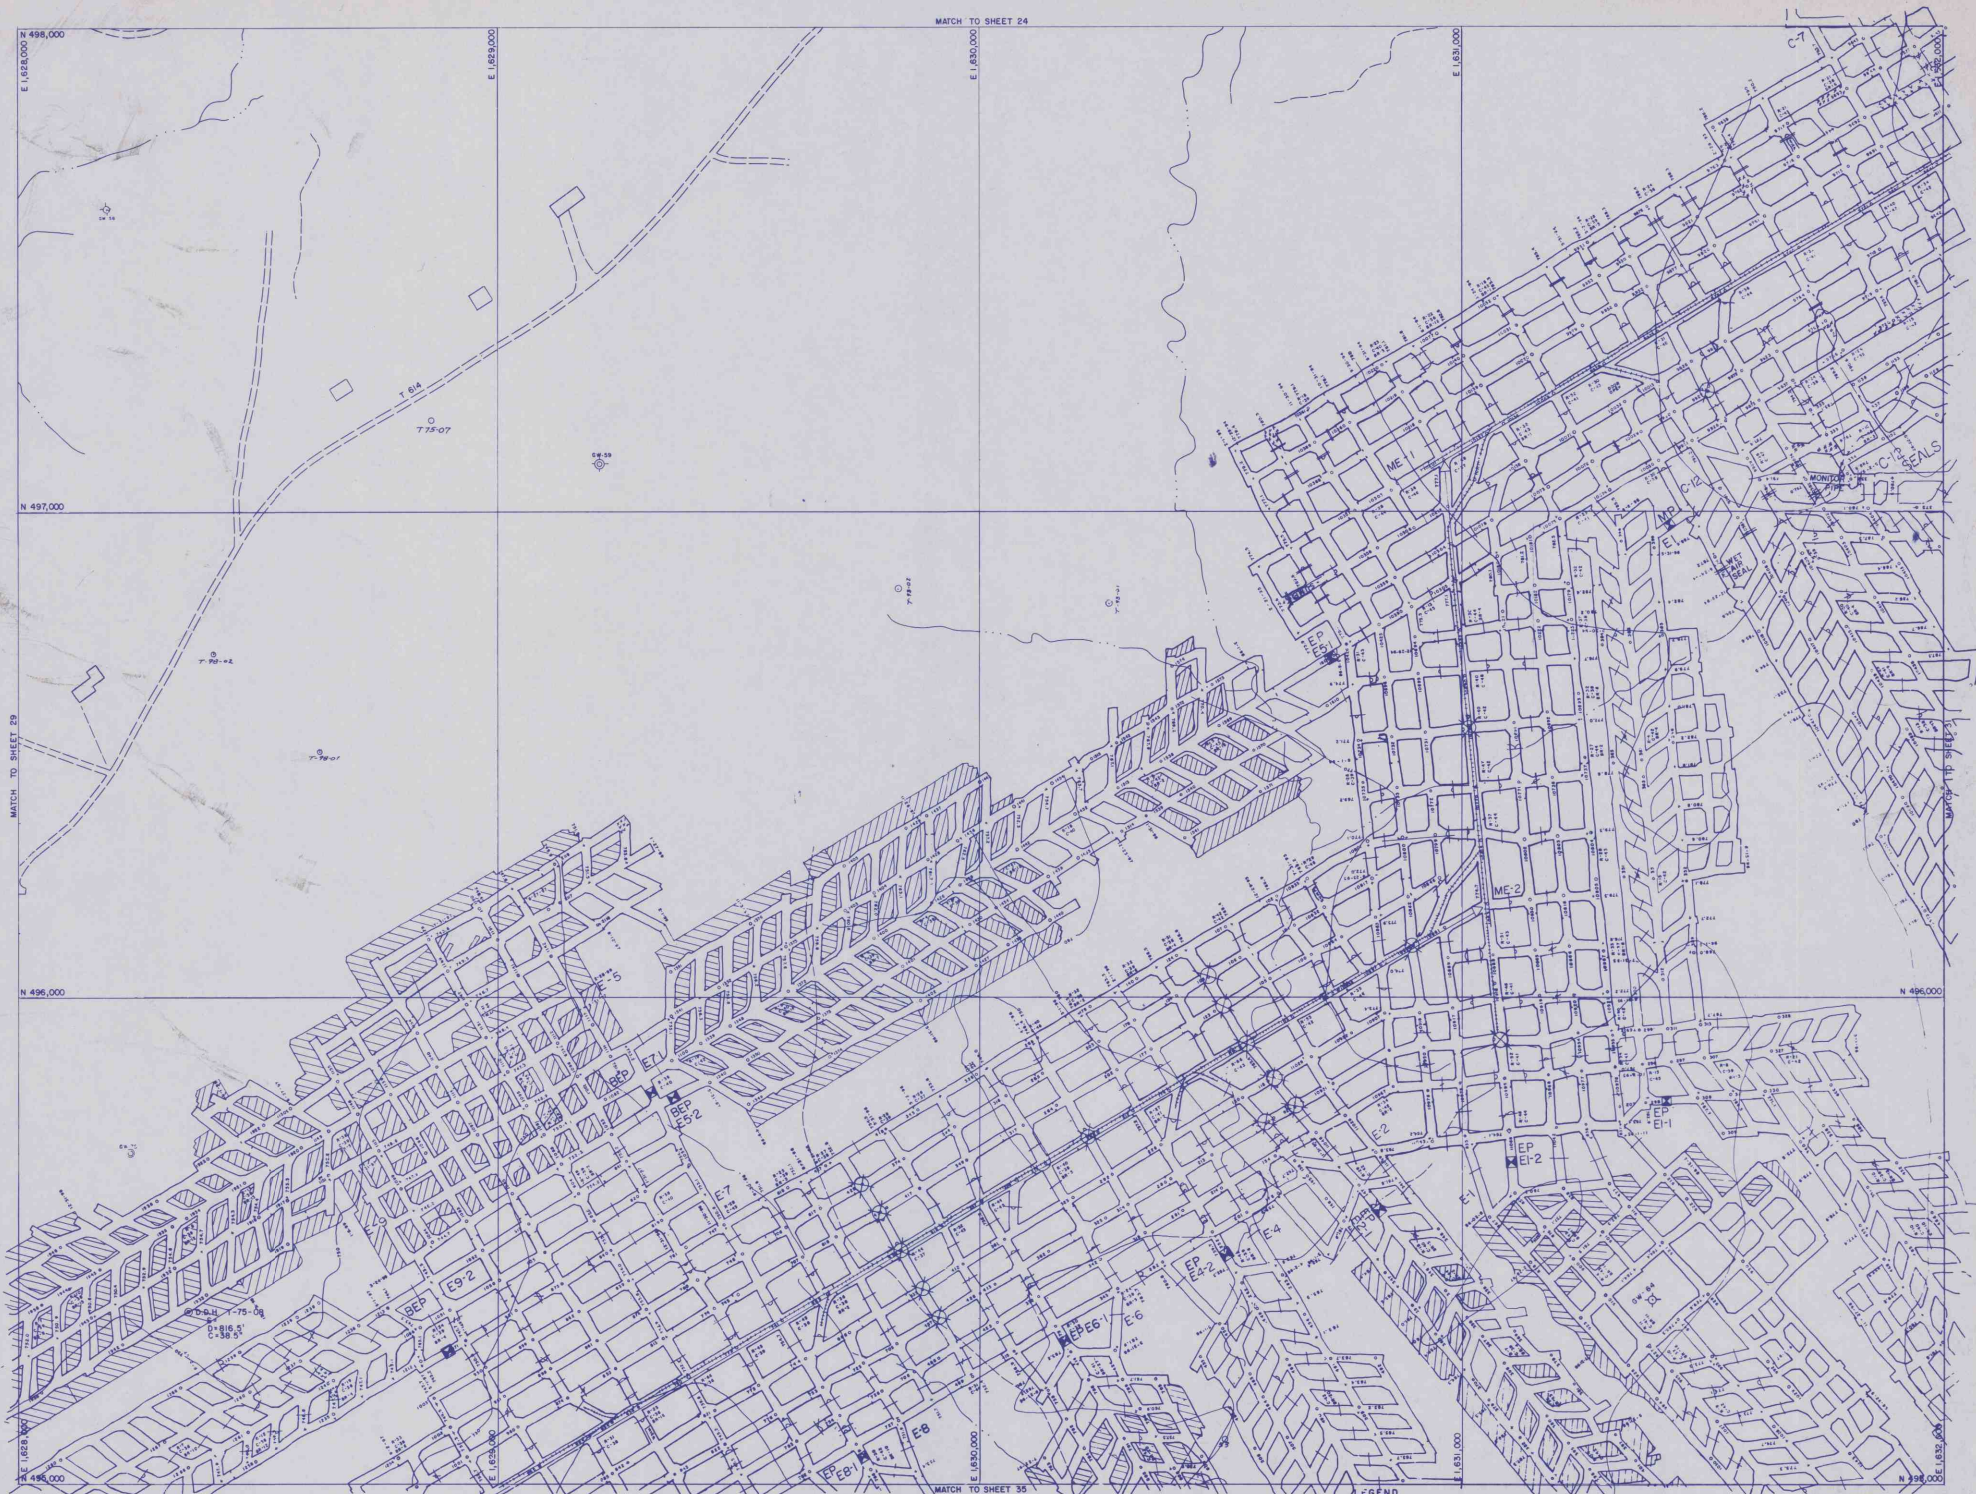

This map compiled from aerial photography taken April, 1979
 L. Robert Kimball, Consulting Engineers, Pennsylvania for
 BARNES & TUCKER COMPANY



LEGEND
 ○ MONUMENT & ELEVATION
 △ MONUMENT
 ● PROPERTY CORNER
 ⊕ GAS WELL
 △ IRON PIN
 ⊕ DIAMOND & ROTARY DRILL HOLE

PLANIMETRIC MAP
 TANOMA MINE
 RAYNE TOWNSHIP, INDIANA CO. PA.
 SCALE: 1" = 30'