


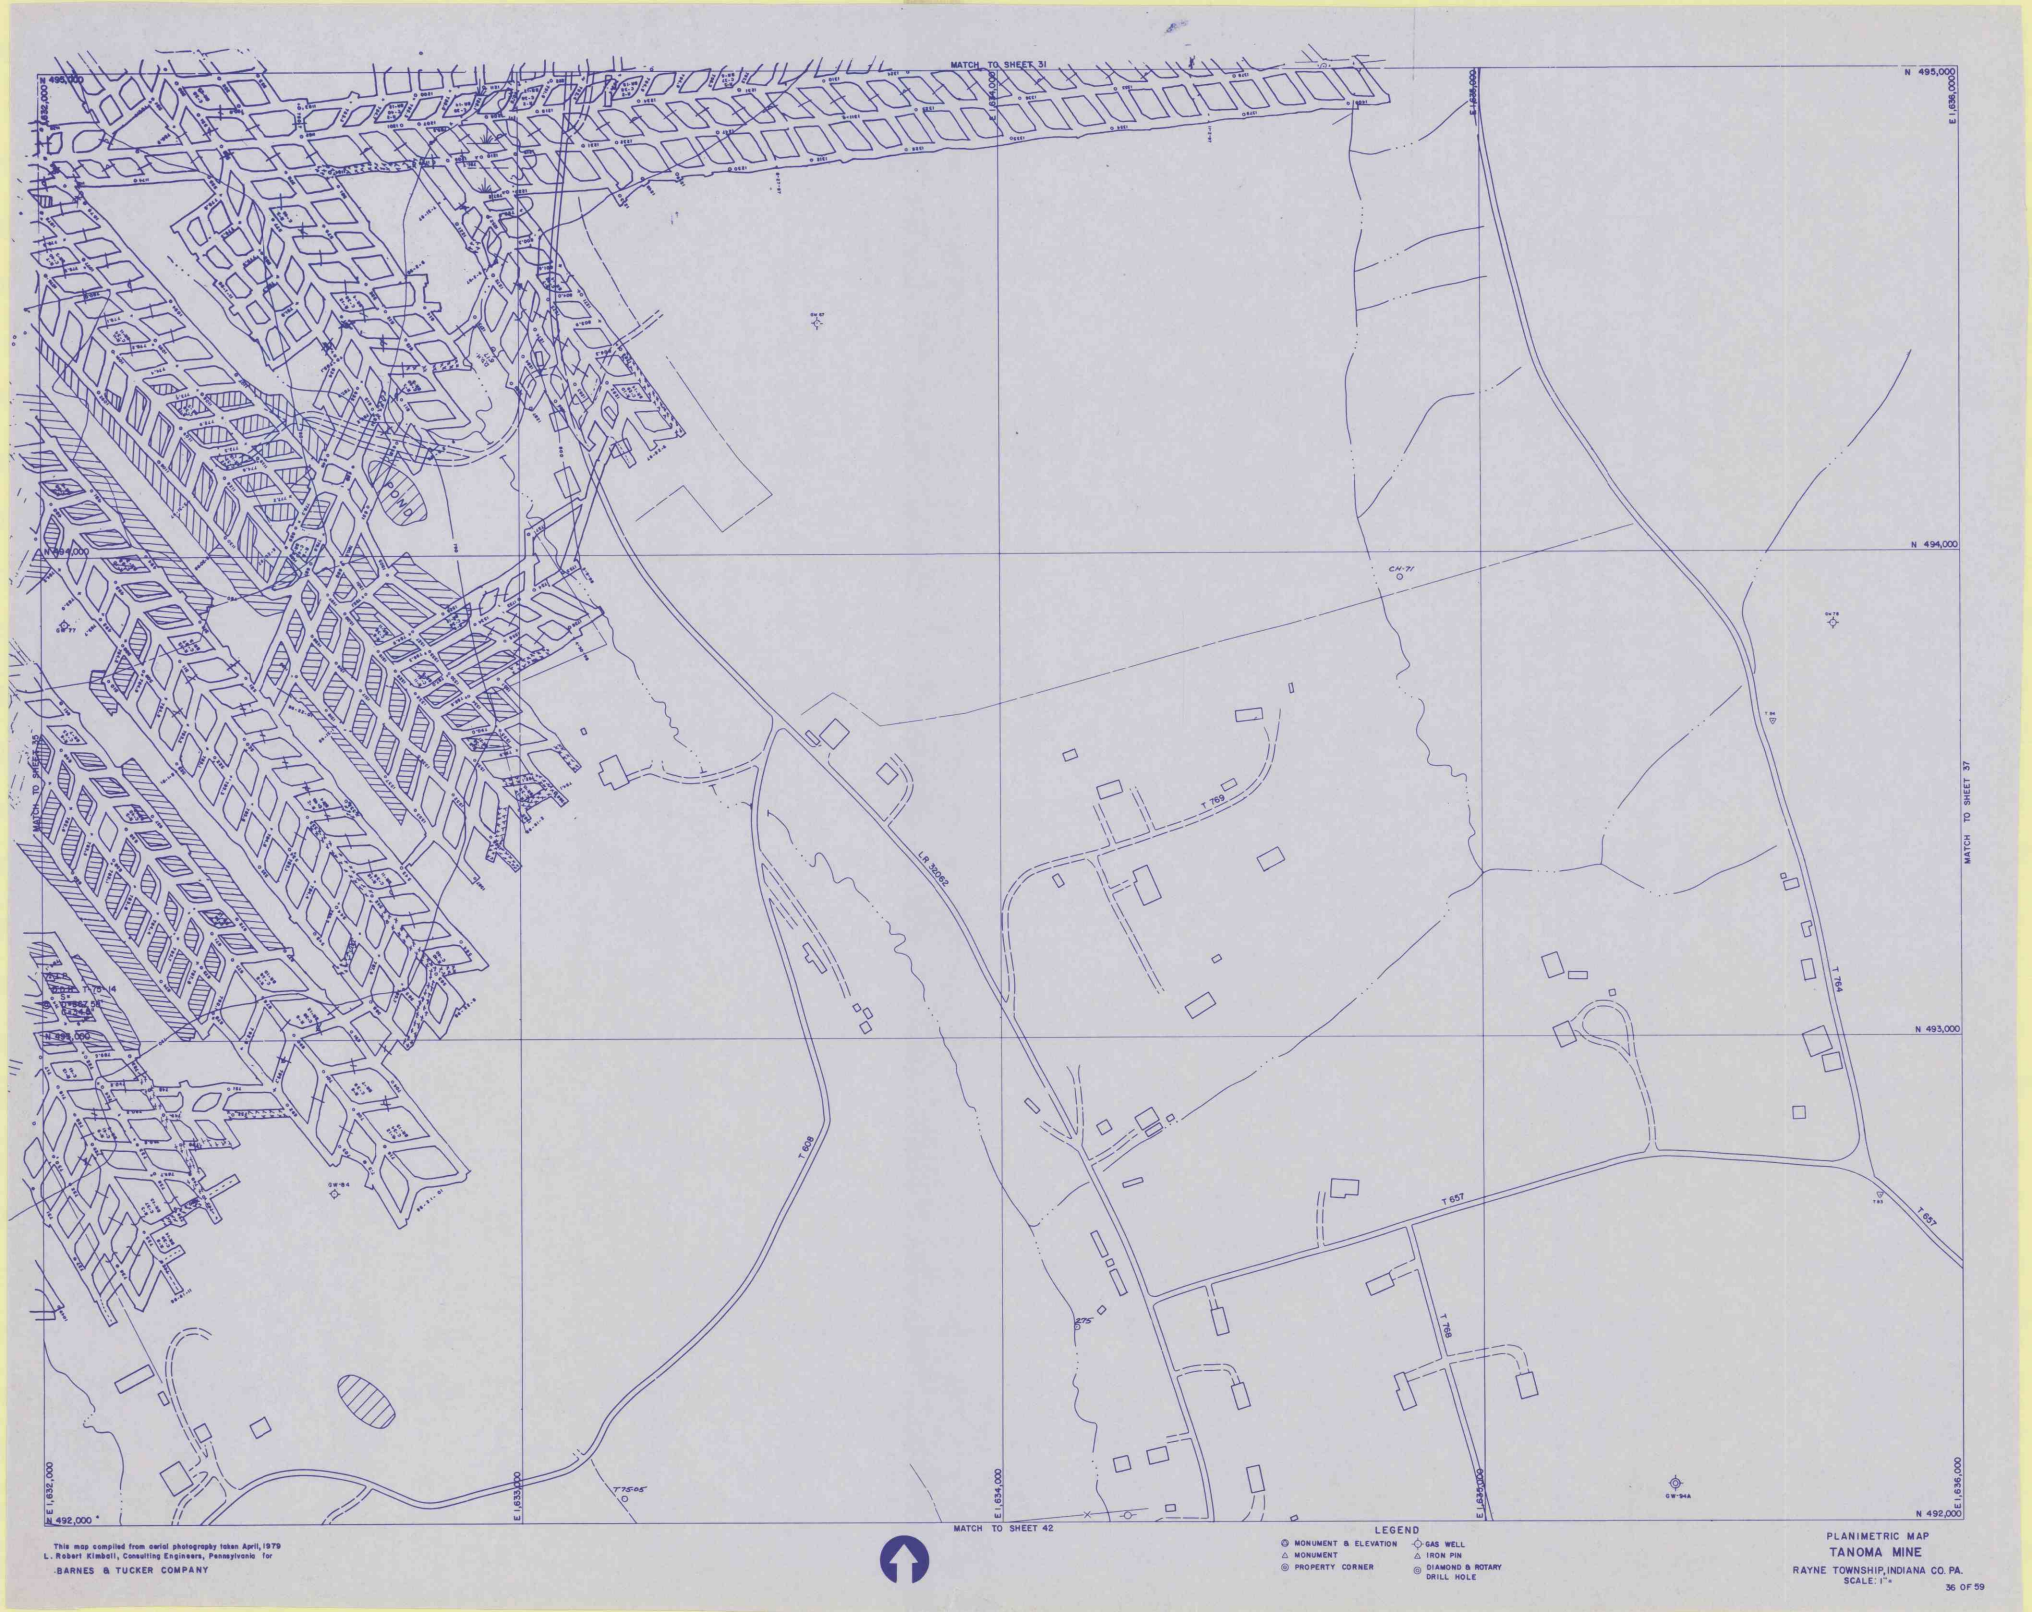

This map compiled from aerial photography taken April, 1979
L. Robert Kimball, Consulting Engineers, Pennsylvania for
BARNES & TUCKER COMPANY

- LEGEND
- MONUMENT & ELEVATION
 - △ MONUMENT
 - ⊙ PROPERTY CORNER
 - ⊙ GAS WELL
 - △ IRON PIN
 - ⊙ DIAMOND & ROTARY DRILL HOLE

PLANIMETRIC MAP
TANOMA MINE
RAYNE TOWNSHIP, INDIANA CO. PA.
SCALE: 1" = 100' FEET