



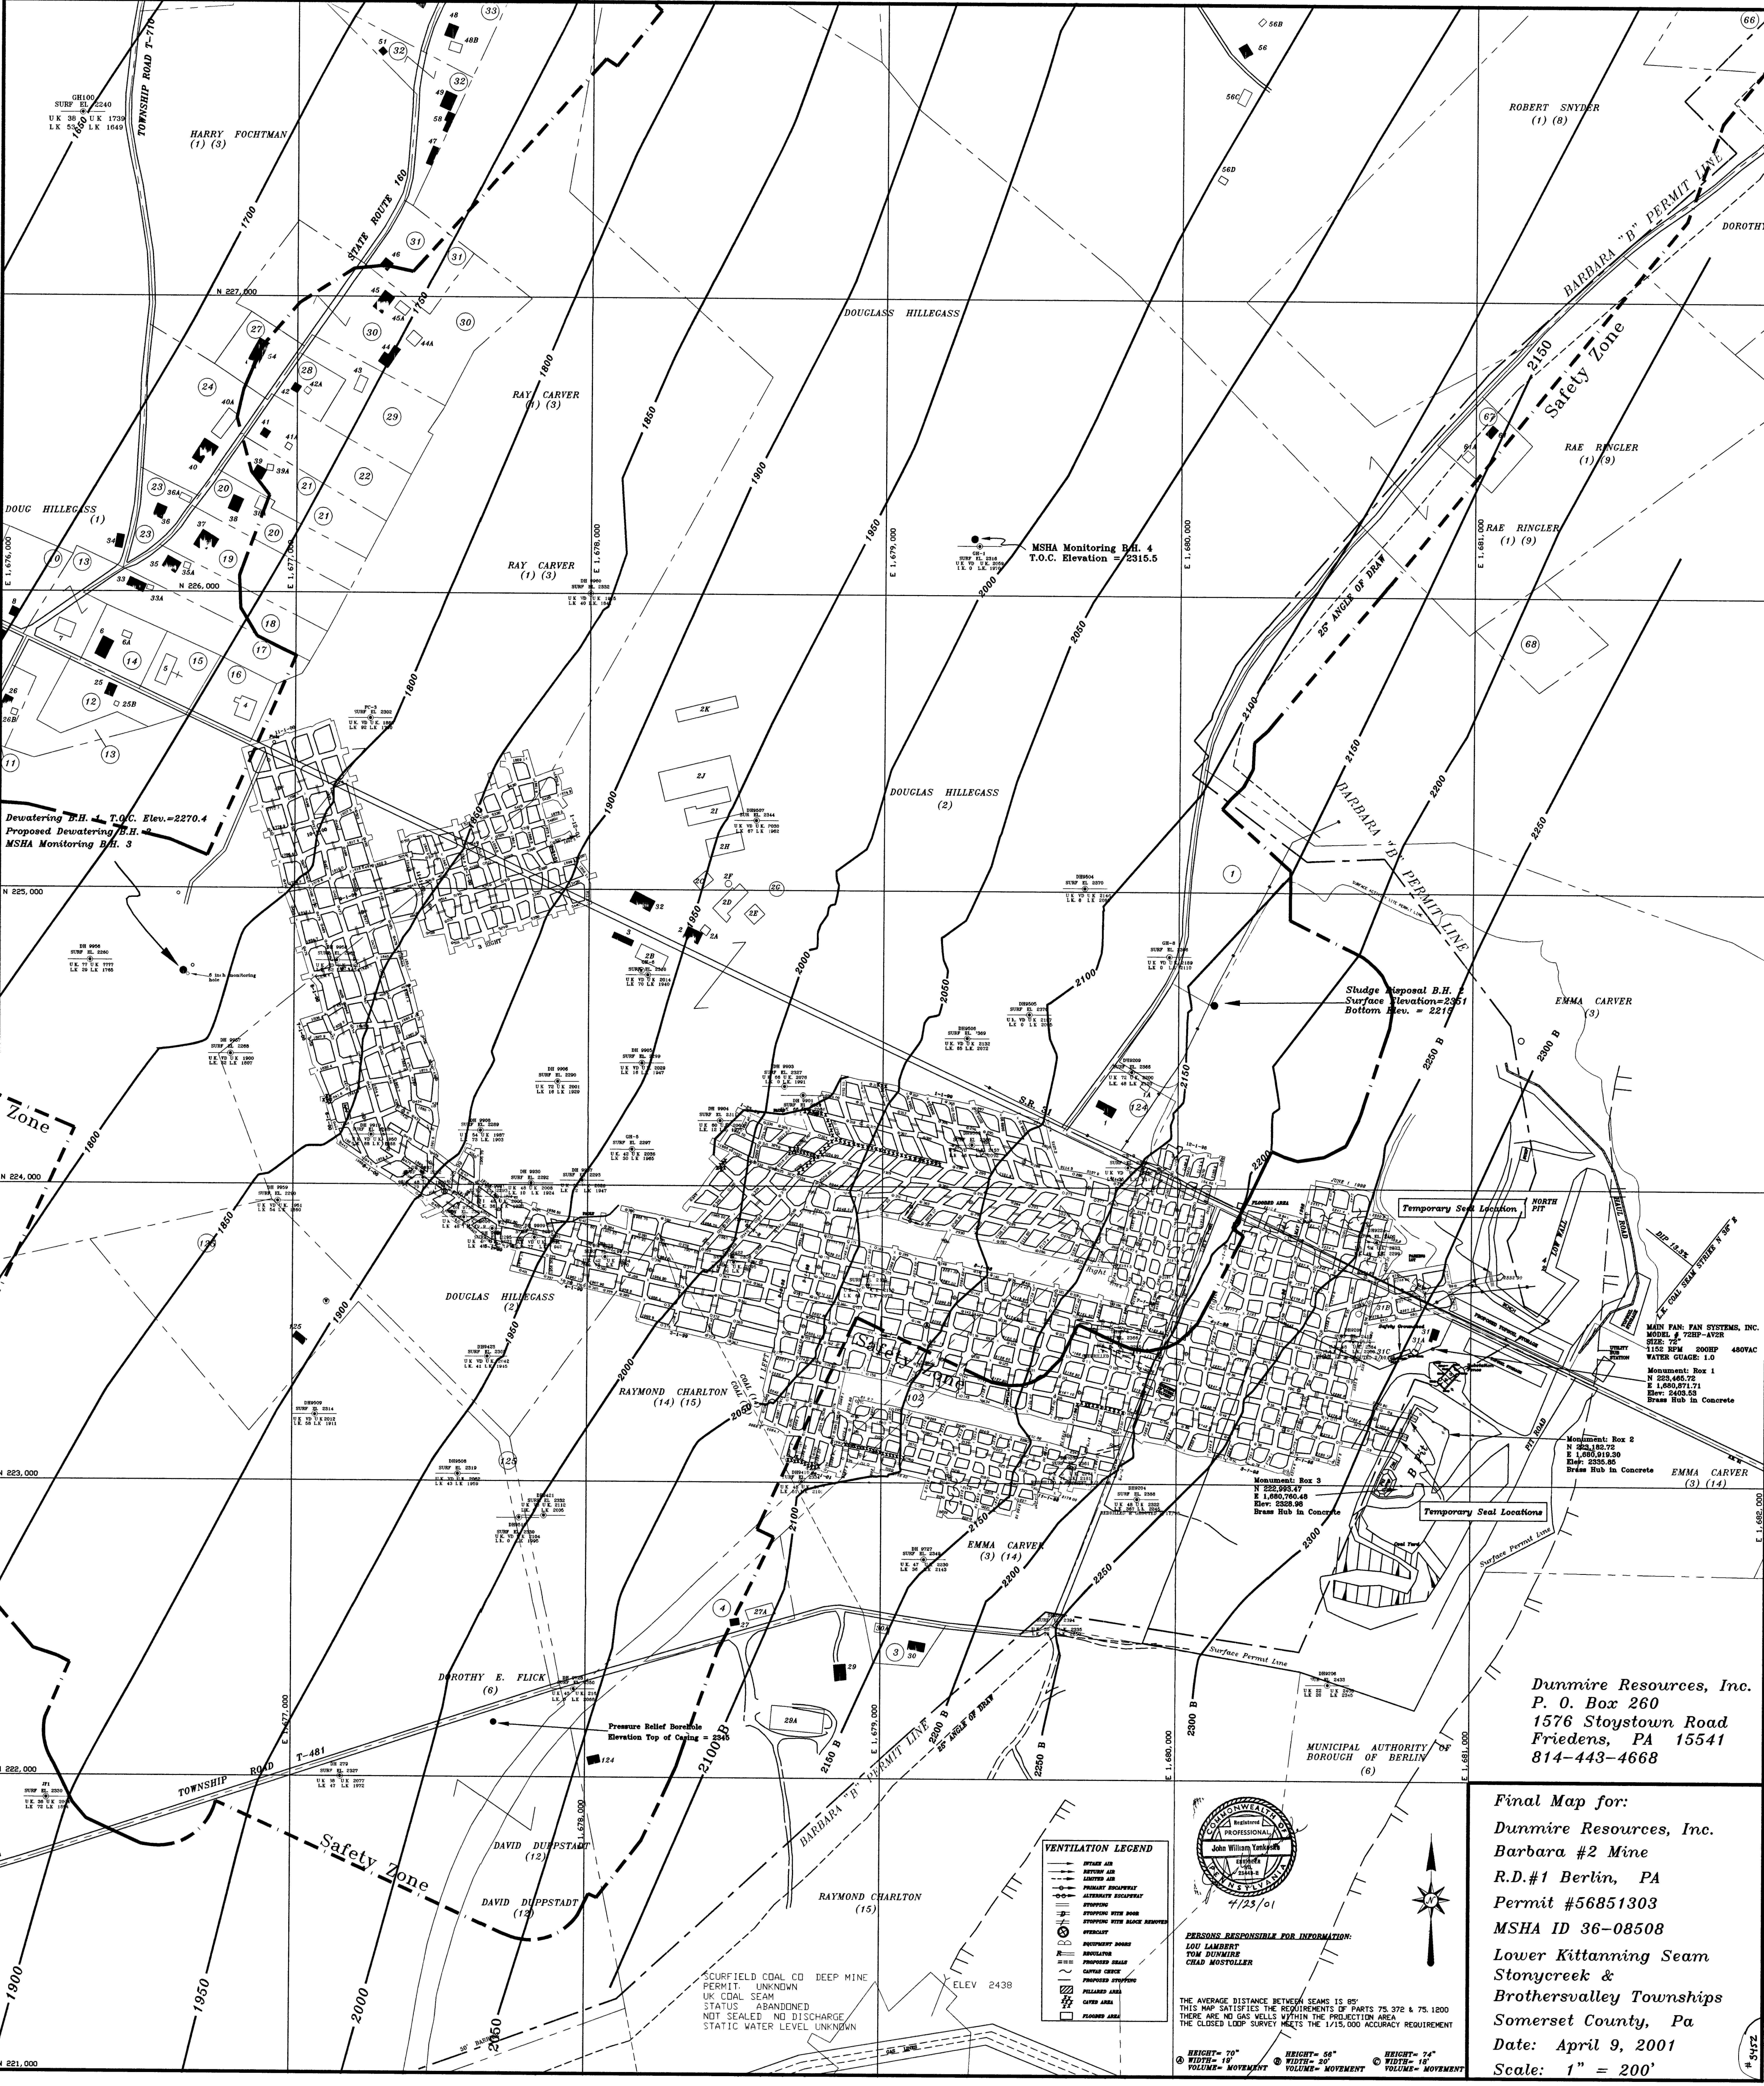

Dunmire Resources, Inc.
P. O. Box 260
1576 Stonycreek Road
Friedens, PA 15541
814-443-4668

Final Map for:
Dunmire Resources, Inc.
Barbara #2 Mine
R.D.#1 Berlin, PA
Permit #56851303
MSHA ID 36-08508
Lower Kittanning Seam
Stonycreek &
Brothersvalley Townships
Somerset County, Pa
Date: April 9, 2001
Scale: 1" = 200'

- VENTILATION LEGEND**
- RETURN AIR
 - EXHAUST AIR
 - PROBABLE SCALING
 - ALTERNATE SCALING
 - STOPPING
 - STOPPING WITH BLACK REMOVAL
 - OVERCUT
 - SCOURFIELD COAL CO. DEEP MINE PERMIT - UNKNOWN
 - UK COAL SEAM
 - STATUS - ABANDONED
 - NOT SEALED - NO DISCHARGE
 - STATIC WATER LEVEL UNKNOWN

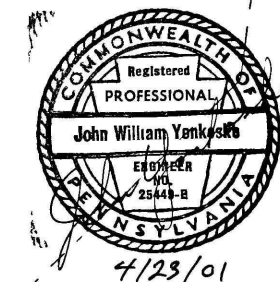

PERSONS RESPONSIBLE FOR INFORMATION:
LOU LAMBERT
TOM DUNMIRE
CHAD MOSTOLLER

THE AVERAGE DISTANCE BETWEEN SEAMS IS 95'.
THIS MAP SATISFIES THE REQUIREMENTS OF PARTS 75.372 & 75.1800.
THERE ARE NO GAS WELLS WITHIN THE PROJECTION AREA.
THE CLOSED LDDP SURVEY MEETS THE 1/15,000 ACCURACY REQUIREMENT.

HEIGHT = 70' WIDTH = 10' VOLUME = MOVEMENT
HEIGHT = 50' WIDTH = 20' VOLUME = MOVEMENT
HEIGHT = 74' WIDTH = 10' VOLUME = MOVEMENT