





LEGEND

- Regulator
- Proposed Air Flows
- Intake Air
- Return Air
- Belt Air
- Belt Line
- Permanent Stopping
- Check Curtain
- Proposed Stopping
- Doors
- Equipment Doors
- Seals
- Survey Station
- Permit Boundary
- Property Line
- Public Road
- Stream
- Mining Completed Area
- Contemplated Mining Area
- Projected Mining TO
- Projection No
- Survey Date 11-1-00

ESCAPEWAYS

- Primary Escapeway
- Secondary Escapeway

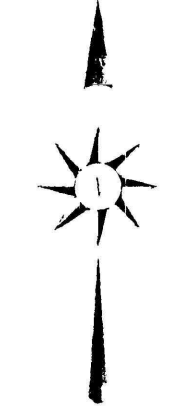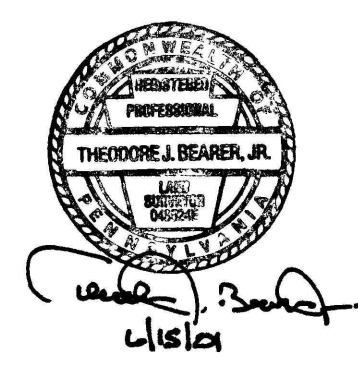

SHEET 1 OF 1
ROSEBUD MINING COMPANY
POS. BUD. NO. 2 MIN.
PERM. TWO - APR. 1900
LOWER KITTANING - AL. SEAM
SCALE 1" = 100'
FINAL MAP