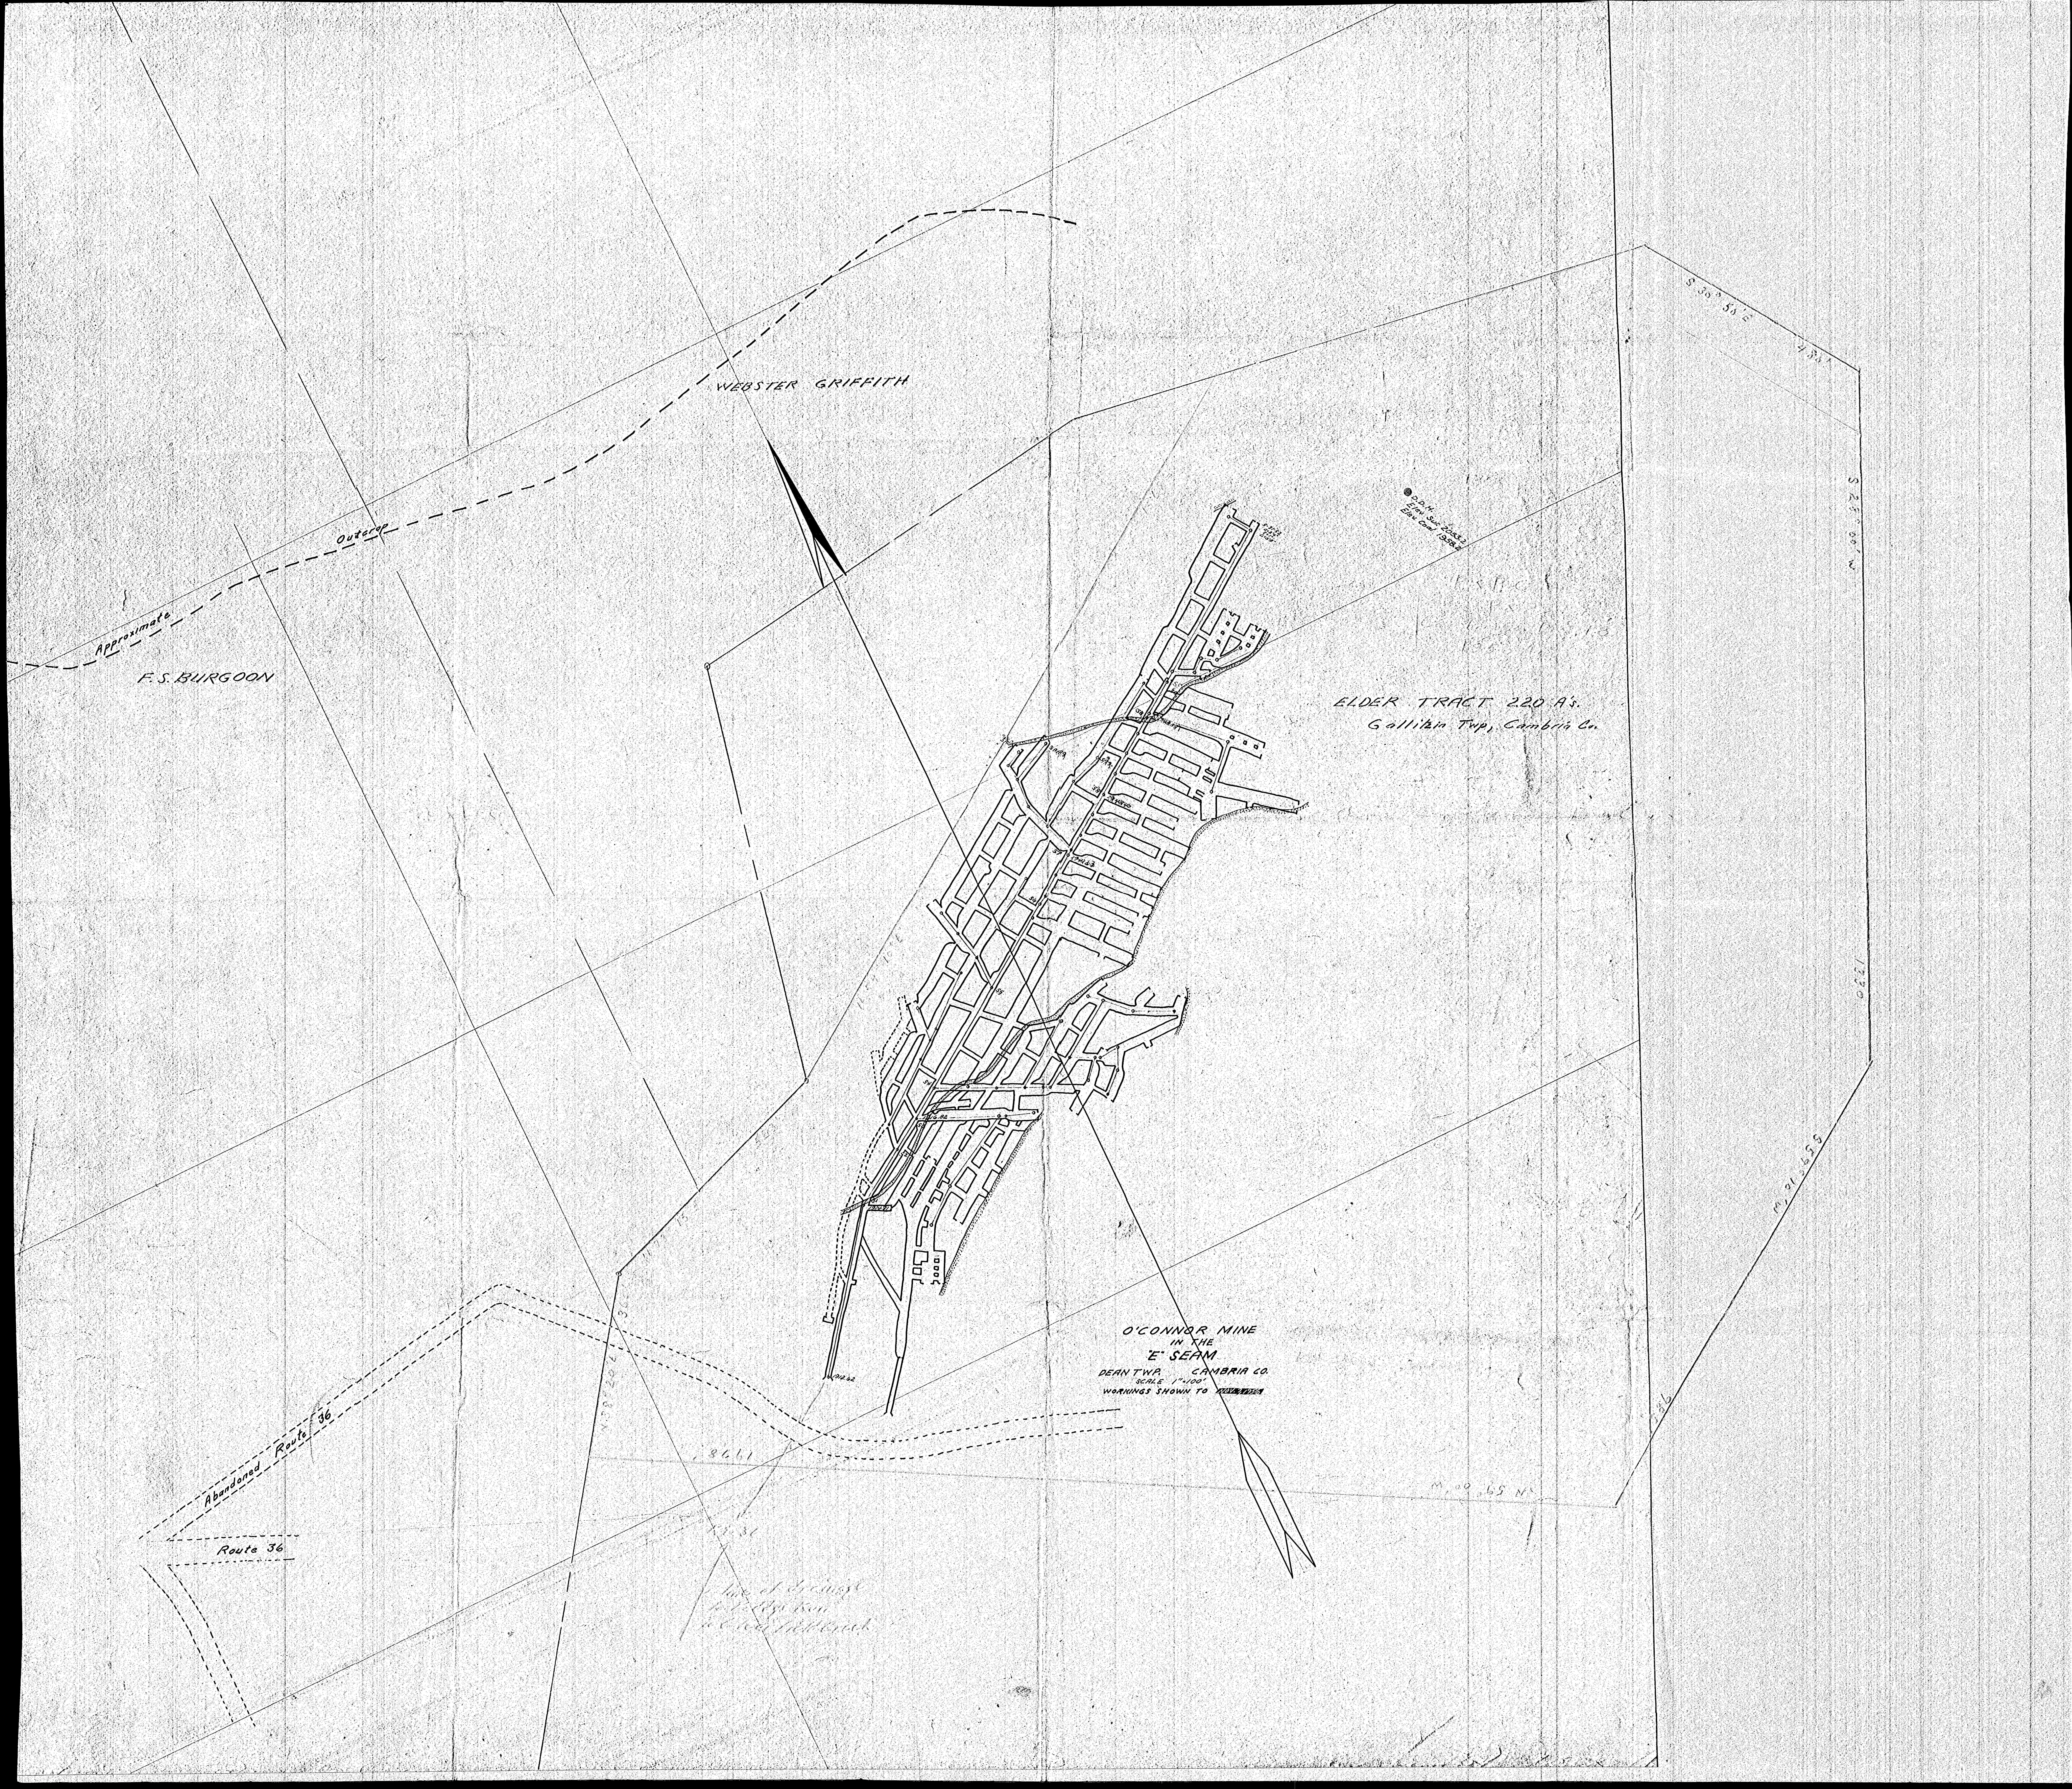

O'CONNOR MINE
IN THE
"E" SEAM
DEAN TWP. CAMBRIA CO.
SCALE 1" = 100'
WORKINGS SHOWN TO NOV. 2, 1956