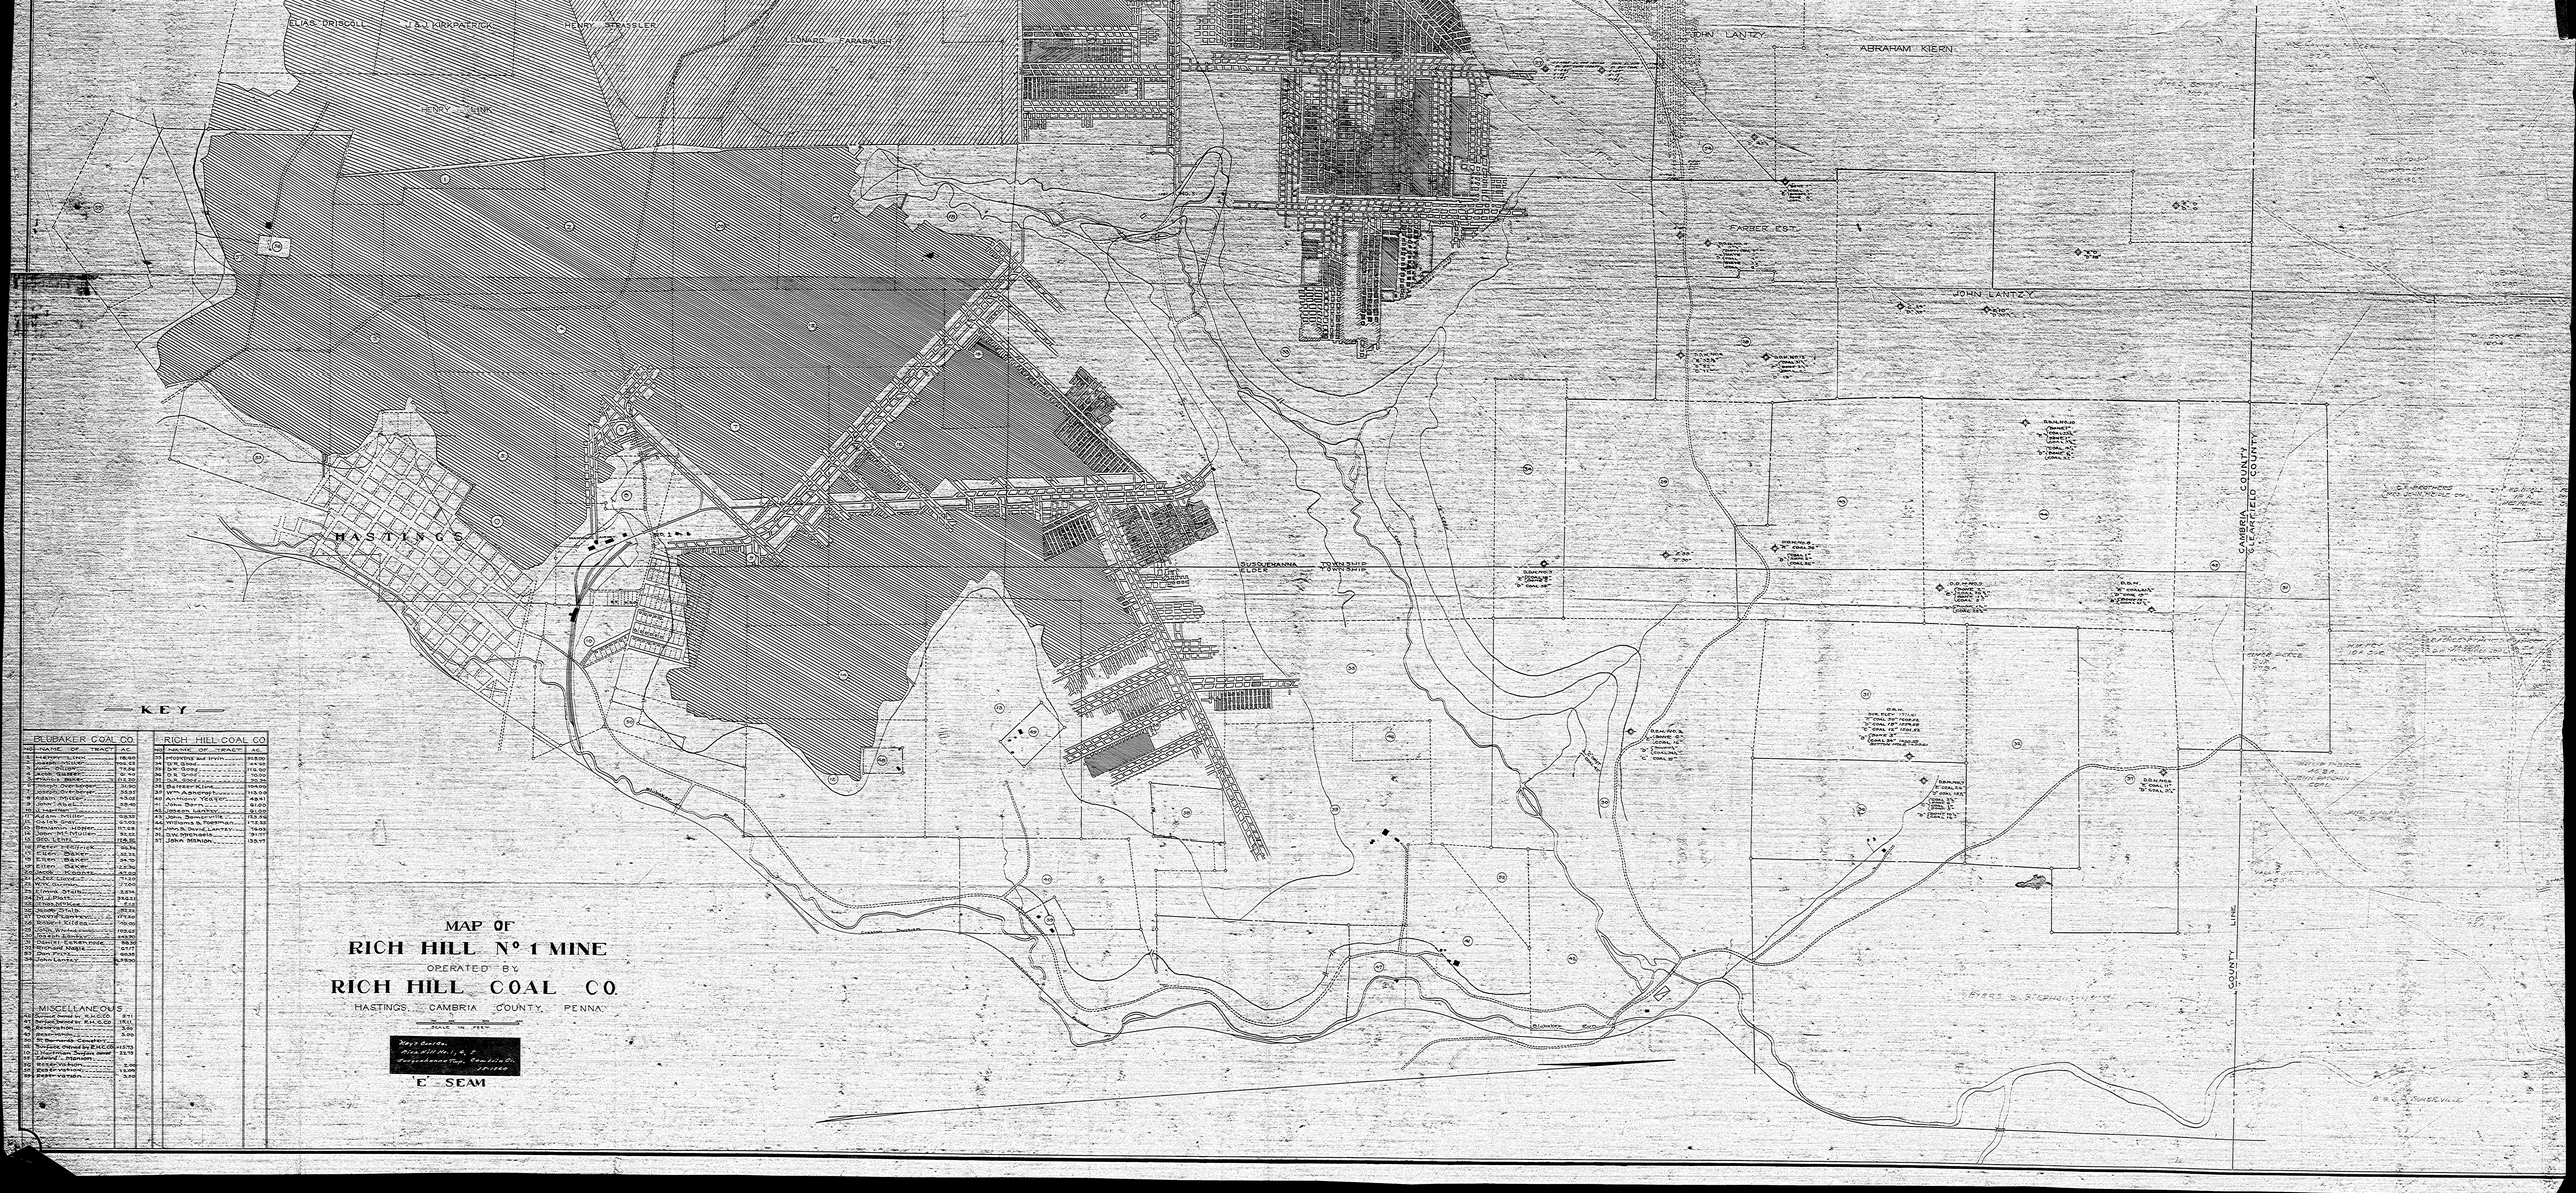
CLAS. DRISCOLL
W. & J. KIRKPATRICK
HENRY STASSLER
HENRY J. KIRK
JOHN LANTZY
ABRAHAM KIERN
FARBER EST.
JOHN LANTZY
HASTINGS
SUSQUEHANNA
TOWNSHIP
CAMBRIA COUNTY
CLEARFIELD COUNTY
COUNTY LINE
KEY
BLUBAKER COAL CO.
RICH HILL COAL CO.
MISCELLANEOUS
MAP OF
RICH HILL N° 1 MINE
OPERATED BY
RICH HILL COAL CO
HASTINGS CAMBRIA COUNTY PENNA
SCALE IN FEET
"E" SEAM