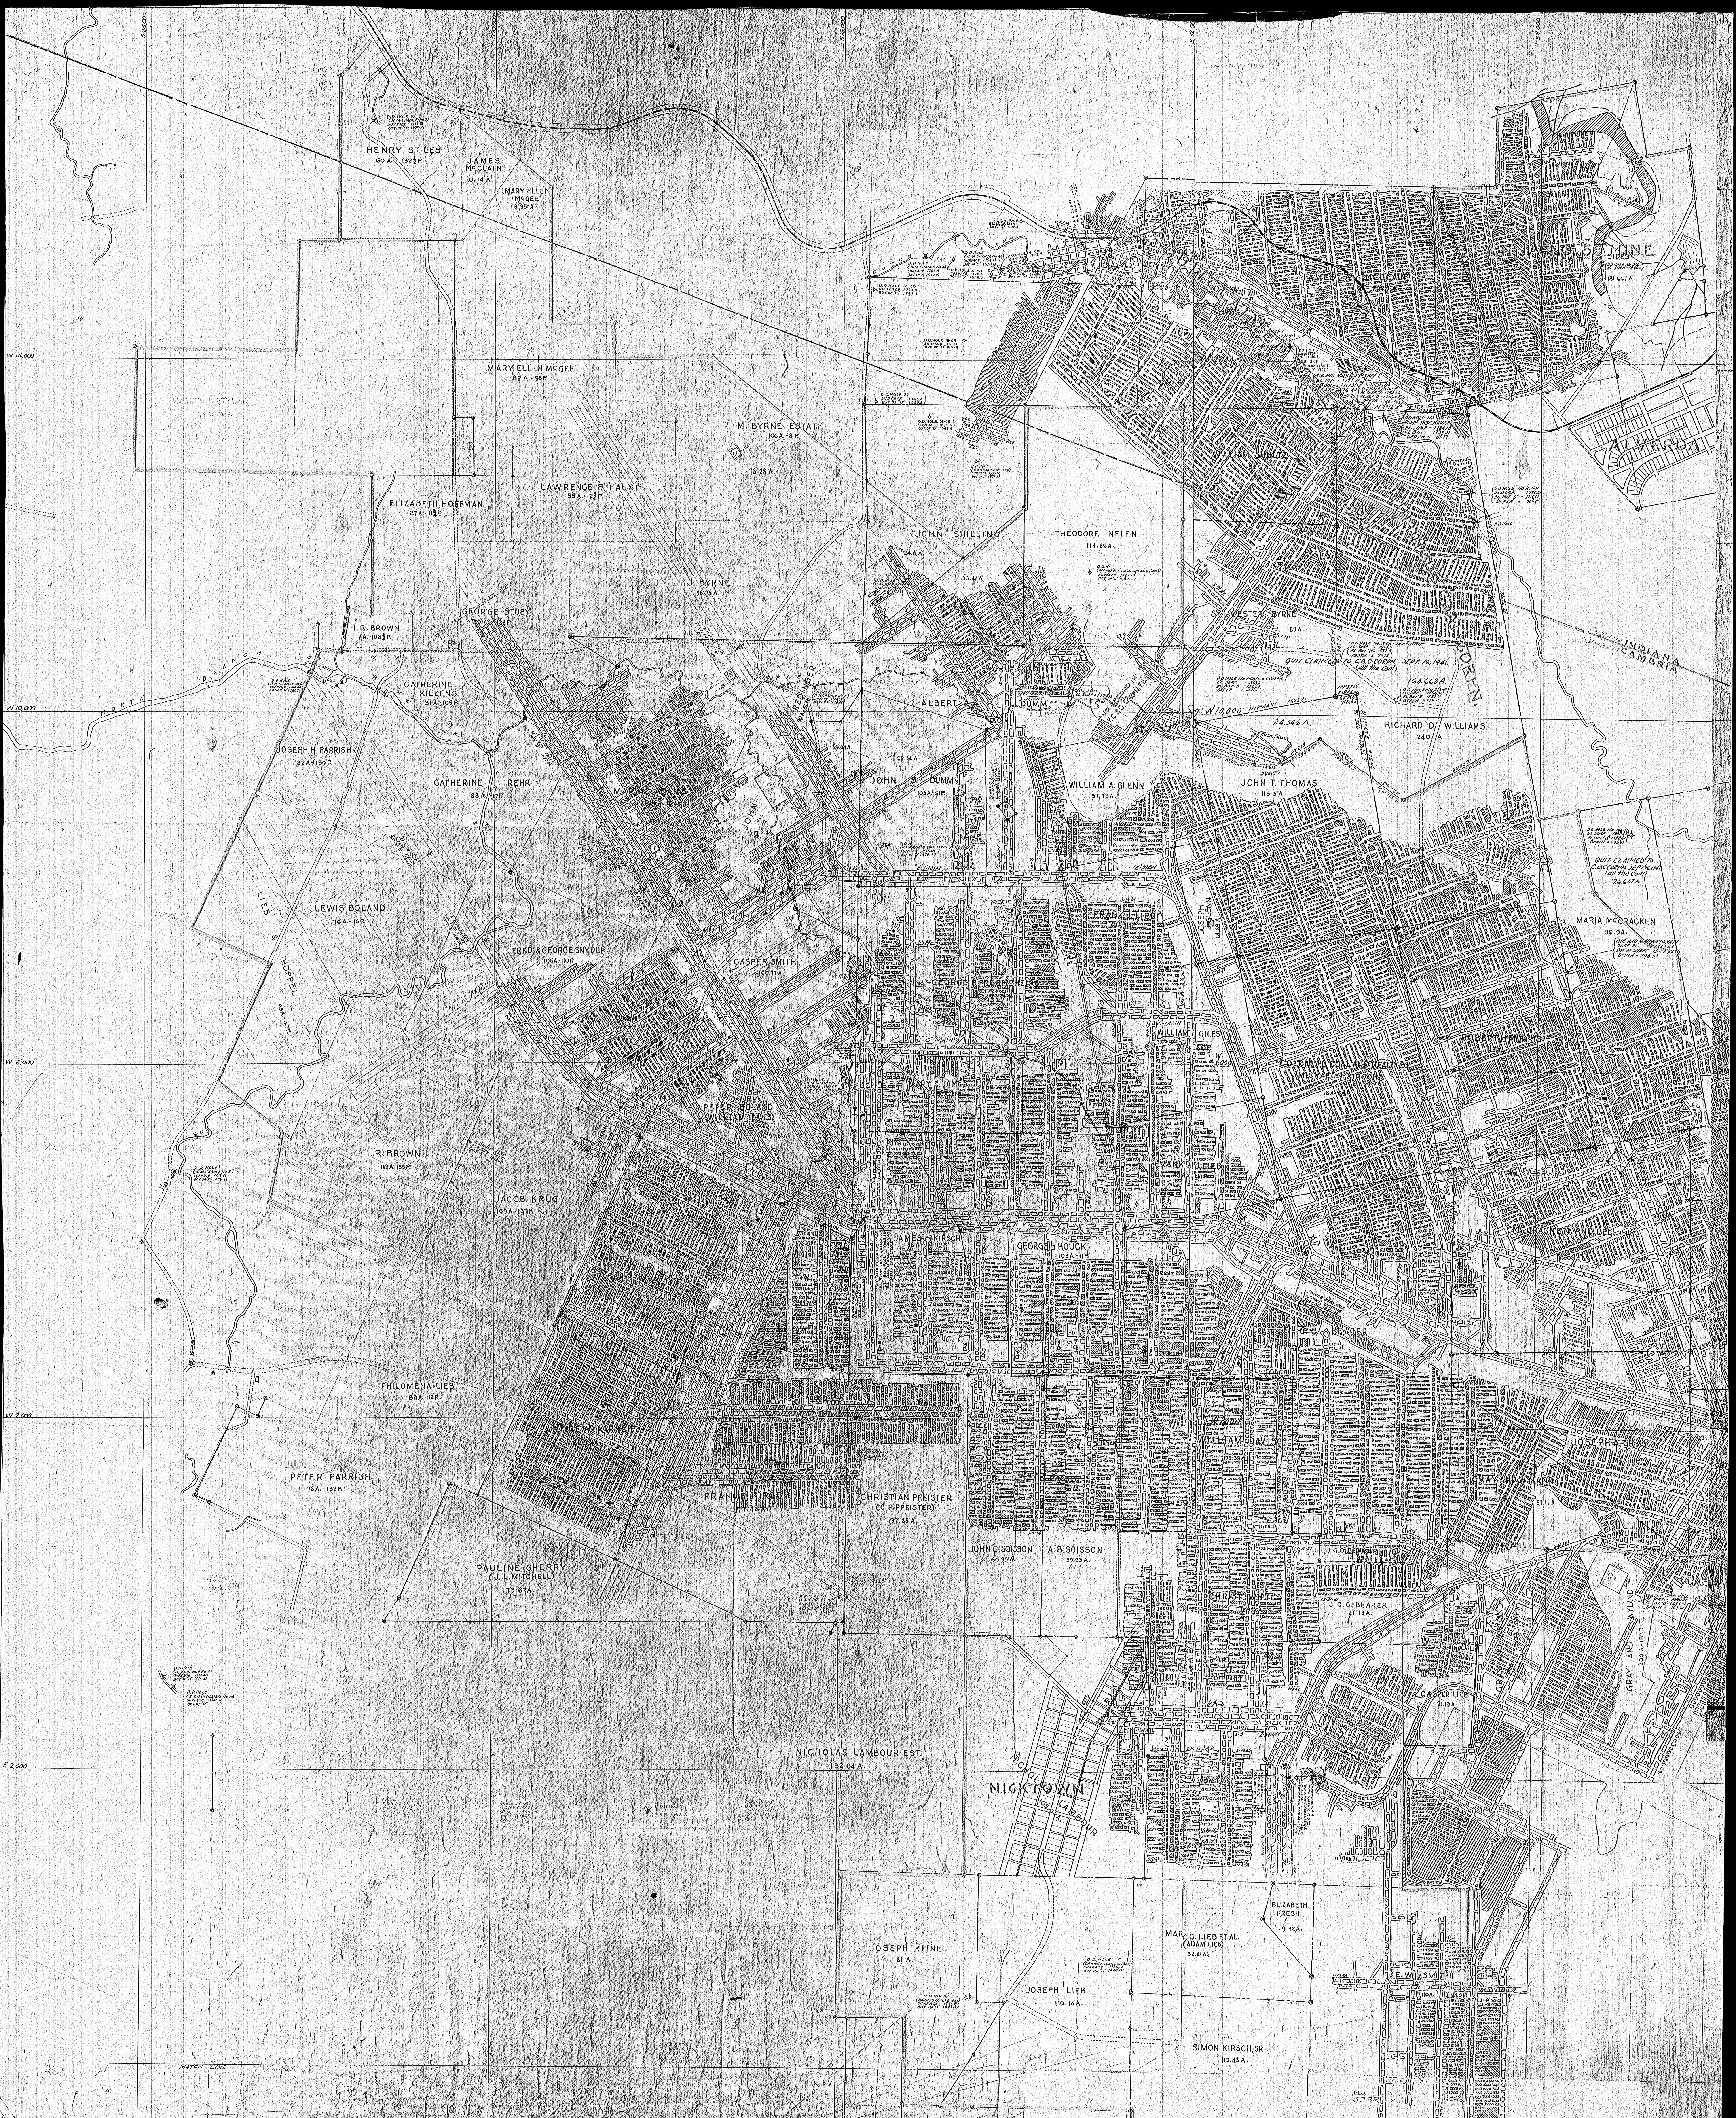
HENRY STILES
60 A. 132½ P.
JAMES McCLAIN
10.74 A.
MARY ELLEN McGEE
13.95 A.
MARY ELLEN McGEE
82 A. - 93 P.
M. BYRNE ESTATE
106 A. - 8 P.
78.28 A.
LAWRENCE P. FAUST
55 A. - 12½ P.
ELIZABETH HOFFMAN
27 A. - 11½ P.
J. BYRNE
98.75 A.
GEORGE STUBY
I. R. BROWN
7 A. - 108½ P.
NORTH BRANCH
CATHERINE KILLENS
31 A. - 105 P.
JOSEPH H. PARRISH
32 A. - 150 P.
CATHERINE REHR
88 A. - 17 P.
REDINGER
JOHN SHILLING
24.8 A.
33.41 A.
THEODORE NELEN
114.36 A.
SYLVESTER BYRNE
87 A.
QUIT CLAIMED TO C.B.C. CORPN. SEPT. 16, 1941.
(All the Coal)
168.668 A.
ALBERT
DUMM
W 10,000
24.346 A.
RICHARD D. WILLIAMS
240 A.
JOHN S. DUMM
103 A. - 61 P.
38.04 A.
65.34 A.
WILLIAM A. GLENN
57.79 A.
JOHN T. THOMAS
113.5 A.
INDIANA
CAMBRIA
MINE
181.667 A.
ALVERDA
QUIT CLAIMED TO C.B.C. CORPN. SEPT. 16, 1941
(All the Coal)
26.637 A.
MARIA McCRACKEN
96.9 A.
AIR AND MANWAY SHAFT
LIEB & HOPPEL
63 A. - 47 P.
LEWIS BOLAND
76 A. - 76 P.
FRED & GEORGE SNYDER
106 A. - 110 P.
CASPER SMITH
109.77 A.
GEORGE FRESH HEIRS
WILLIAM GILES
JOSEPH GLENN
14.89 A.
COLONIAL COAL AND REALTY CO.
184.64 A.
ROBERT J. MORRIS
PETER BOLAND
(WILLIAM DAVIS)
99.81 A.
MARY E. JAMES
I. R. BROWN
112 A. - 155 P.
JACOB KRUG
109 A. - 137 P.
JAMES KIRSCH
GEORGE HOUCK
103 A. - 11 P.
PHILOMENA LIEB
83 A. - 12 P.
PETER PARRISH
78 A. - 132 P.
FRANCIS KIRSCH
CHRISTIAN PFEISTER
(C. P. PFEISTER)
92.85 A.
WILLIAM DAVIS
JOSEPH A. GRAY
GRAY AND WYLAND
51.11 A.
JOHN E. SOISSON
60.95 A.
A. B. SOISSON
59.93 A.
PAULINE SHERRY
(J. L. MITCHELL)
73.62 A.
J. G. C. BEARER
21.19 A.
CHRIST WHITE
GRAY AND WYLAND
200 A. - 137 P.
CASPER LIEB
21.19 A.
NICHOLAS LAMBOUR EST.
132.04 A.
NICKTOWN
NICHOLAS LAMBOUR
W 14,000
W 6,000
W 2,000
E 2,000
ELIZABETH FRESH
9.32 A.
MARY C. LIEB ET AL.
(ADAM LIEB)
52.81 A.
JOSEPH KLINE
81 A.
JOSEPH LIEB
110.74 A.
E. W. SMITH
SIMON KIRSCH, SR.
110.48 A.
MATCH LINE