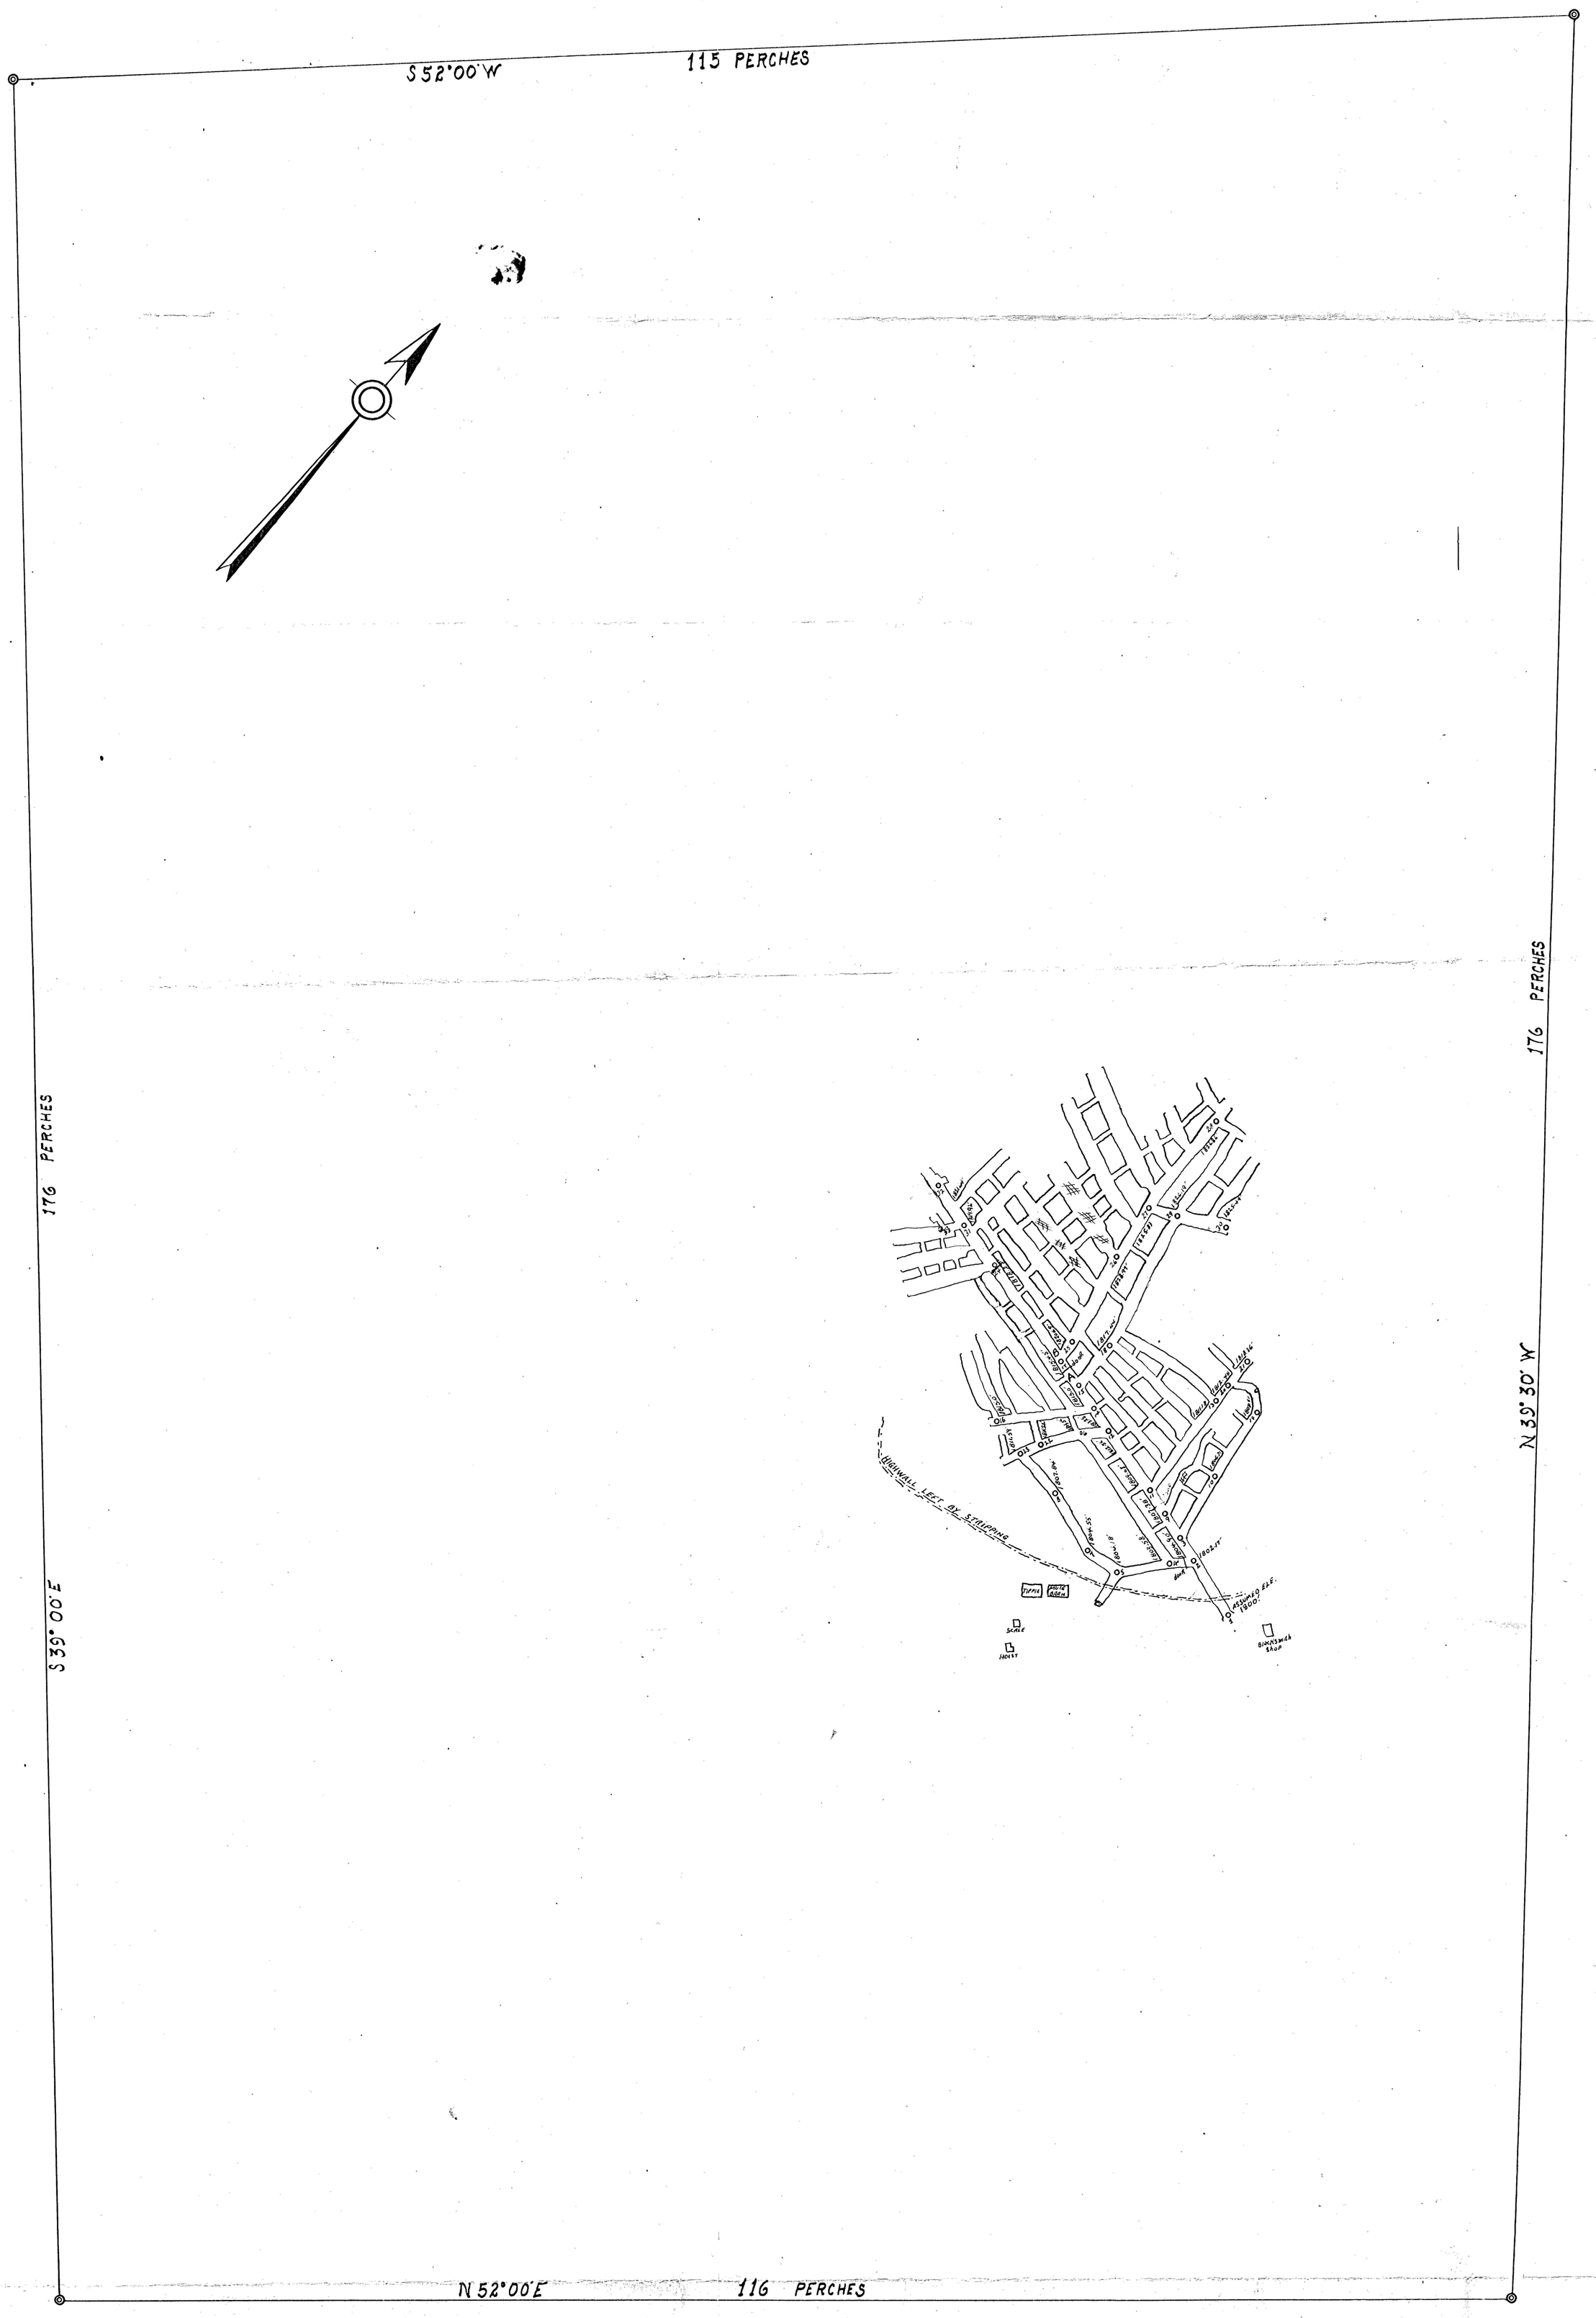

INDEX TO MINE SURVEYS			
LETTER	DATE	SURVEYED BY	PLATTED BY
A	5 - 8 - 1950	J. W. Heil	J. W. Heil
B	3 - 15 - 1952	J. W. & J. A. Heil	J. W. Heil

18-1956

KUTRUFF COAL CO.

MINE WORKINGS IN "E" SEAM
CHEST TOWNSHIP, CAMBRIA
COUNTY, PENNSYLVANIA.
SCALE 1" = 100' By J. W. & J. A. Heil

Posted
10-10-1958
(20)