


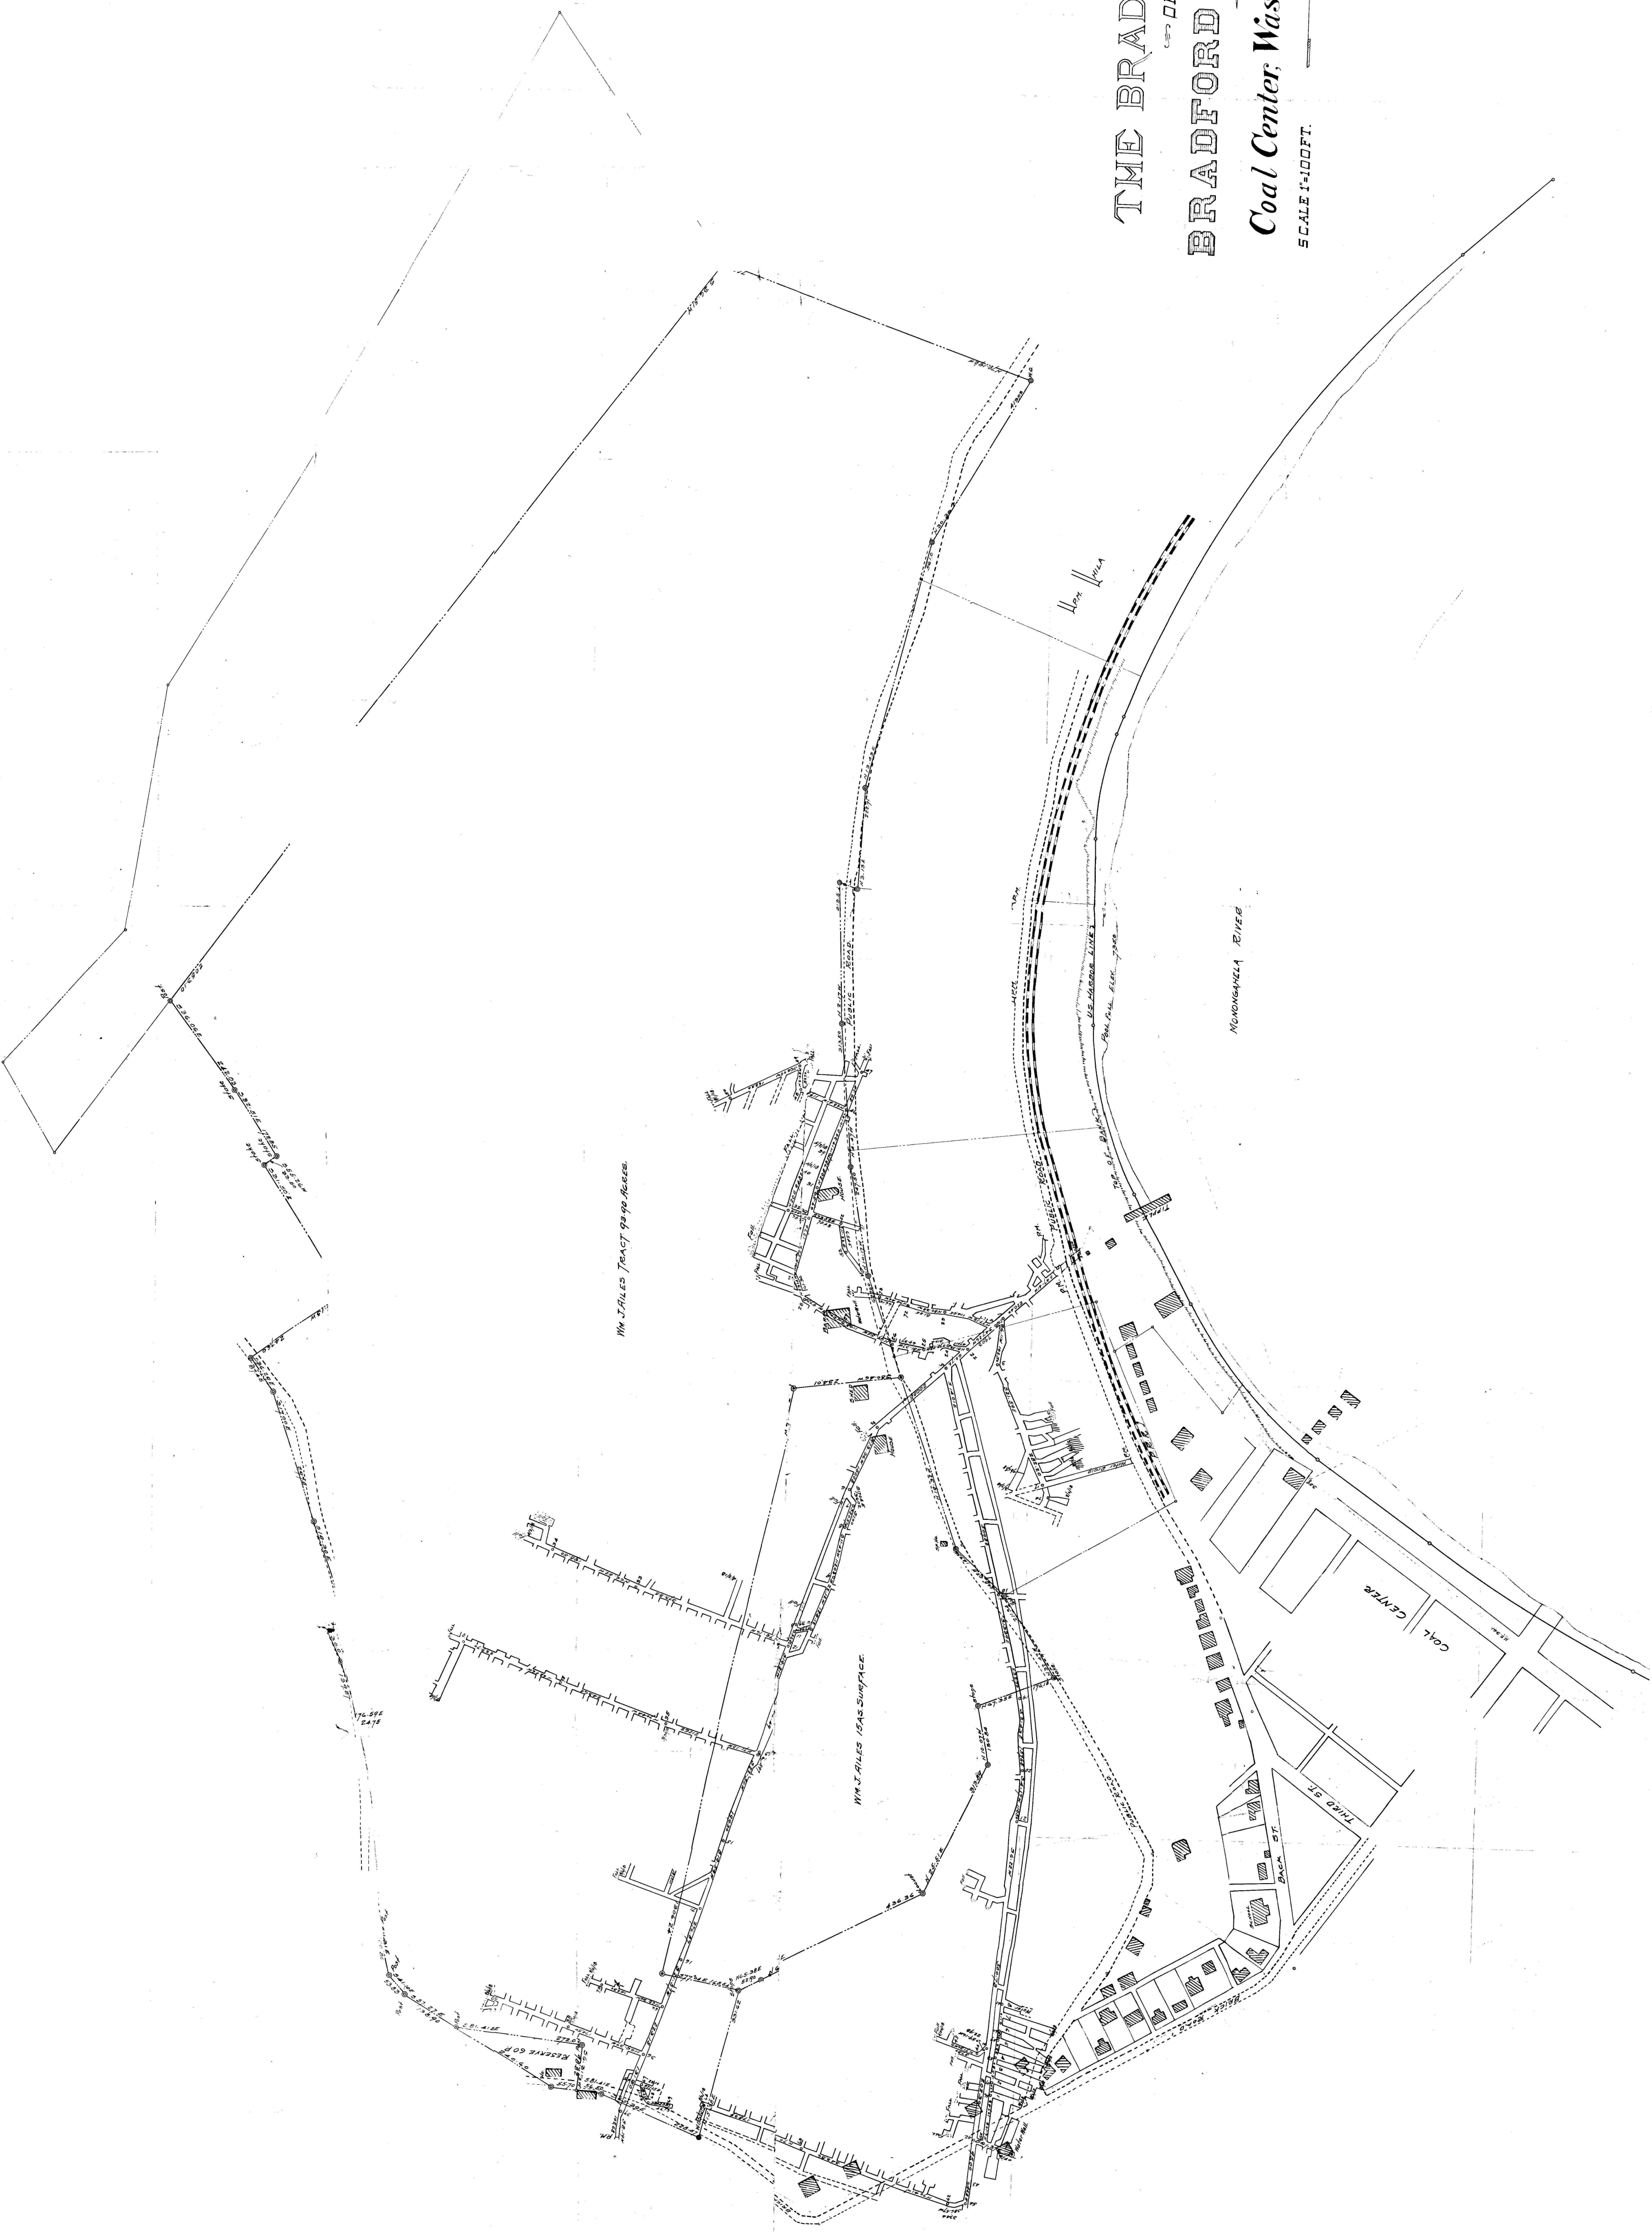

THE BRADFORD MINE
OF THE
BRADFORD GAS COAL CO.

Coal Center, Washington County, Pa.

SCALE 1"=100 FT.
APRIL 1918.
POSTED HERE BY