


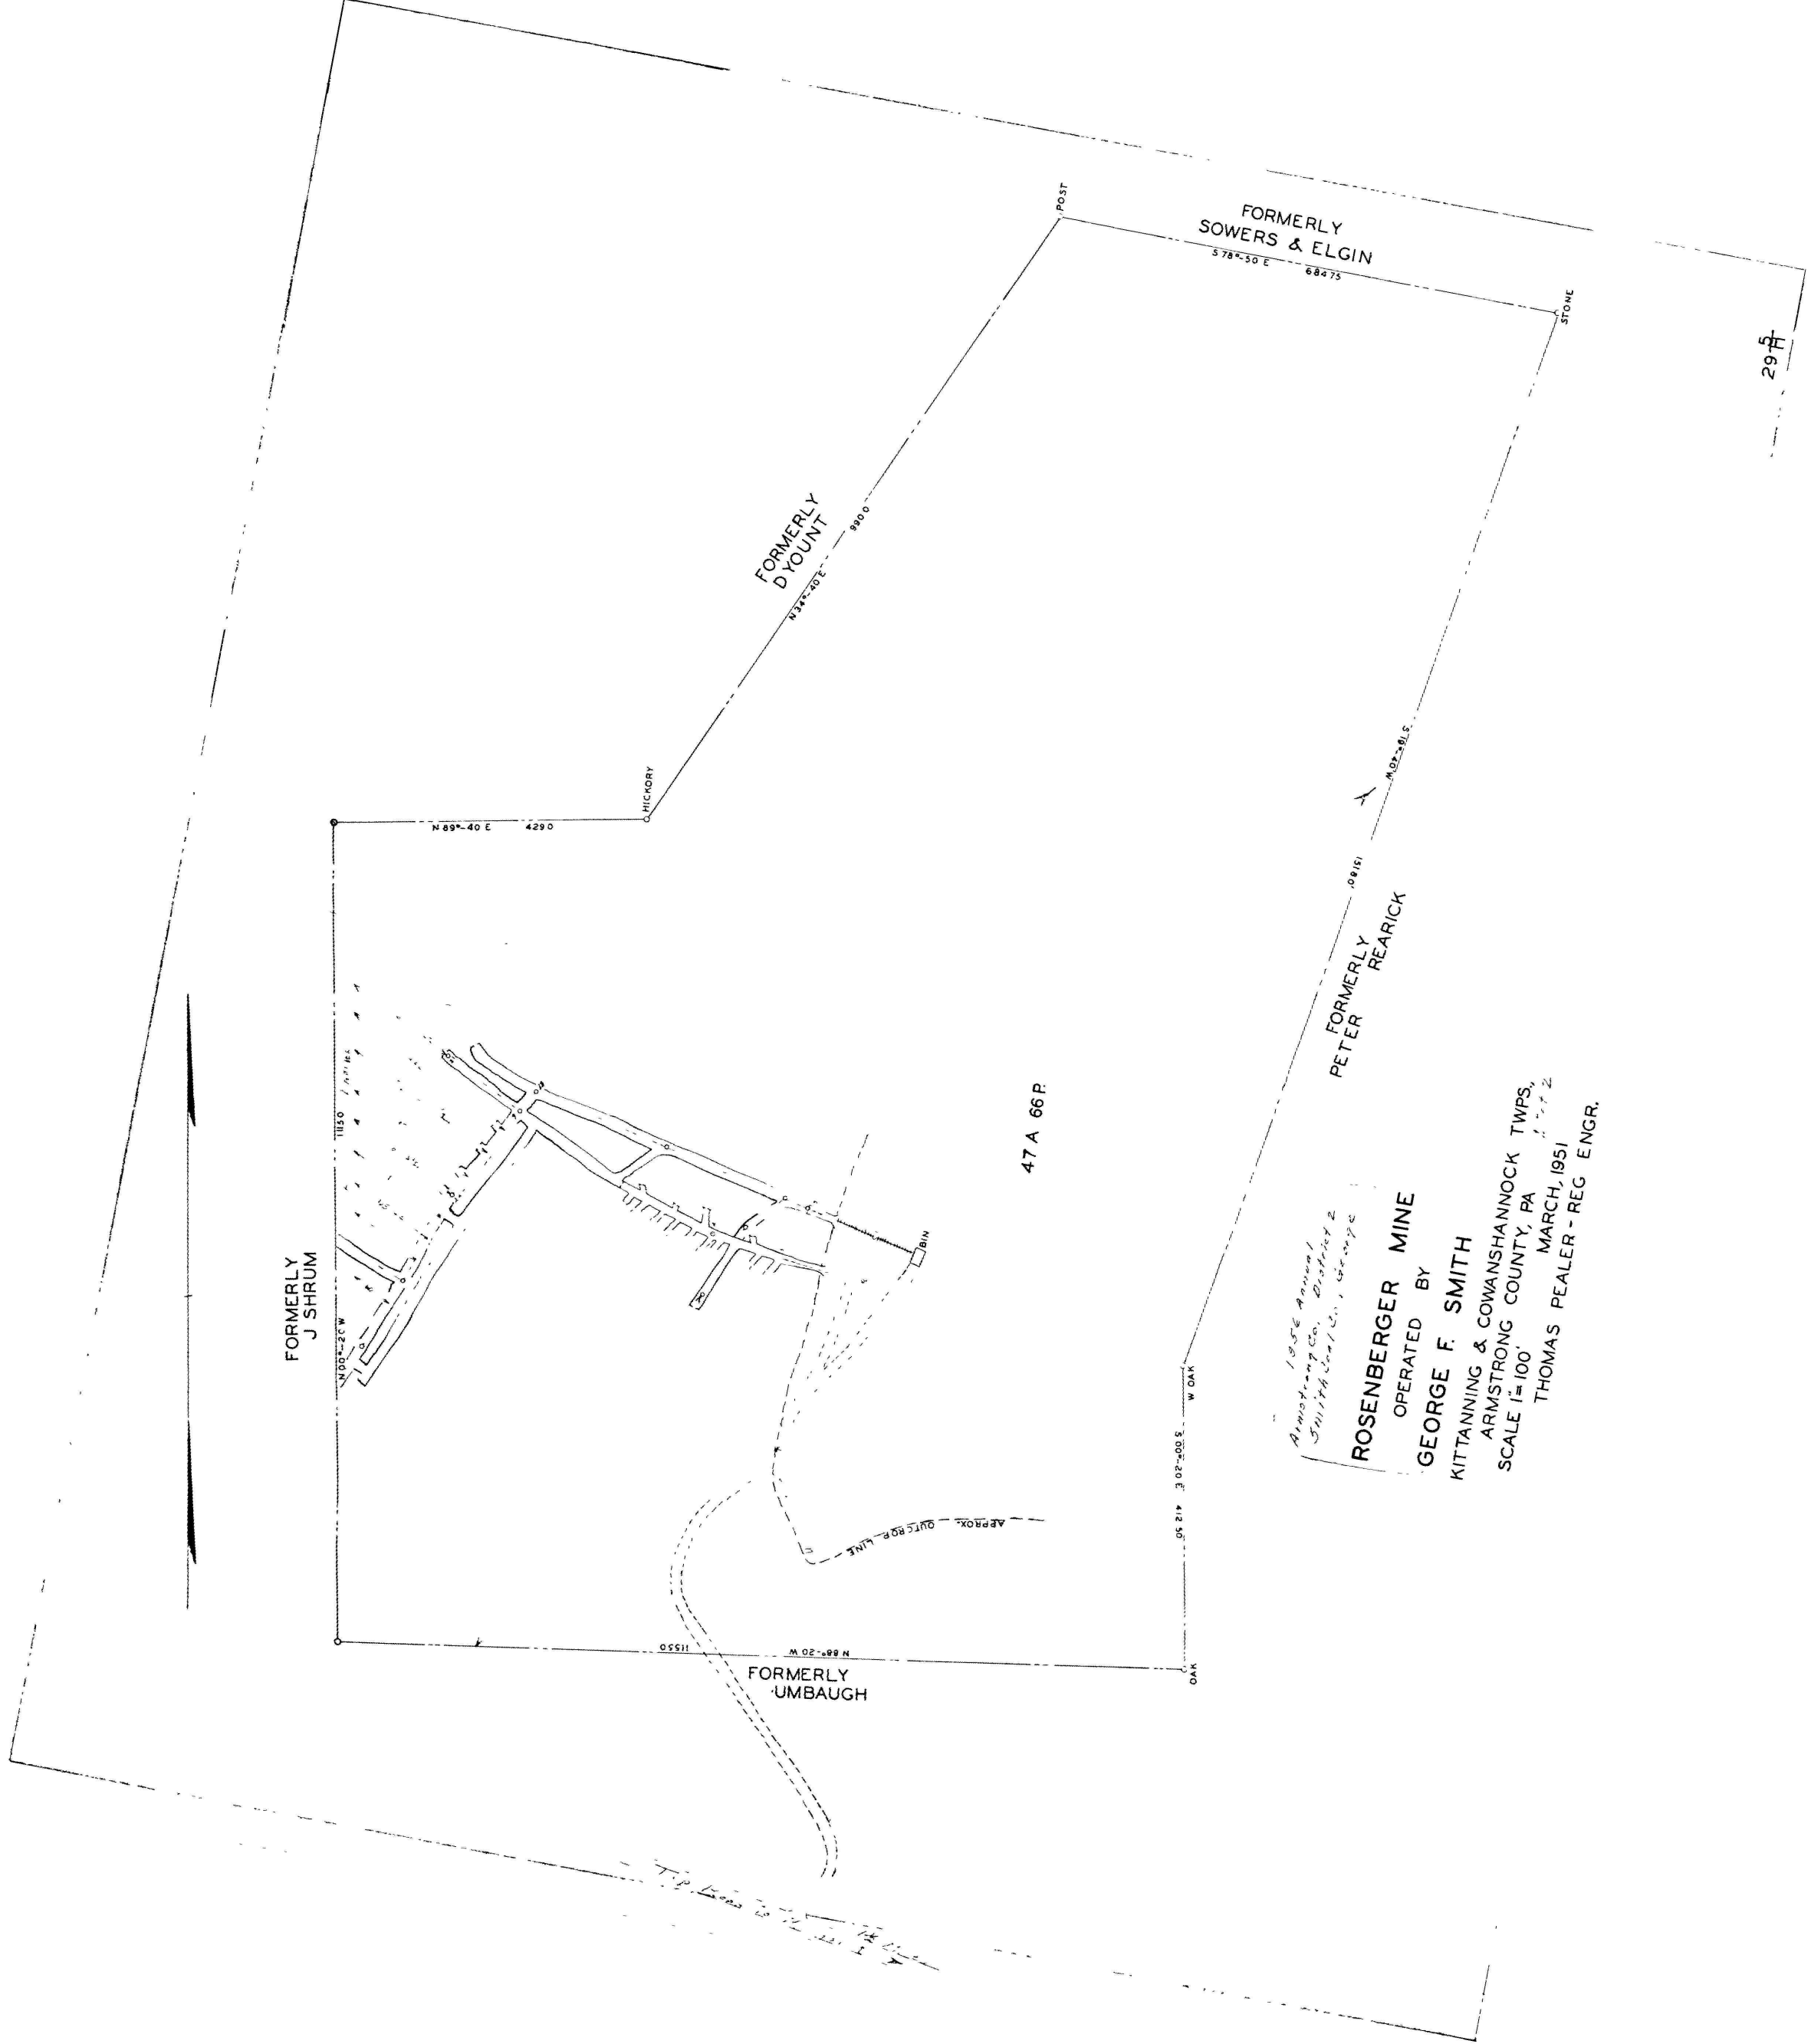

47 A 66 P

1956 Annual
Armstrong Co. District 2

ROSENBERGER MINE
OPERATED BY
GEORGE F. SMITH
KITANNING & COWANSHANNOCK TOWNSHIP,
ARMSTRONG COUNTY, PA.
SCALE 1"=100'
MARCH, 1951
THOMAS PEALER - REG. ENGR.