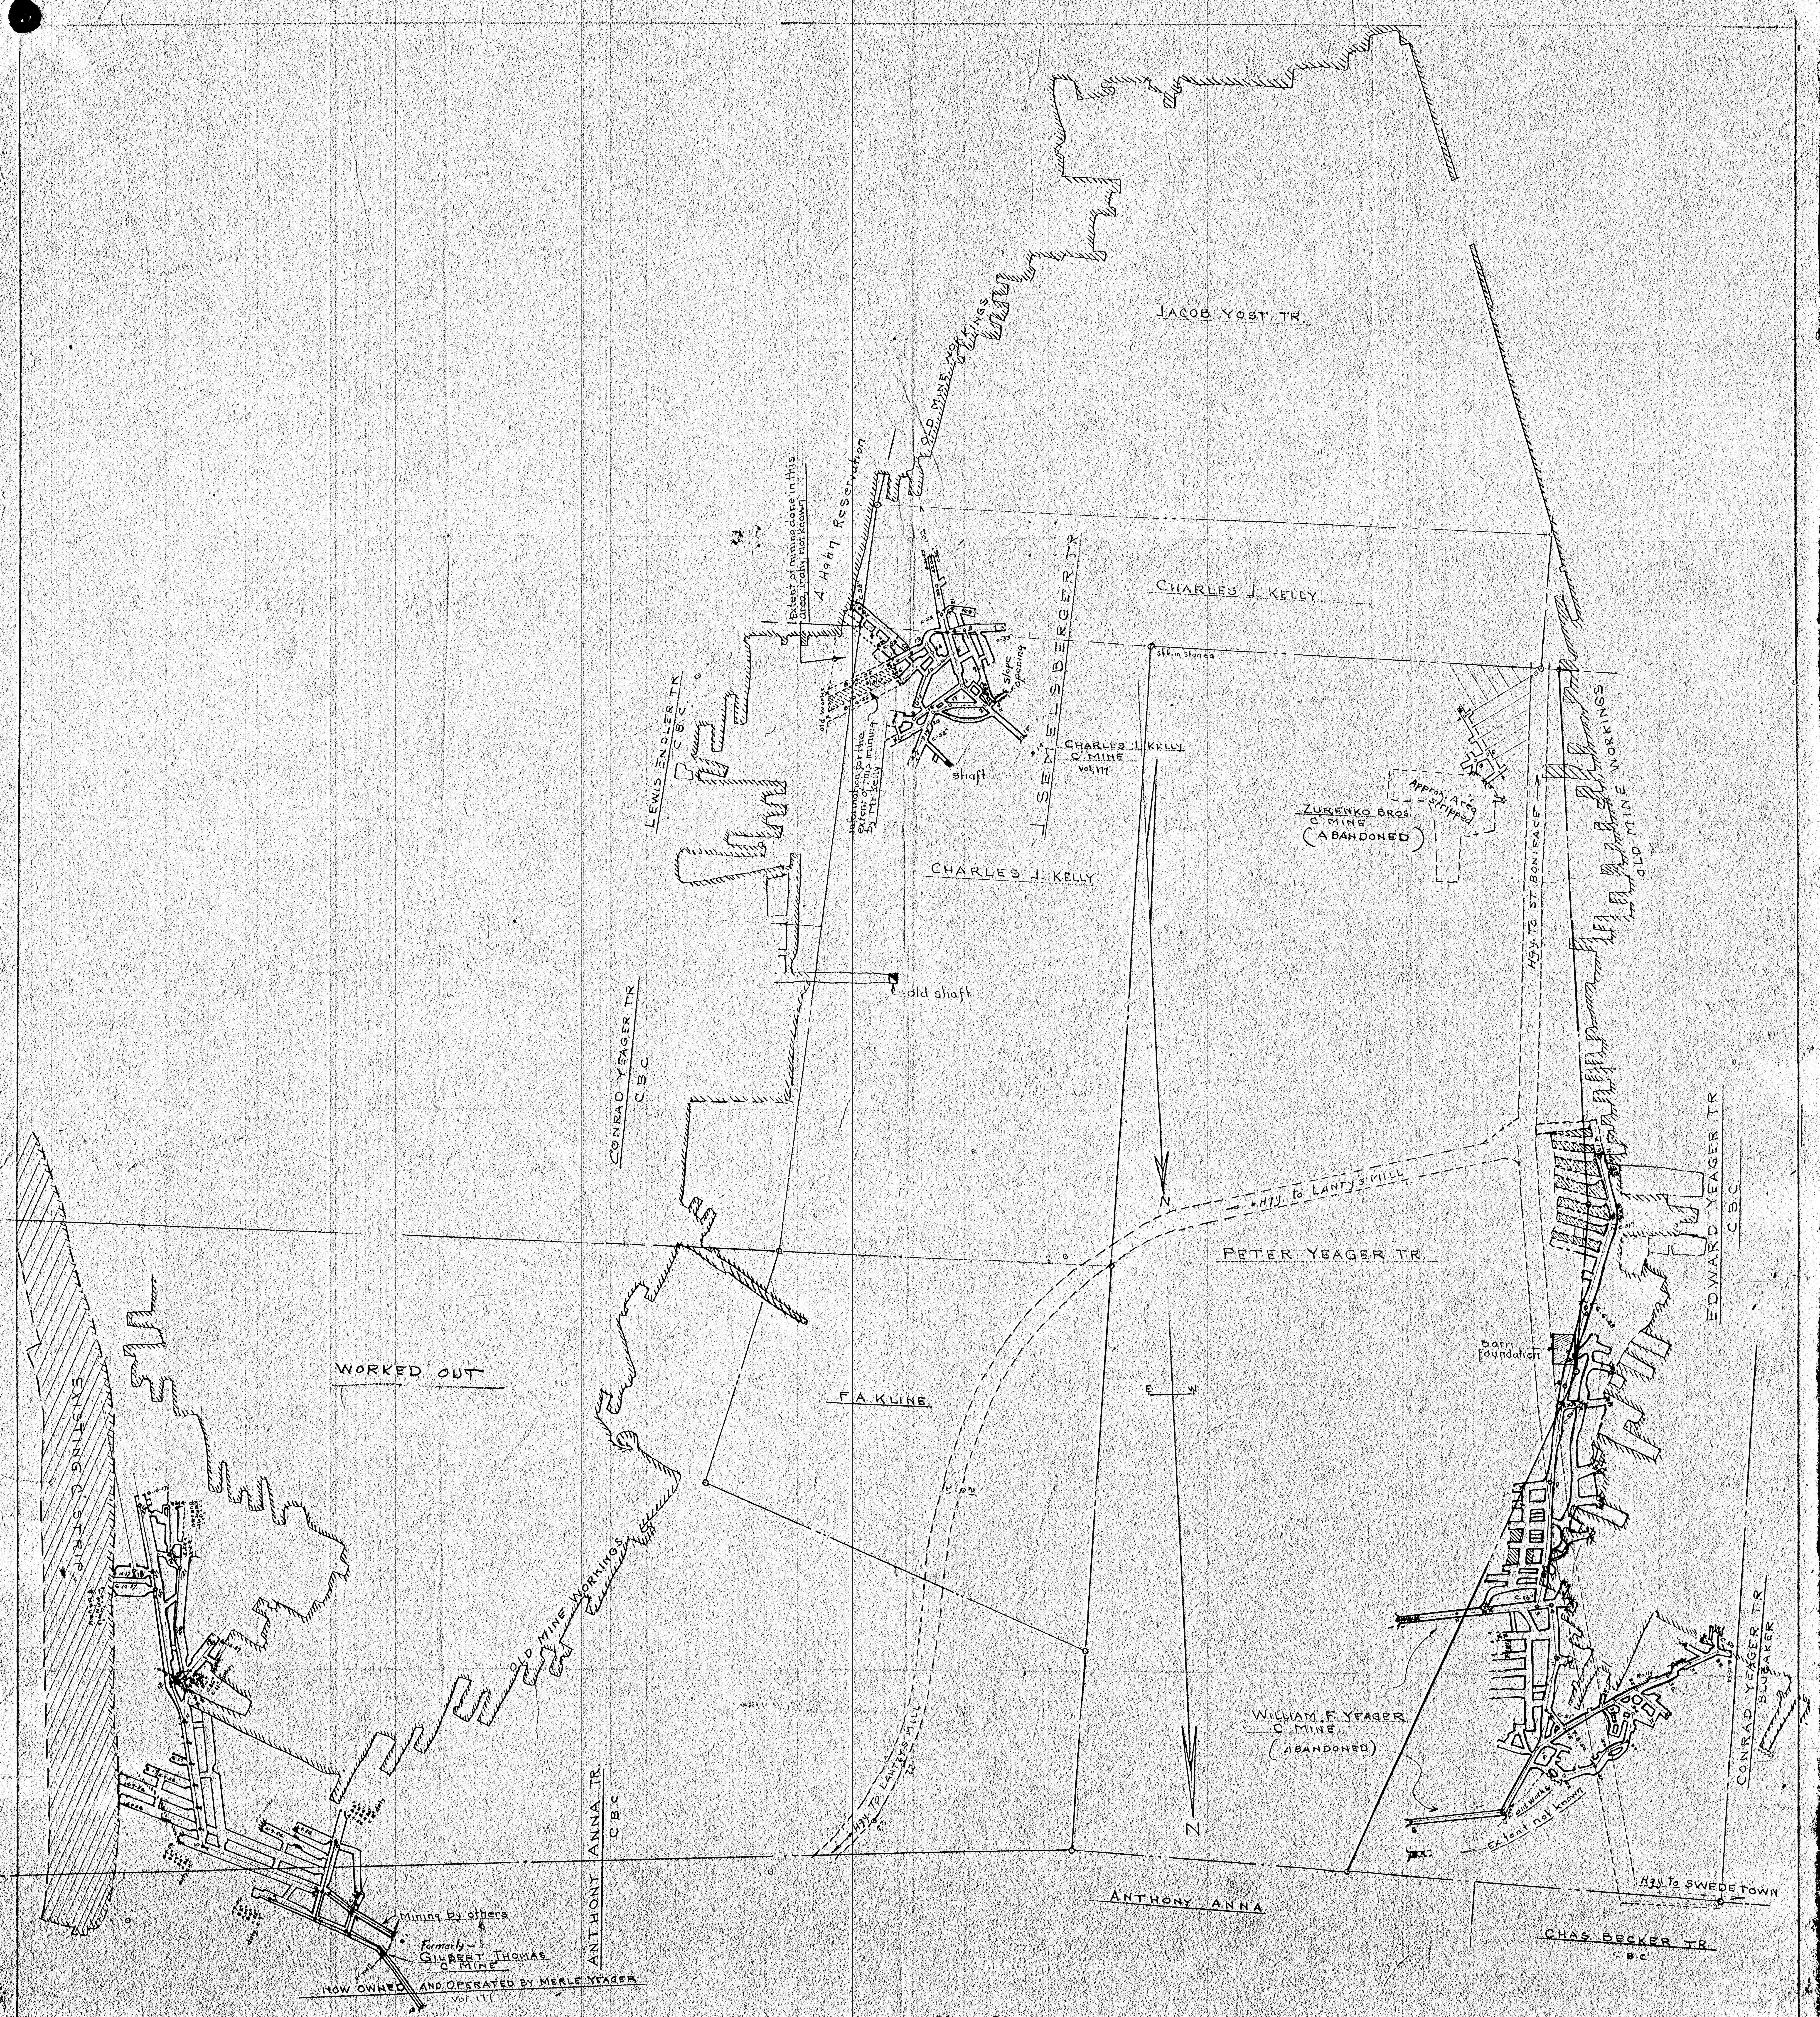
JACOB YOST TR.
OLD MINE WORKINGS
Extent of mining done in this area, if any, not known
A Hahn Reservation
CHARLES J. KELLY
J. SEMELSBERGER TR.
slope opening
stk. in stones
LEWIS ENDLER TR.
C.B.C.
old works
Information for the extent of this mining by Mr. Kelly
shaft
CHARLES J. KELLY
C' MINE
Vol. 177
CHARLES J. KELLY
ZURENKO BROS.
C' MINE
(ABANDONED)
Approx. Area stripped
Hgy. to ST. BONIFACE
OLD MINE WORKINGS
old shaft
CONRAD YEAGER TR.
C.B.C.
Hgy. to LANTY'S MILL
PETER YEAGER TR.
EDWARD YEAGER TR.
C.B.C.
EXISTING C STRIP
WORKED OUT
F.A. KLINE
E
W
N
Barn foundation
OLD MINE WORKINGS
Hgy. to LANTY'S MILL
WILLIAM F. YEAGER
C' MINE
(ABANDONED)
old works
Extent not known
Rolly
CONRAD YEAGER TR.
BLUBAKER
ANTHONY ANNA TR.
C.B.C.
Mining by others
Formerly –
GILBERT THOMAS
C' MINE
NOW OWNED AND OPERATED BY MERLE YEAGER
Vol. 177
ANTHONY ANNA
Hgy. to SWEDETOWN
CHAS. BECKER TR.
C.B.C.

MAP SHOWING
C' PRIME MINE WORKINGS
SITUATE IN
ELDER TWP. CAMBRIA CO., PA.
JULY 1954 SCALE 1"=100'
Martin C Kirsch, Engr.

old Mine Workings Copied from C.B.C. map.

Merle Yeager Coal Company
(Formerly Gilbert Thomas C' Mine)

ADJACENT OPERATIONS

William F. Yeager - C Prime Mine (abandoned)

Charles J. Kelly - C Prime Mine (Kelly #1)

Zurenko Brothers - C Prime Mine (Abandoned)