


WIMES

1870  
1871  
SURVEY RECORD  

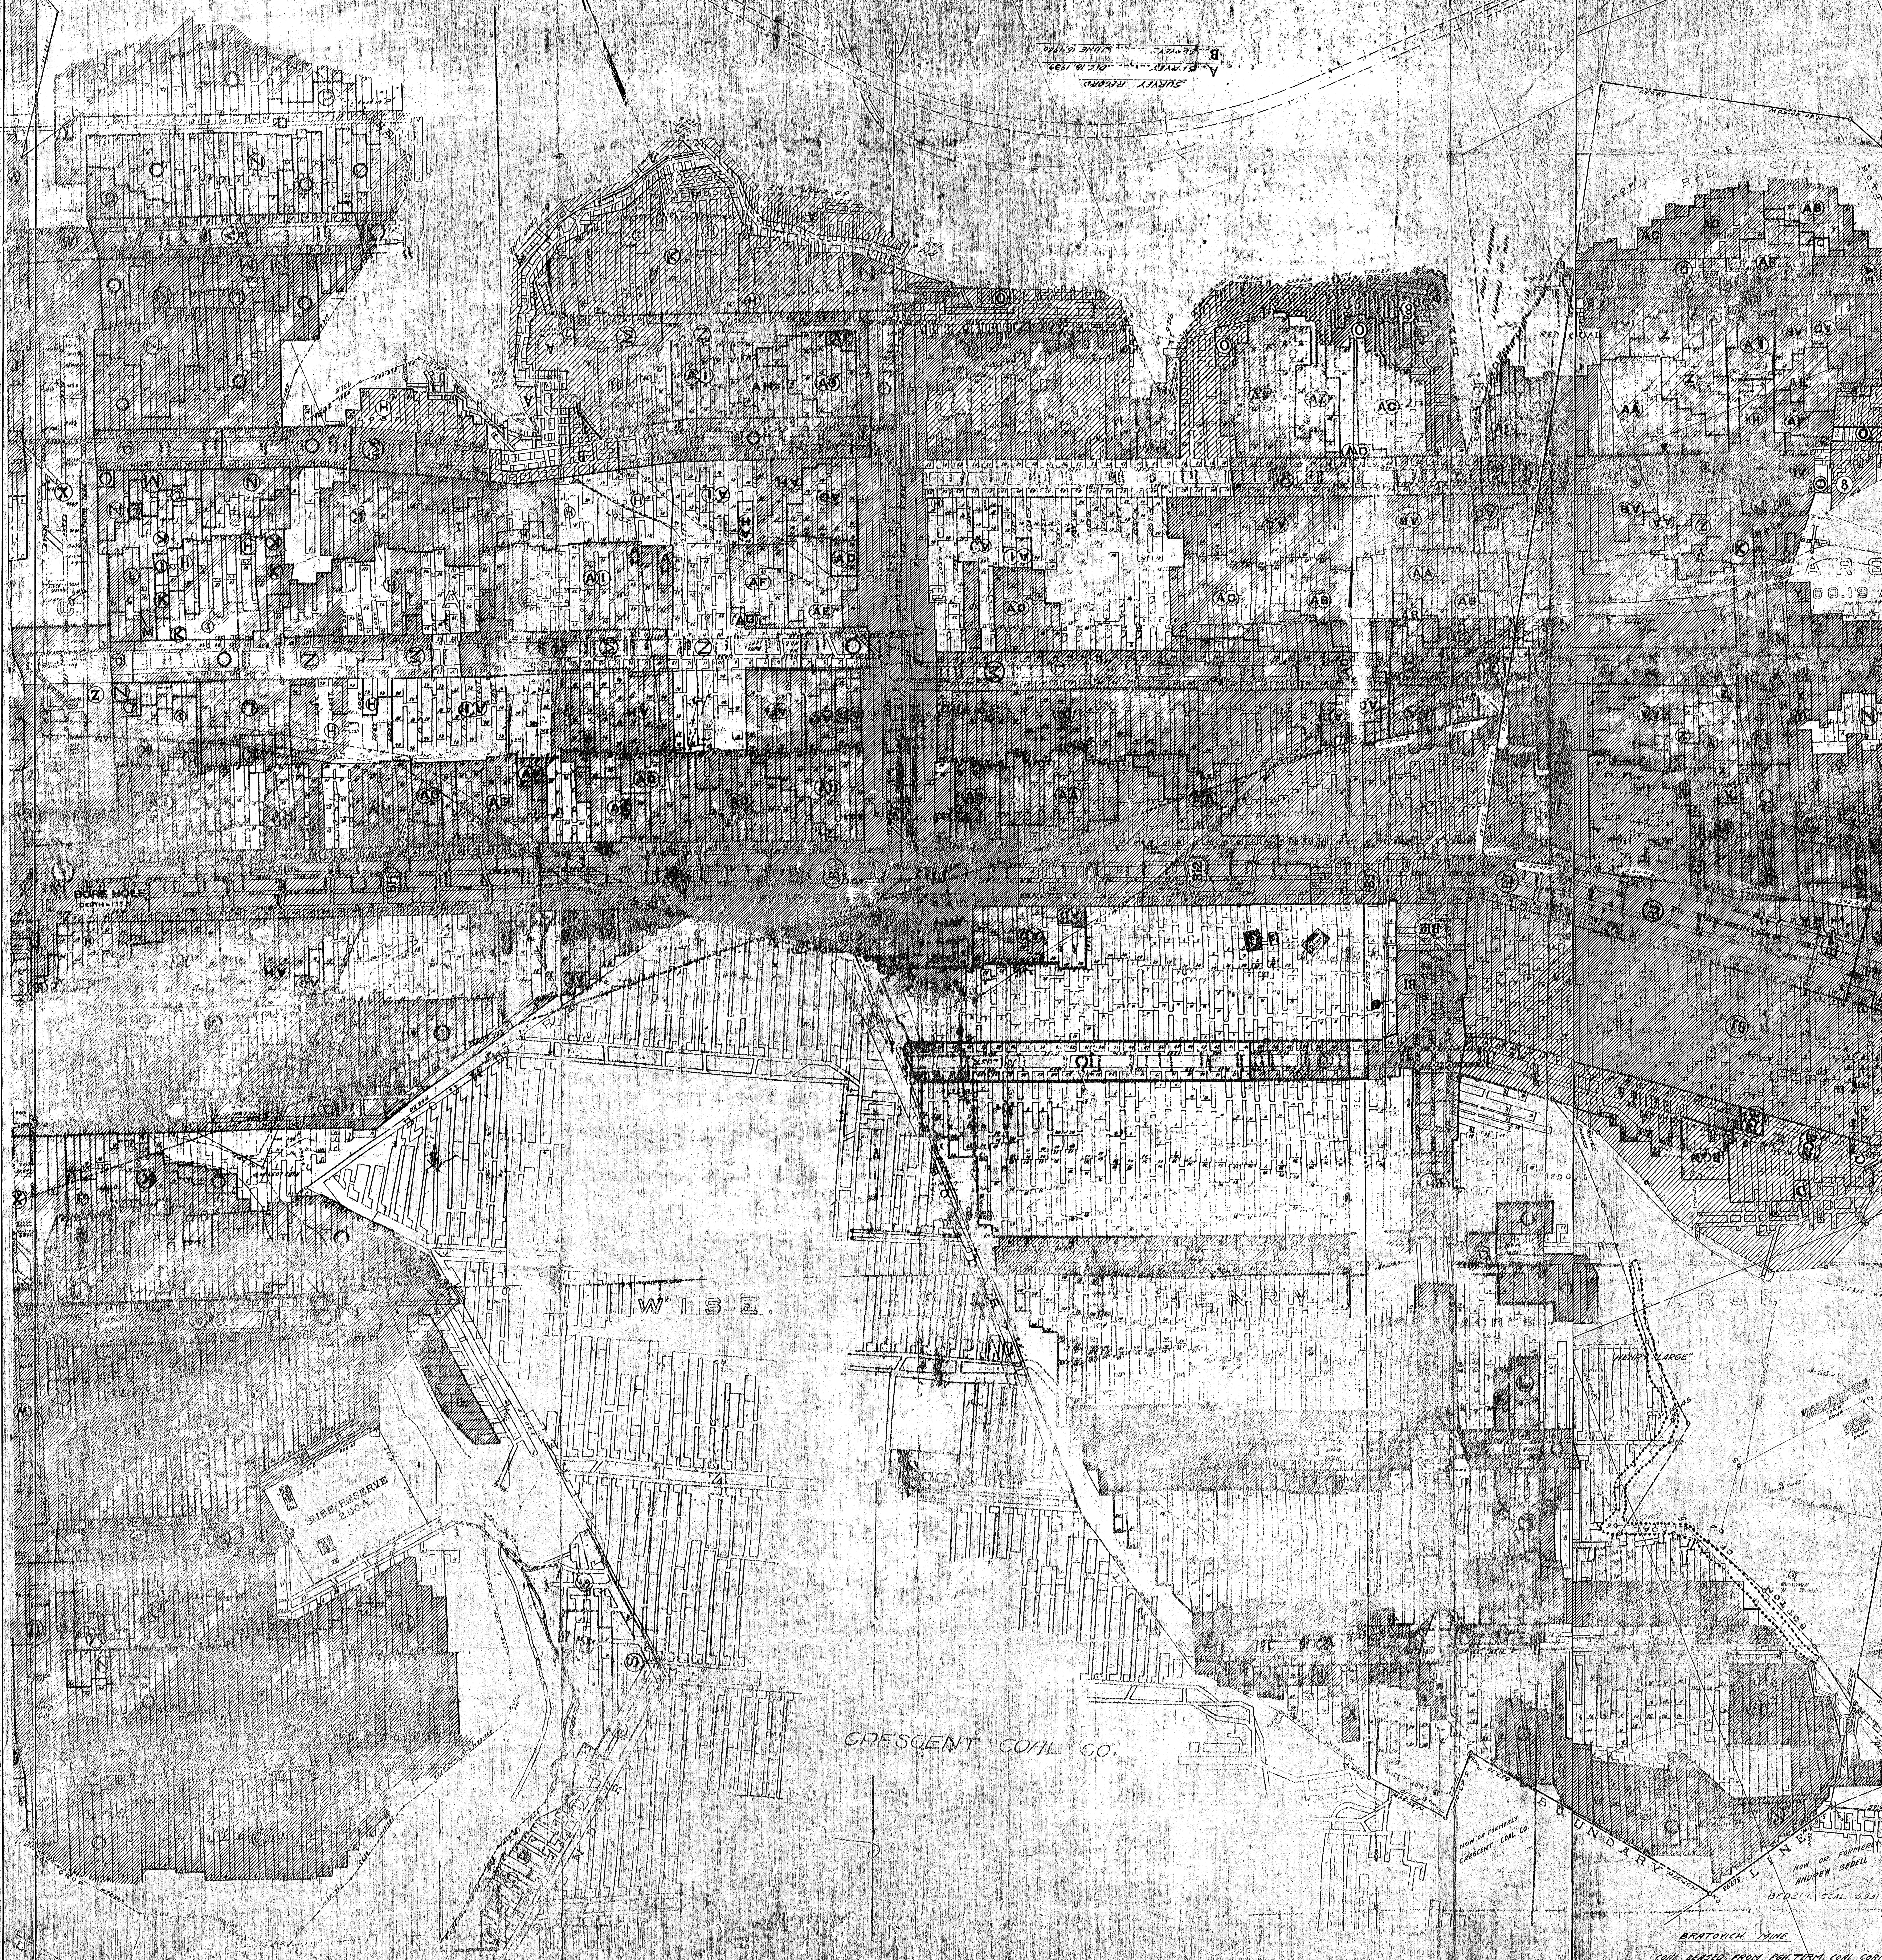

SITUATED IN JEFFERSON TWP. JEFF. CO. PA.  
SCALE 1"=100' JUNE 26, 1964

LEGEND  
COAL STRIPPED

64318  
04-299  
C-8