
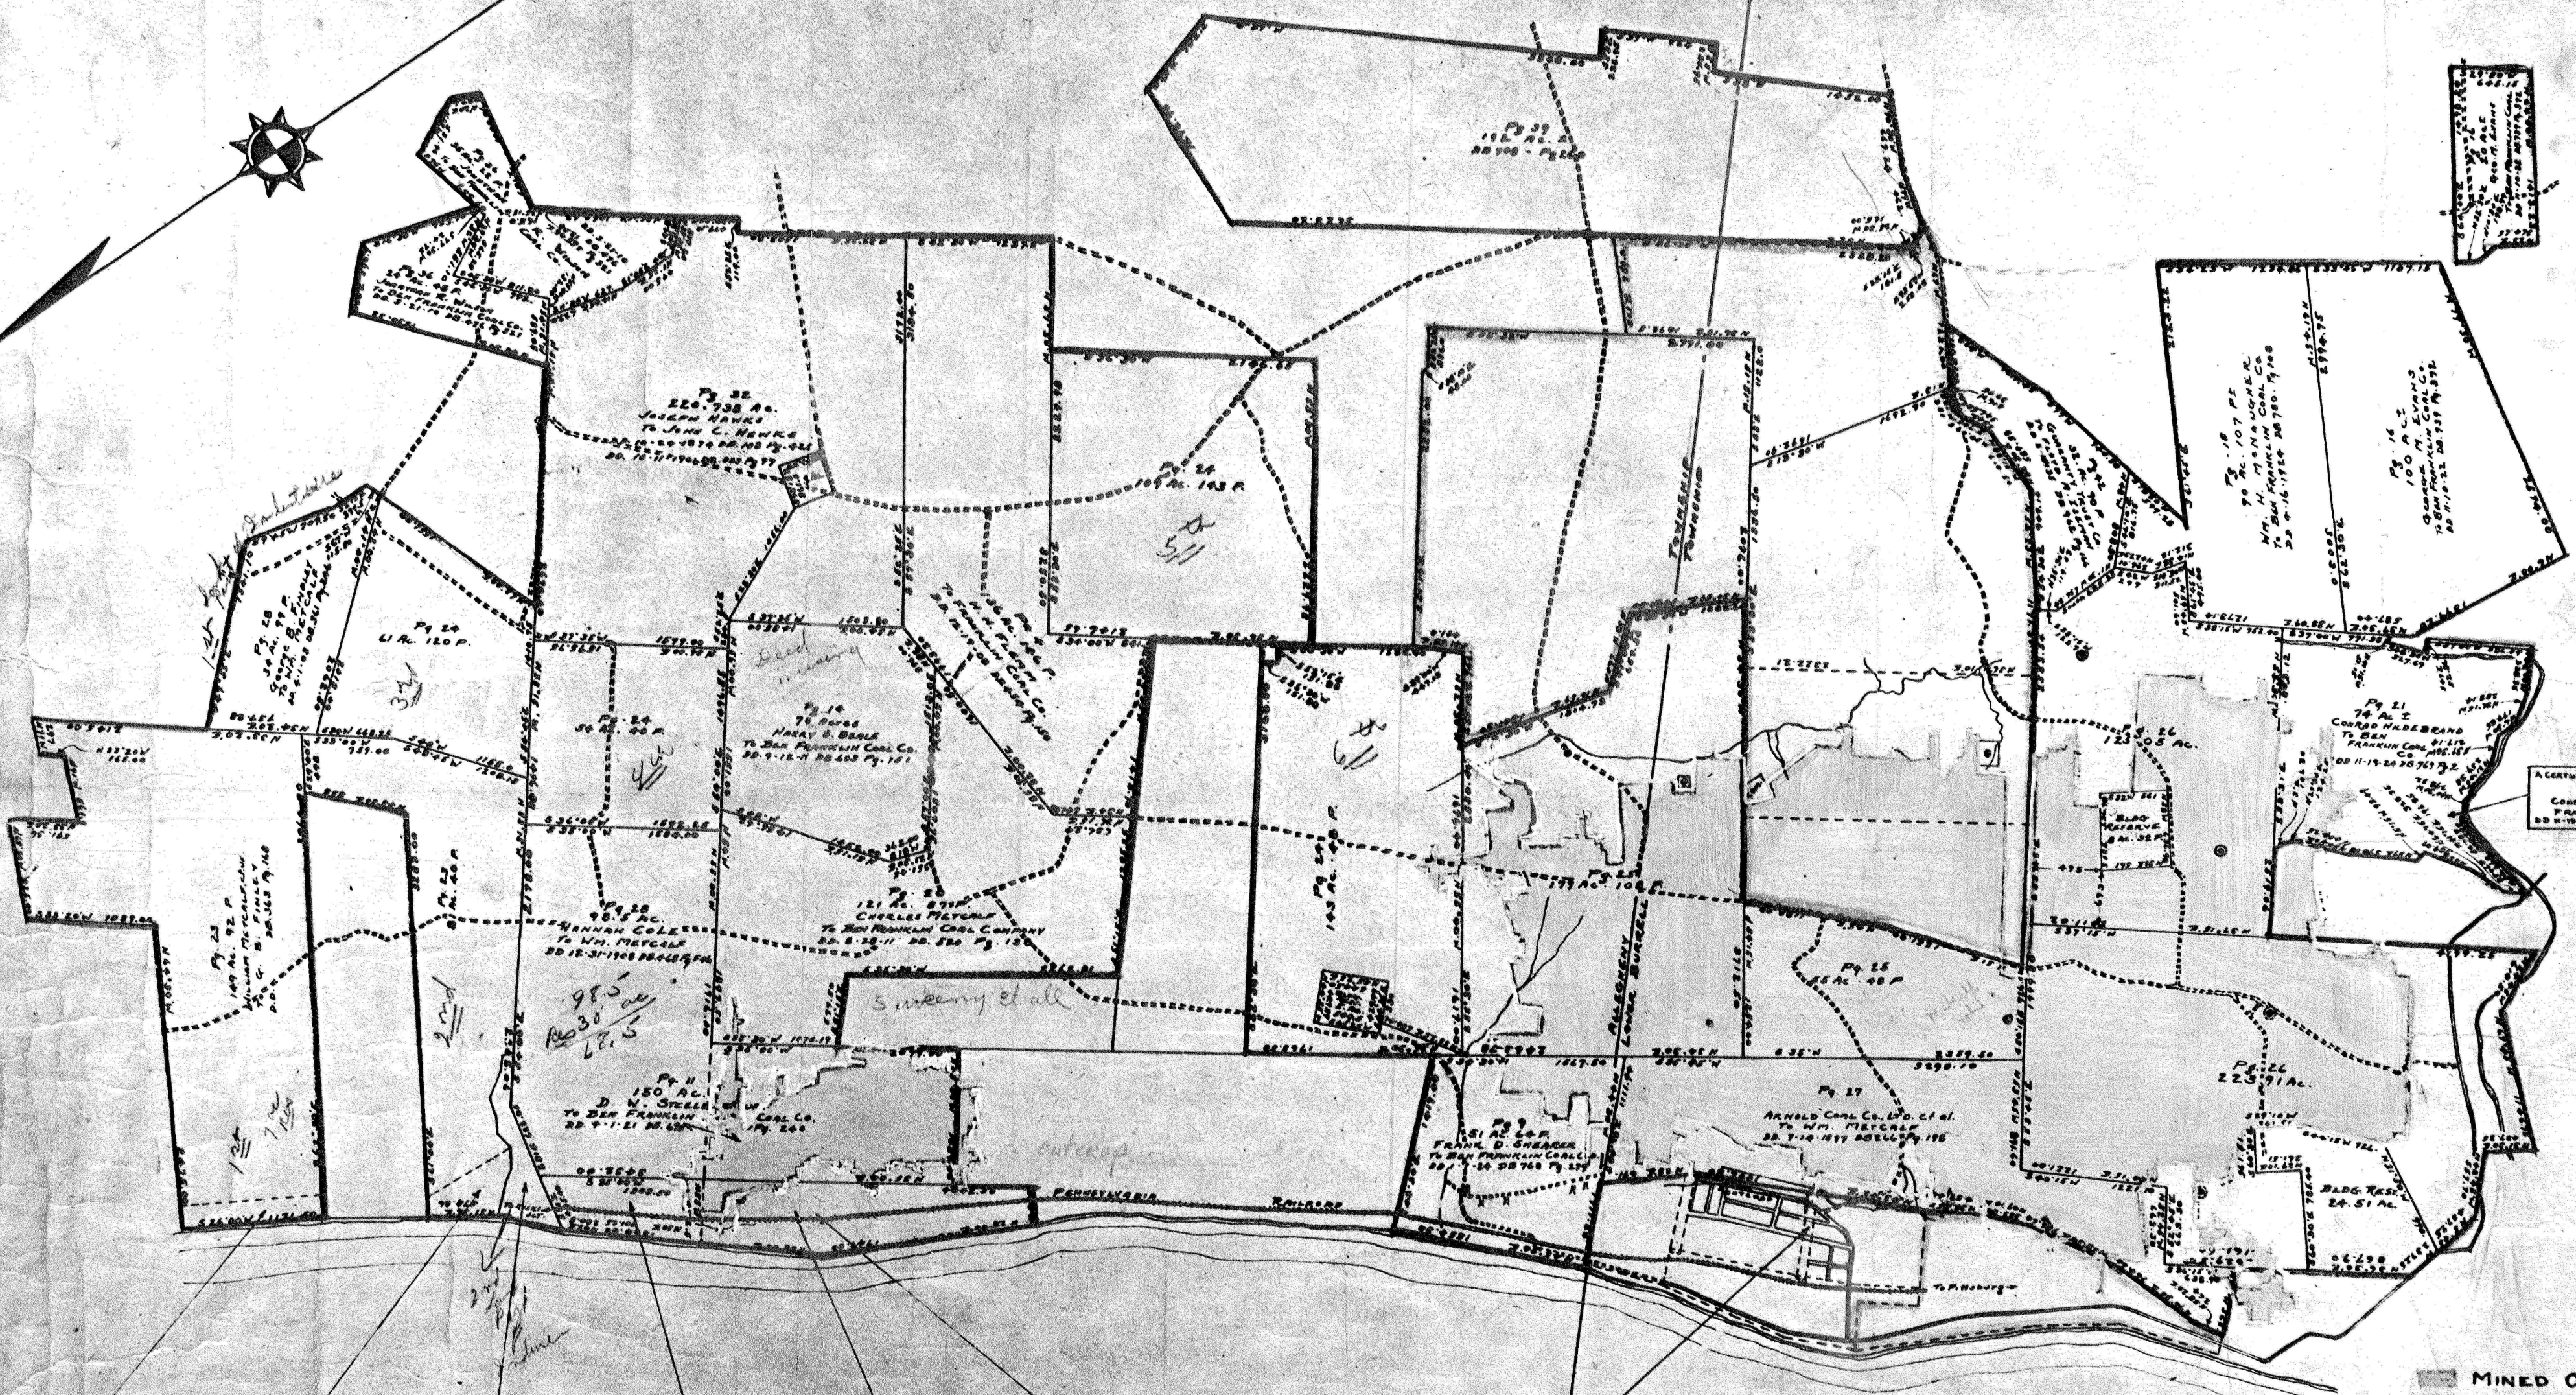


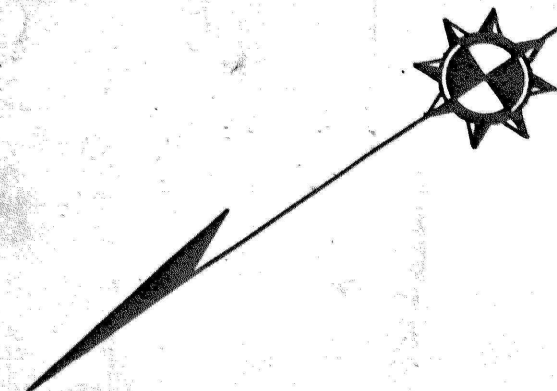

A CERTAIN RESERVE IN THIS AREA
Pg. 21
CONRAD HILDEBRAND
FRANKLIN COAL CO.
DD 11-15-24 20 753 752

MINED OUT
ABSTRACT
INSERTED TO SHOW
RELATIVE POSITION

THE FOLLOWING CERTAIN LOTS
IN THE R.P. ARNOLD PLAN OF BRAEBURN VILLAGE
RECORDED WESTMORELAND CO. PLEX. 1 PAGE 161

PG.	LOT No.	FROM	TO	DEED	D.B.	PG.
8		Charles W. Co. Lumber	Ben Franklin Coal Co.	9-6-11	400	300
10	180-16	J. L. Davis	Ben Franklin Coal Co.	10-9-19	619	80
12		Antonio Pover	Ben Franklin Coal Co.	1-10-21	670	470
15	Part of 61	Lavina Wills	Ben Franklin Coal Co.	9-6-23	789	666
31	B	R. P. Arnold	Wm. Metcalf	8-27-27	260	810
31	C	"	"	"	"	"
35		D. B. Schantz	Ben Franklin Coal Co.	8-1-11	499	810
35		"	"	"	"	"
38	89 & 60	John S. Painter	Ben Franklin Coal Co.	10-28	709	108

Plot of Properties
FOR
BRAEBURN COAL COMPANY
FROM A CERTAIN ABSTRACT FURNISHED BY T. DALE STEWART
WITH CONNECTING PROPERTIES FROM M.E. SOUDERS' FILES
TO SHOW RELATIVE POSITION
SITUATED IN
ALLEGHENY & LOWER BURRELL TWPS. - WESTMORELAND CO. PA.
M. EUGENE SOUDERS - REG. PROF. ENGR. No. 2806
LEECHBURG, PA.
MAR. 10, 1951
SCALE 1 in. = 1000 ft.

PG. 30
4 AC. 71 P.


PG. 30
5 AC. 32 P.
ARNOLD COAL CO. LTD.
TO WM. METCALF
DD. 8-10-1927 DD. 224 7190

PG. 28
6 AC. 32 P.
THOMAS J. BEALE
TO WILLIAM METCALF
DD. 10-8-1931 DD. 100 7192

PG. 29
BEN FRANKLIN COAL CO.
TO BEN FRANKLIN COAL CO.
DD. 15-31-28 DD. 468 7151

PG. 6
57-92 AC.
ELLEN T. BURGESS
TO BEN FRANKLIN COAL CO.
DD. 15-31-28 DD. 468 7155

PG. 7
57-92 AC.
NANNAN COAL
TO FRANKLIN COAL CO.
DD. 15-31-28 DD. 468 7157

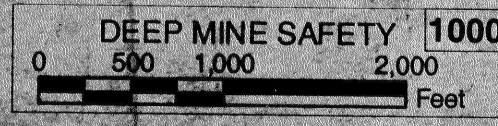

H-109-351

DWG. No. 50-59