


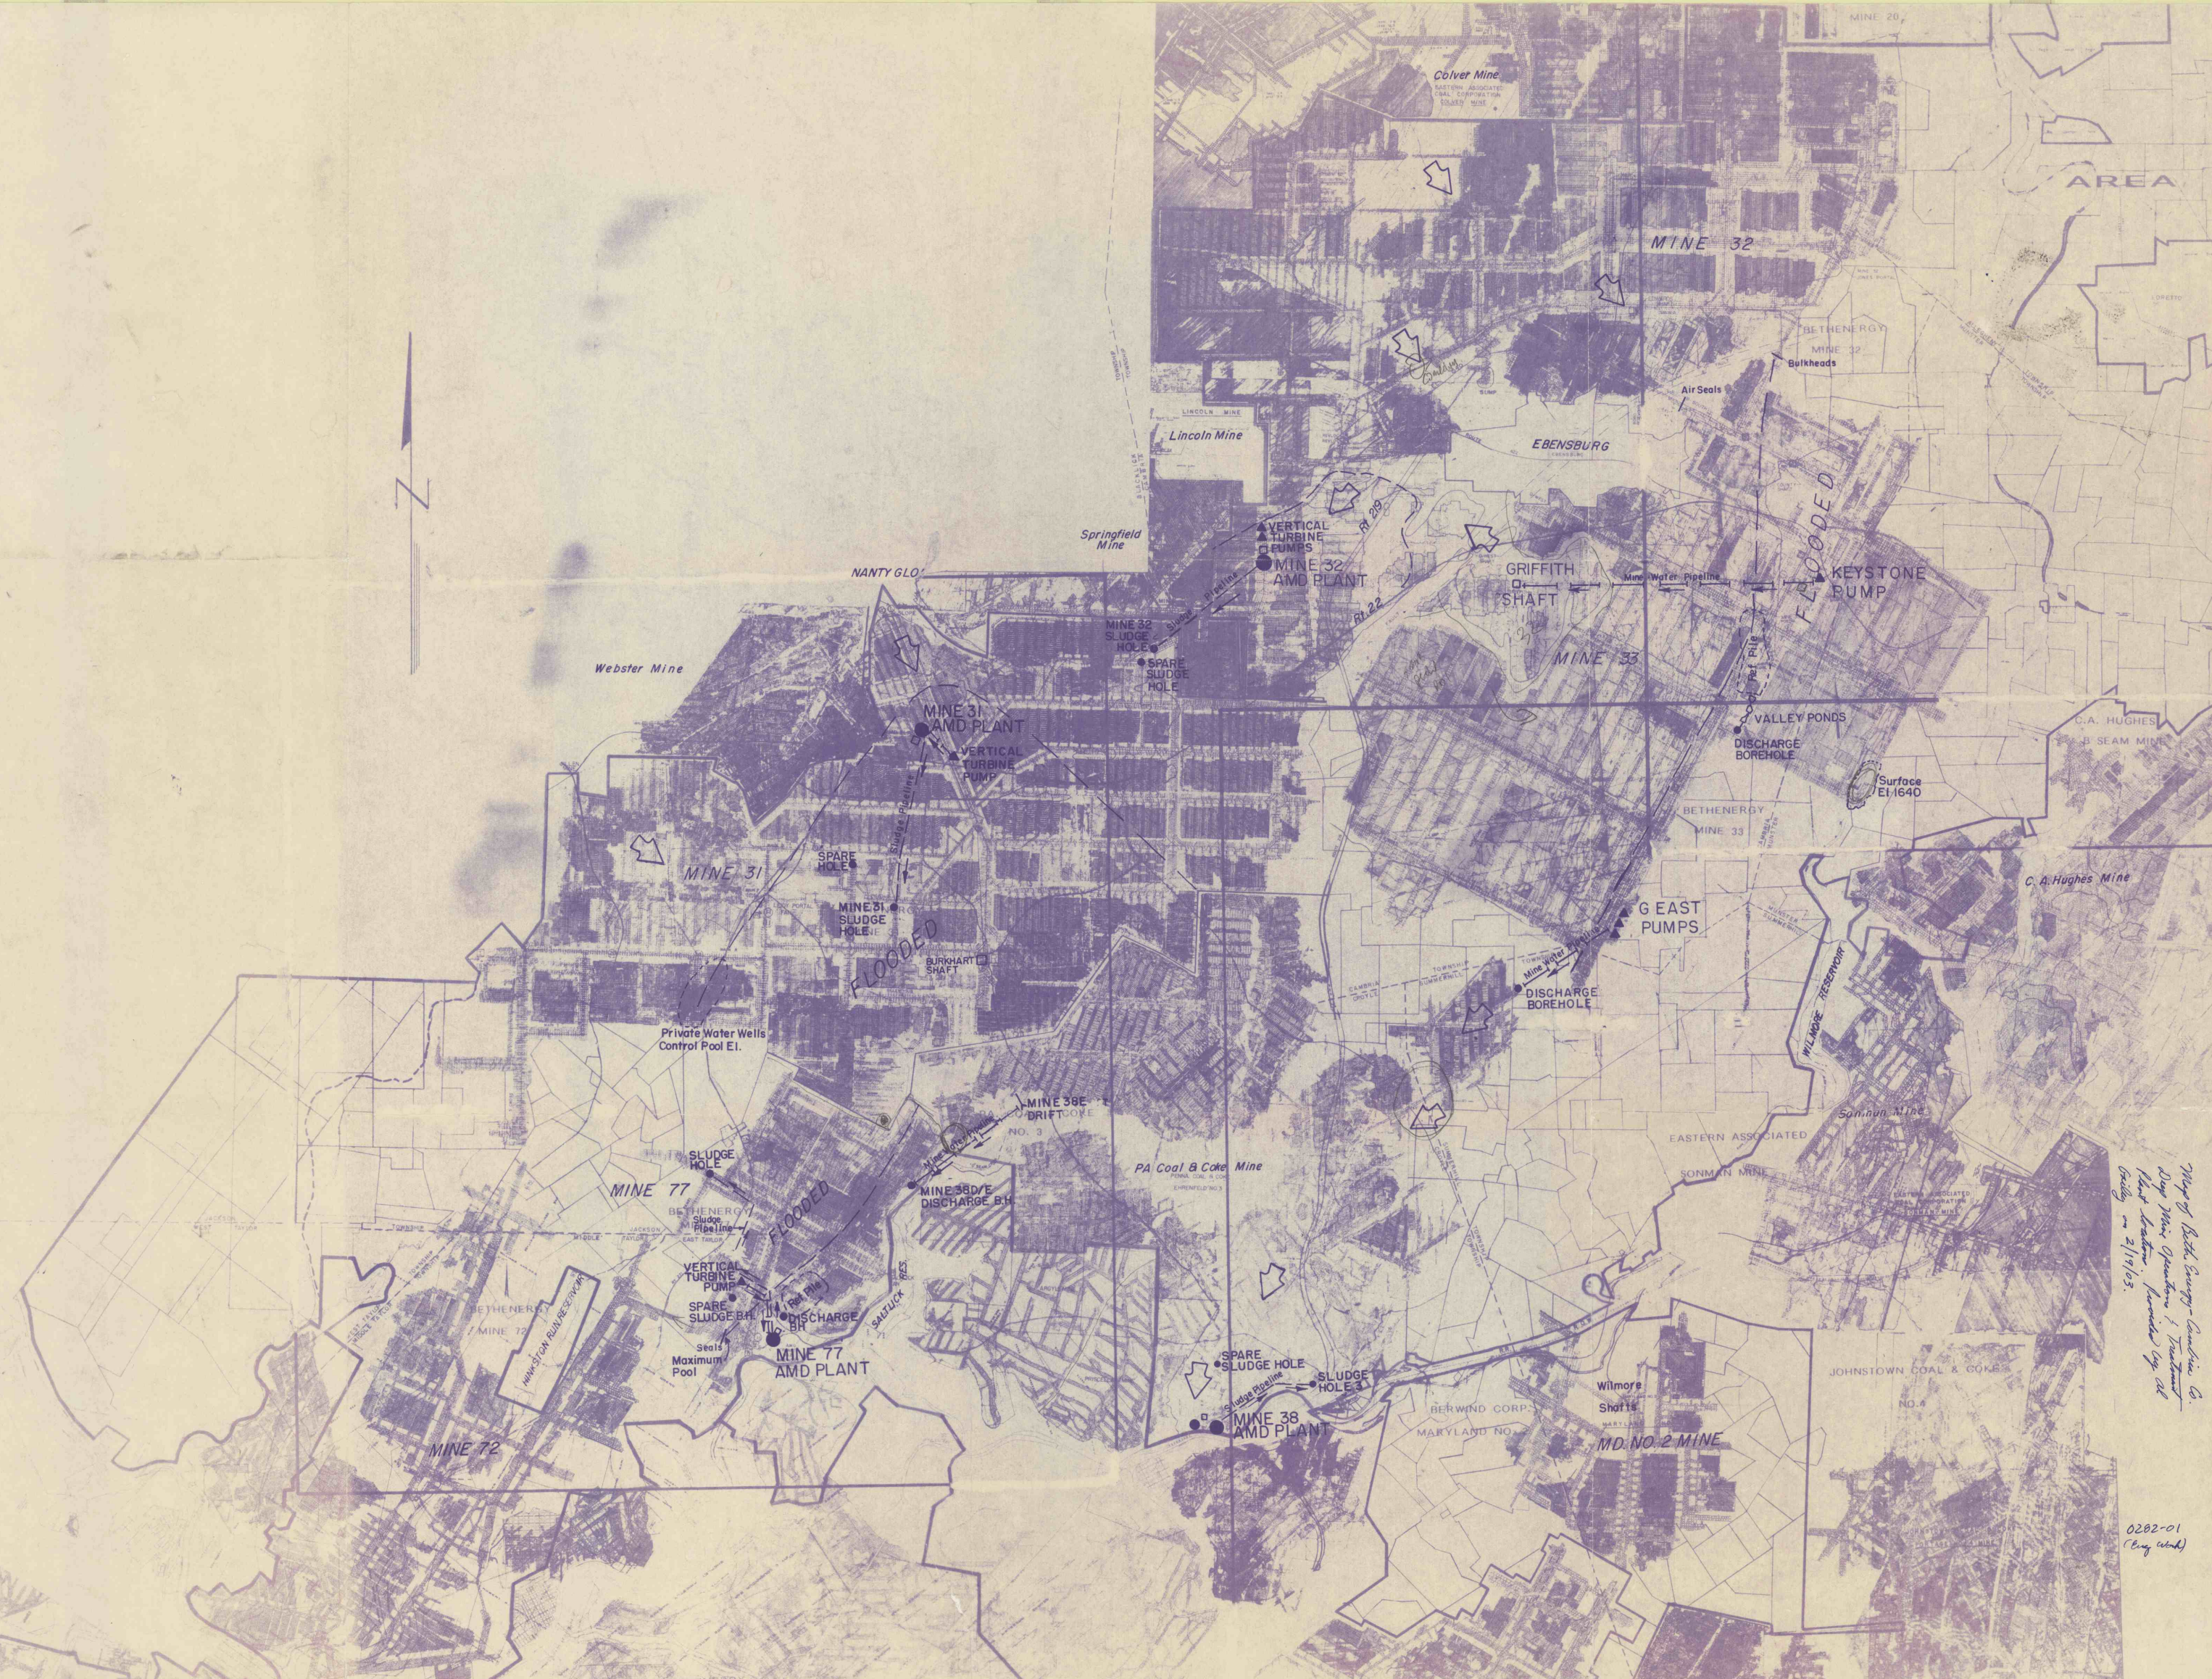

Map of Bethany Company, Lincoln Co.
Map of Mine Operations & Treatment
Plant Location, provided by M.
Gentry on 2/19/03.

0202-01
(Eng. work)