
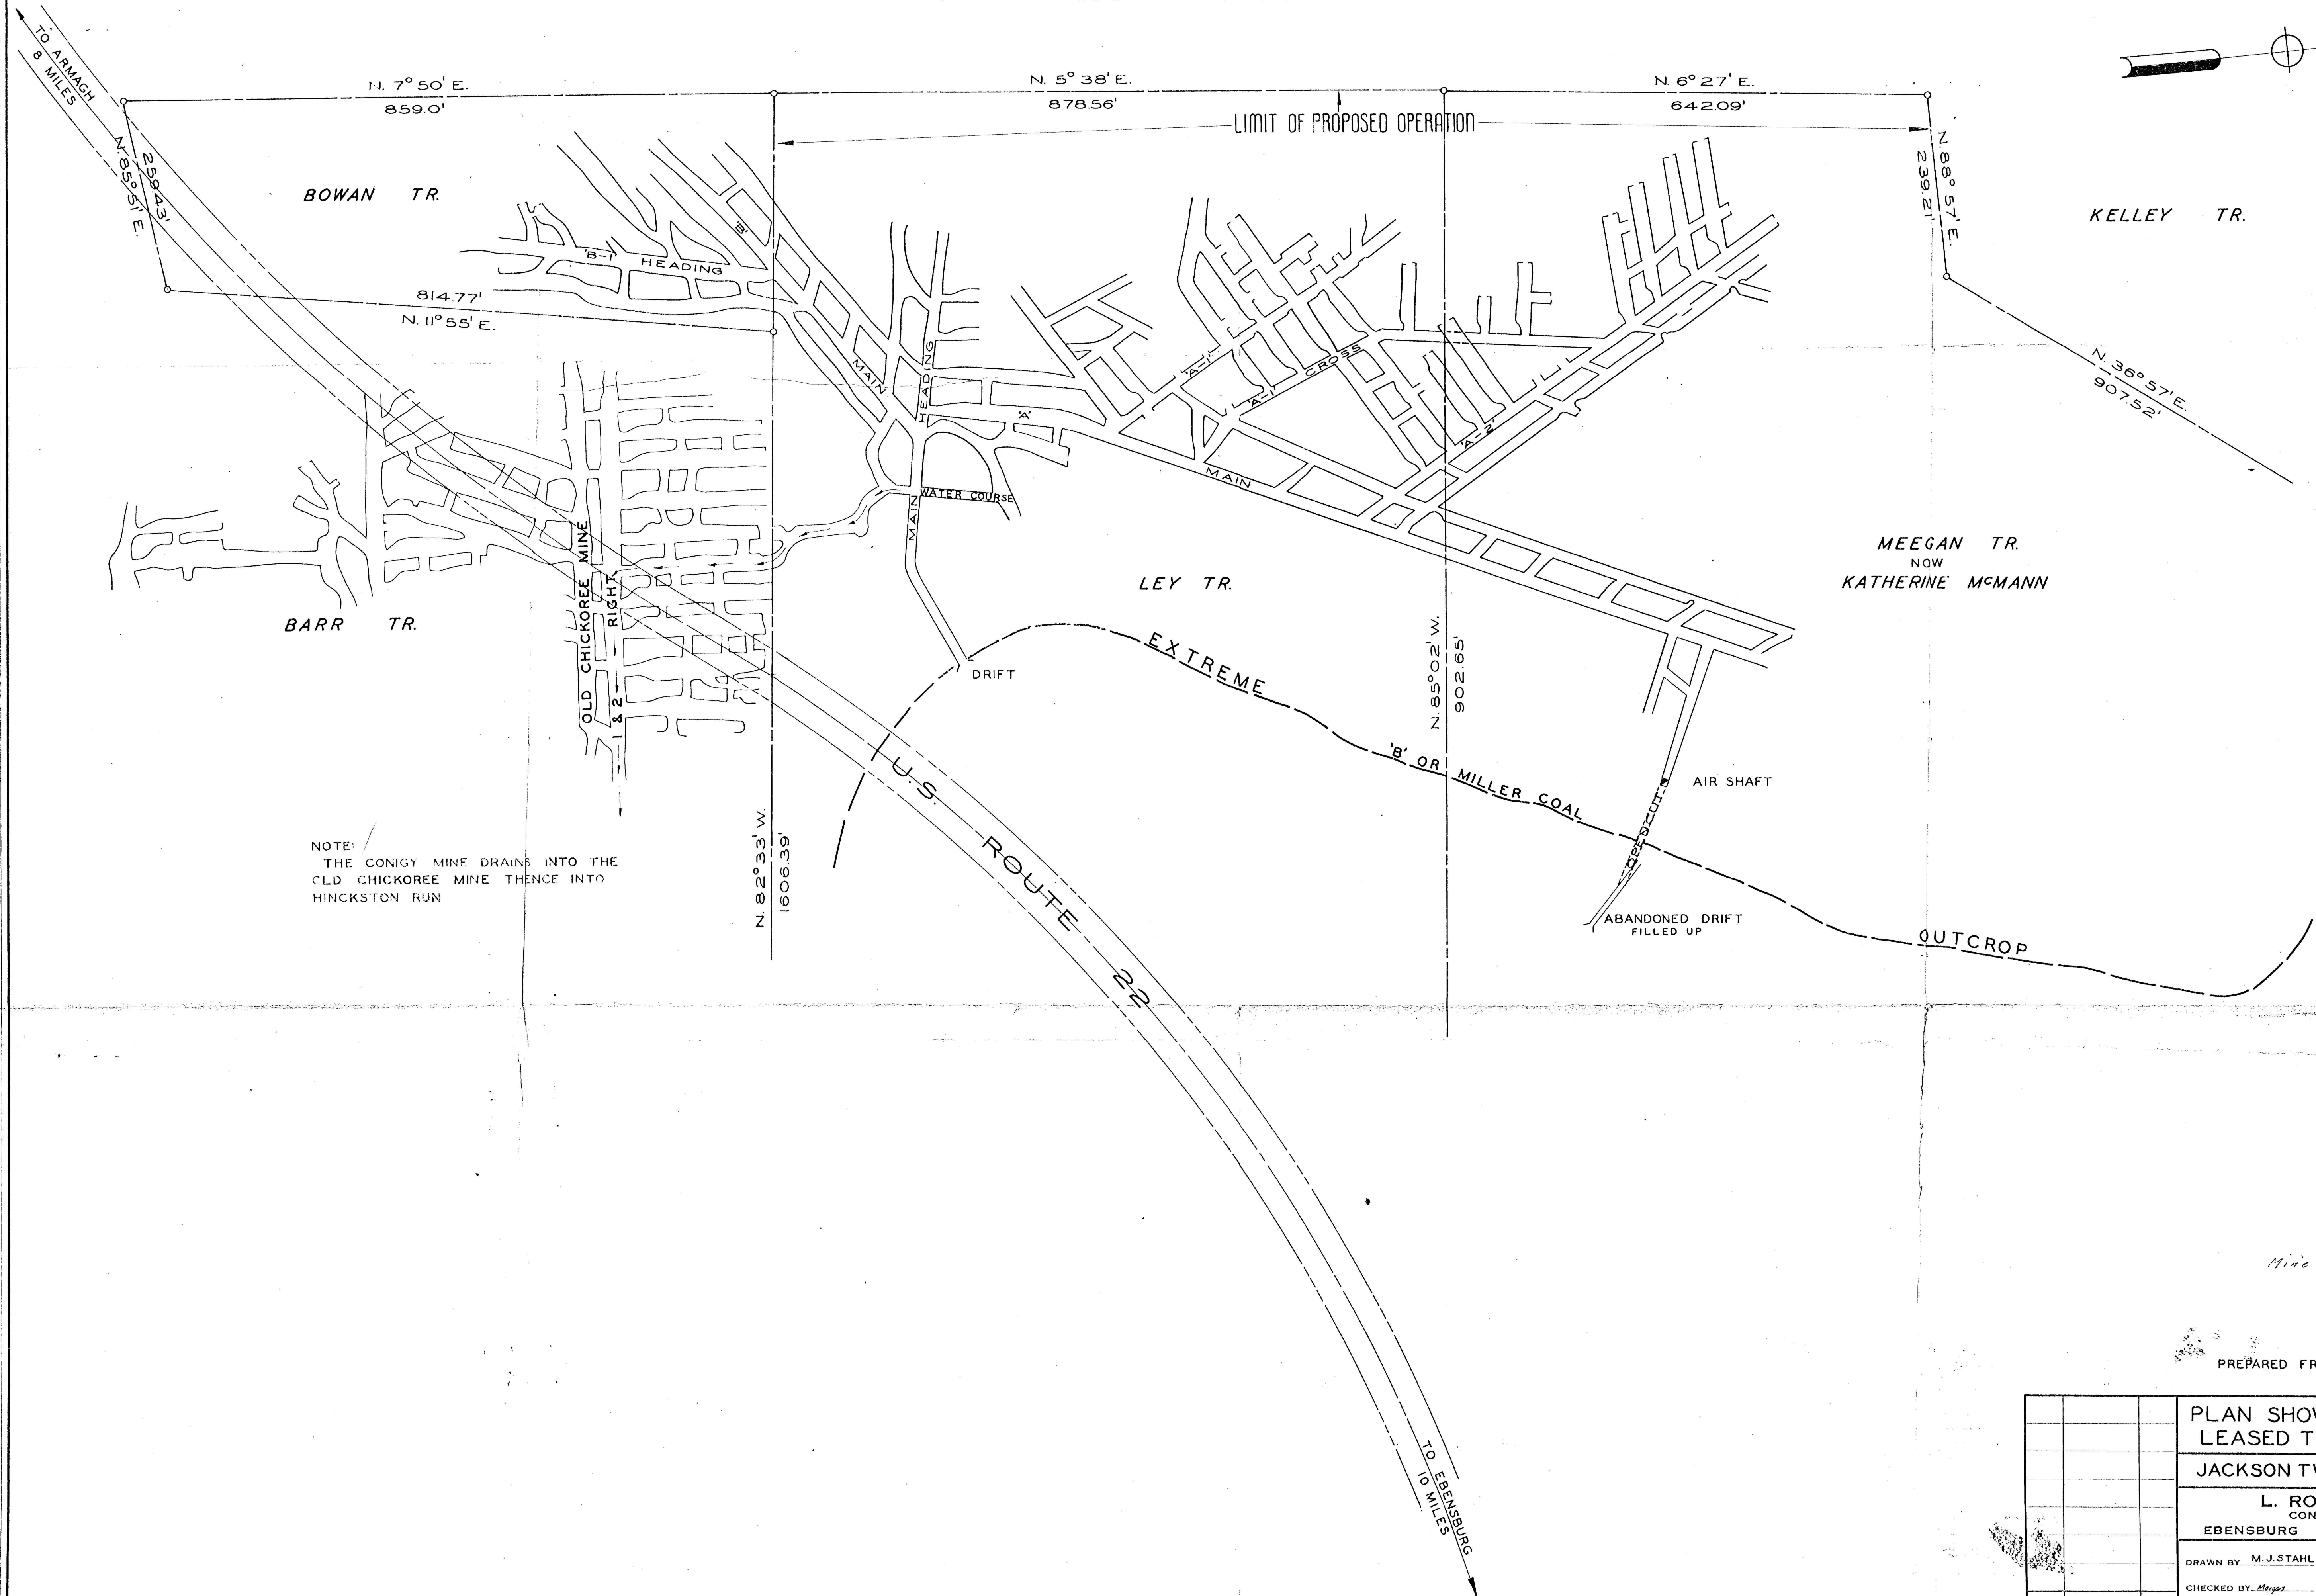


VINTON COLLIERY COMPANY

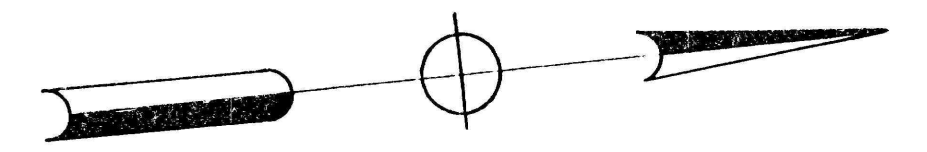

NOTE:
THE CONIGY MINE DRAINS INTO THE
OLD CHICKOREE MINE THENCE INTO
HINCKSTON RUN

Mine Drainage 28-1958

PREPARED FROM PLANS BY OTHERS

PLAN SHOWING MEEGAN MINE LEASED TO LEONARD CONIGY			
JACKSON TWP. CAMBRIA CO. PA.			
L. ROBERT KIMBALL CONSULTING ENGINEER			
EBENSBURG		PENNSYLVANIA	
DRAWN BY: M. J. STAHL	DATE: 3-13-58	CODE NO.	SHEET NO.
CHECKED BY: <i>Stegor</i>	DATE: 3/19/58	SCALE	1"=100'
APPROVED BY:	DATE:		OF