


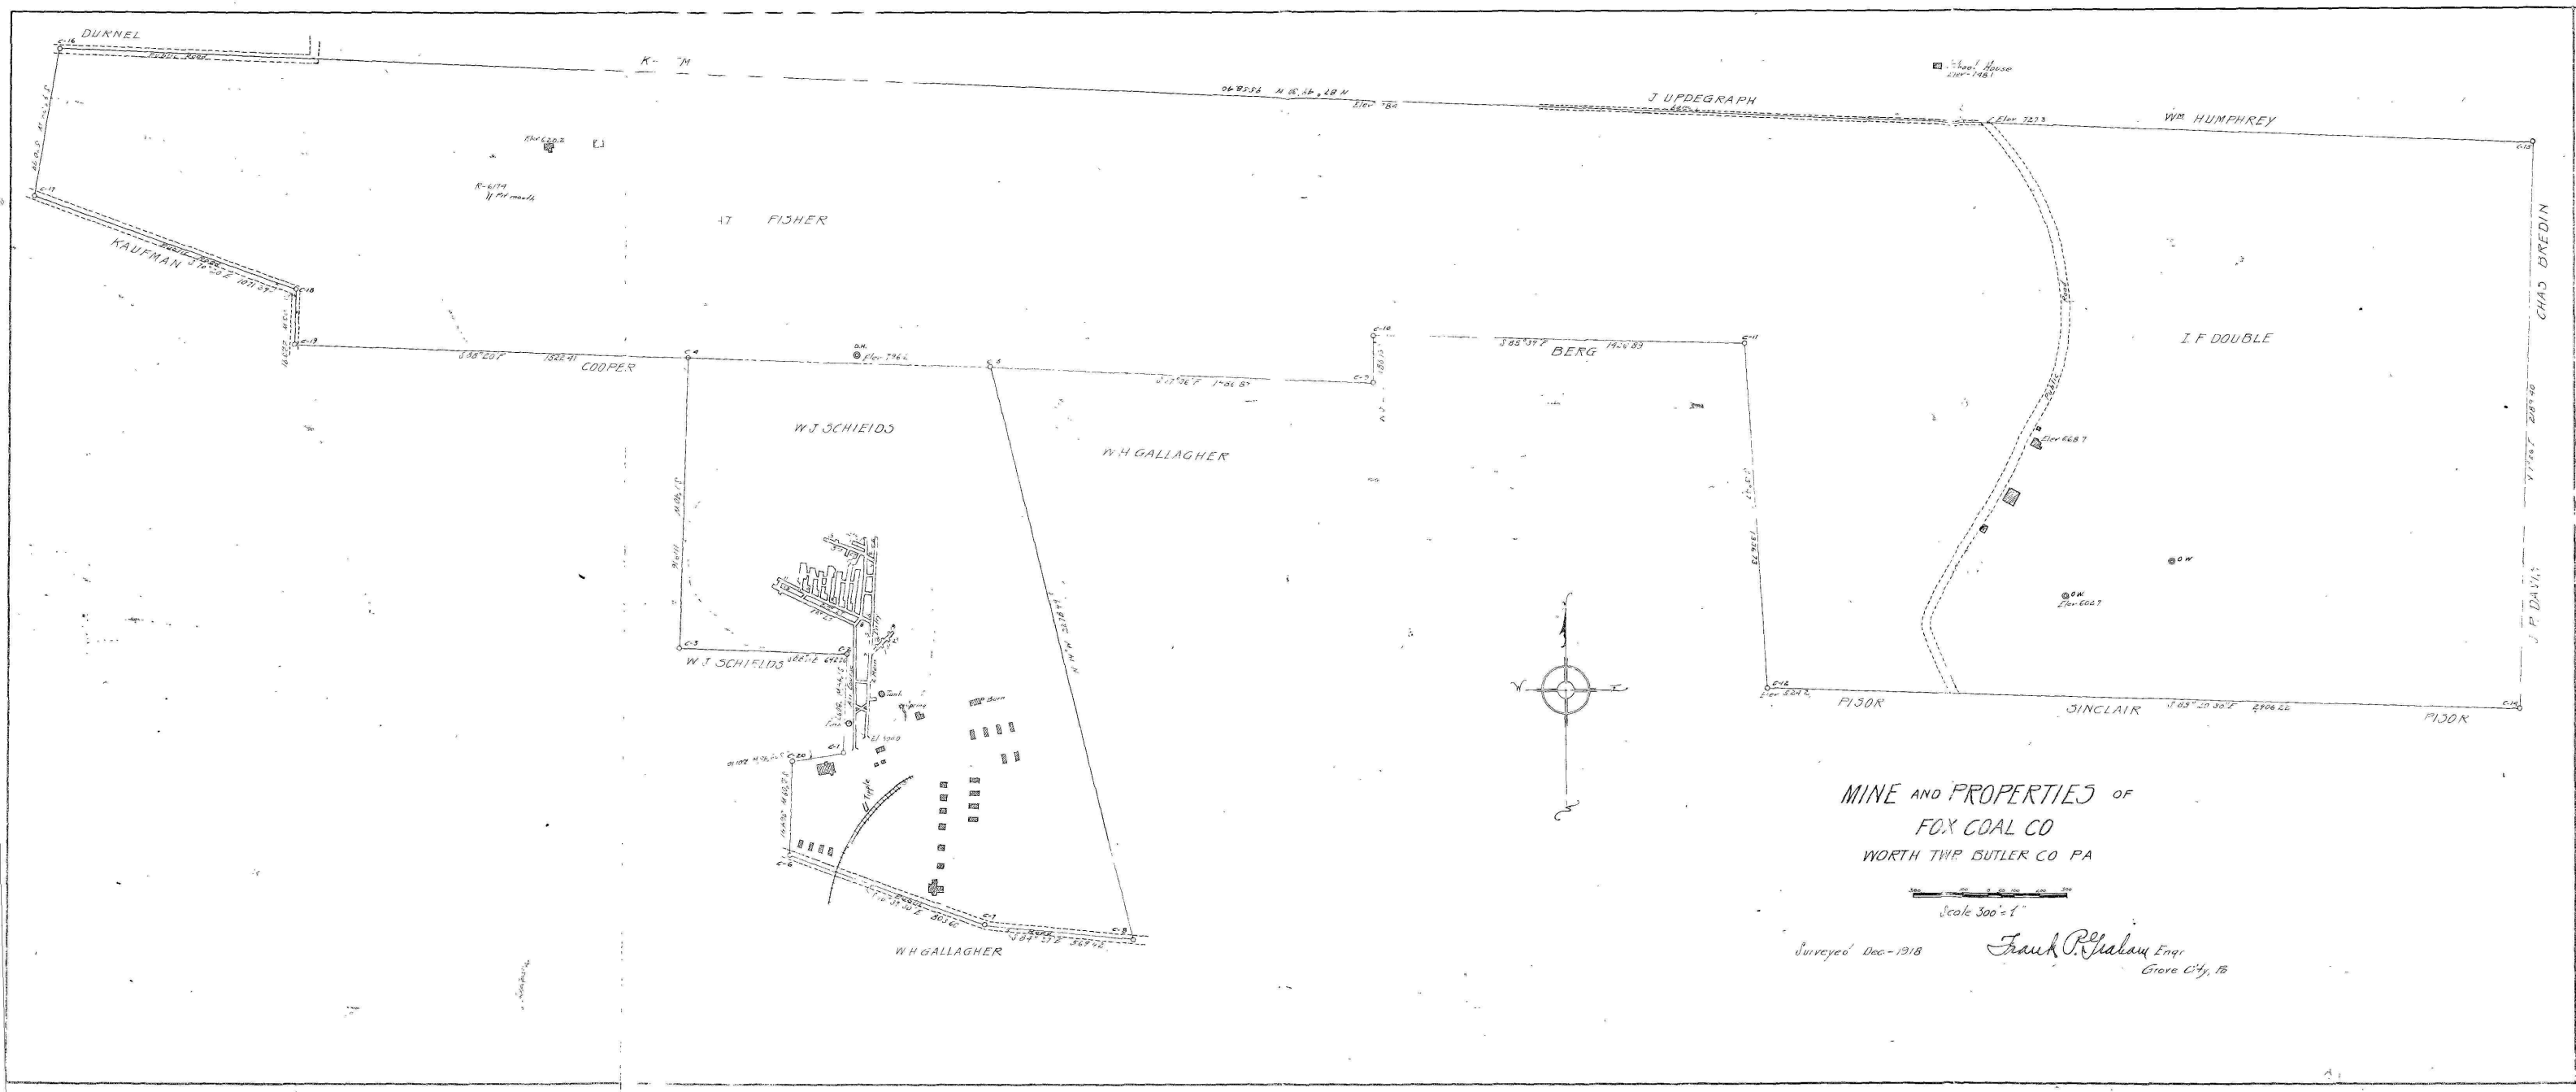

MINE AND PROPERTIES OF
FOX COAL CO
WORTH TWP. BUTLER CO. PA

Scale 300' = 1"

Surveyed Dec-1918

Frank P. Graham Engr.
Grove City, Pa.