


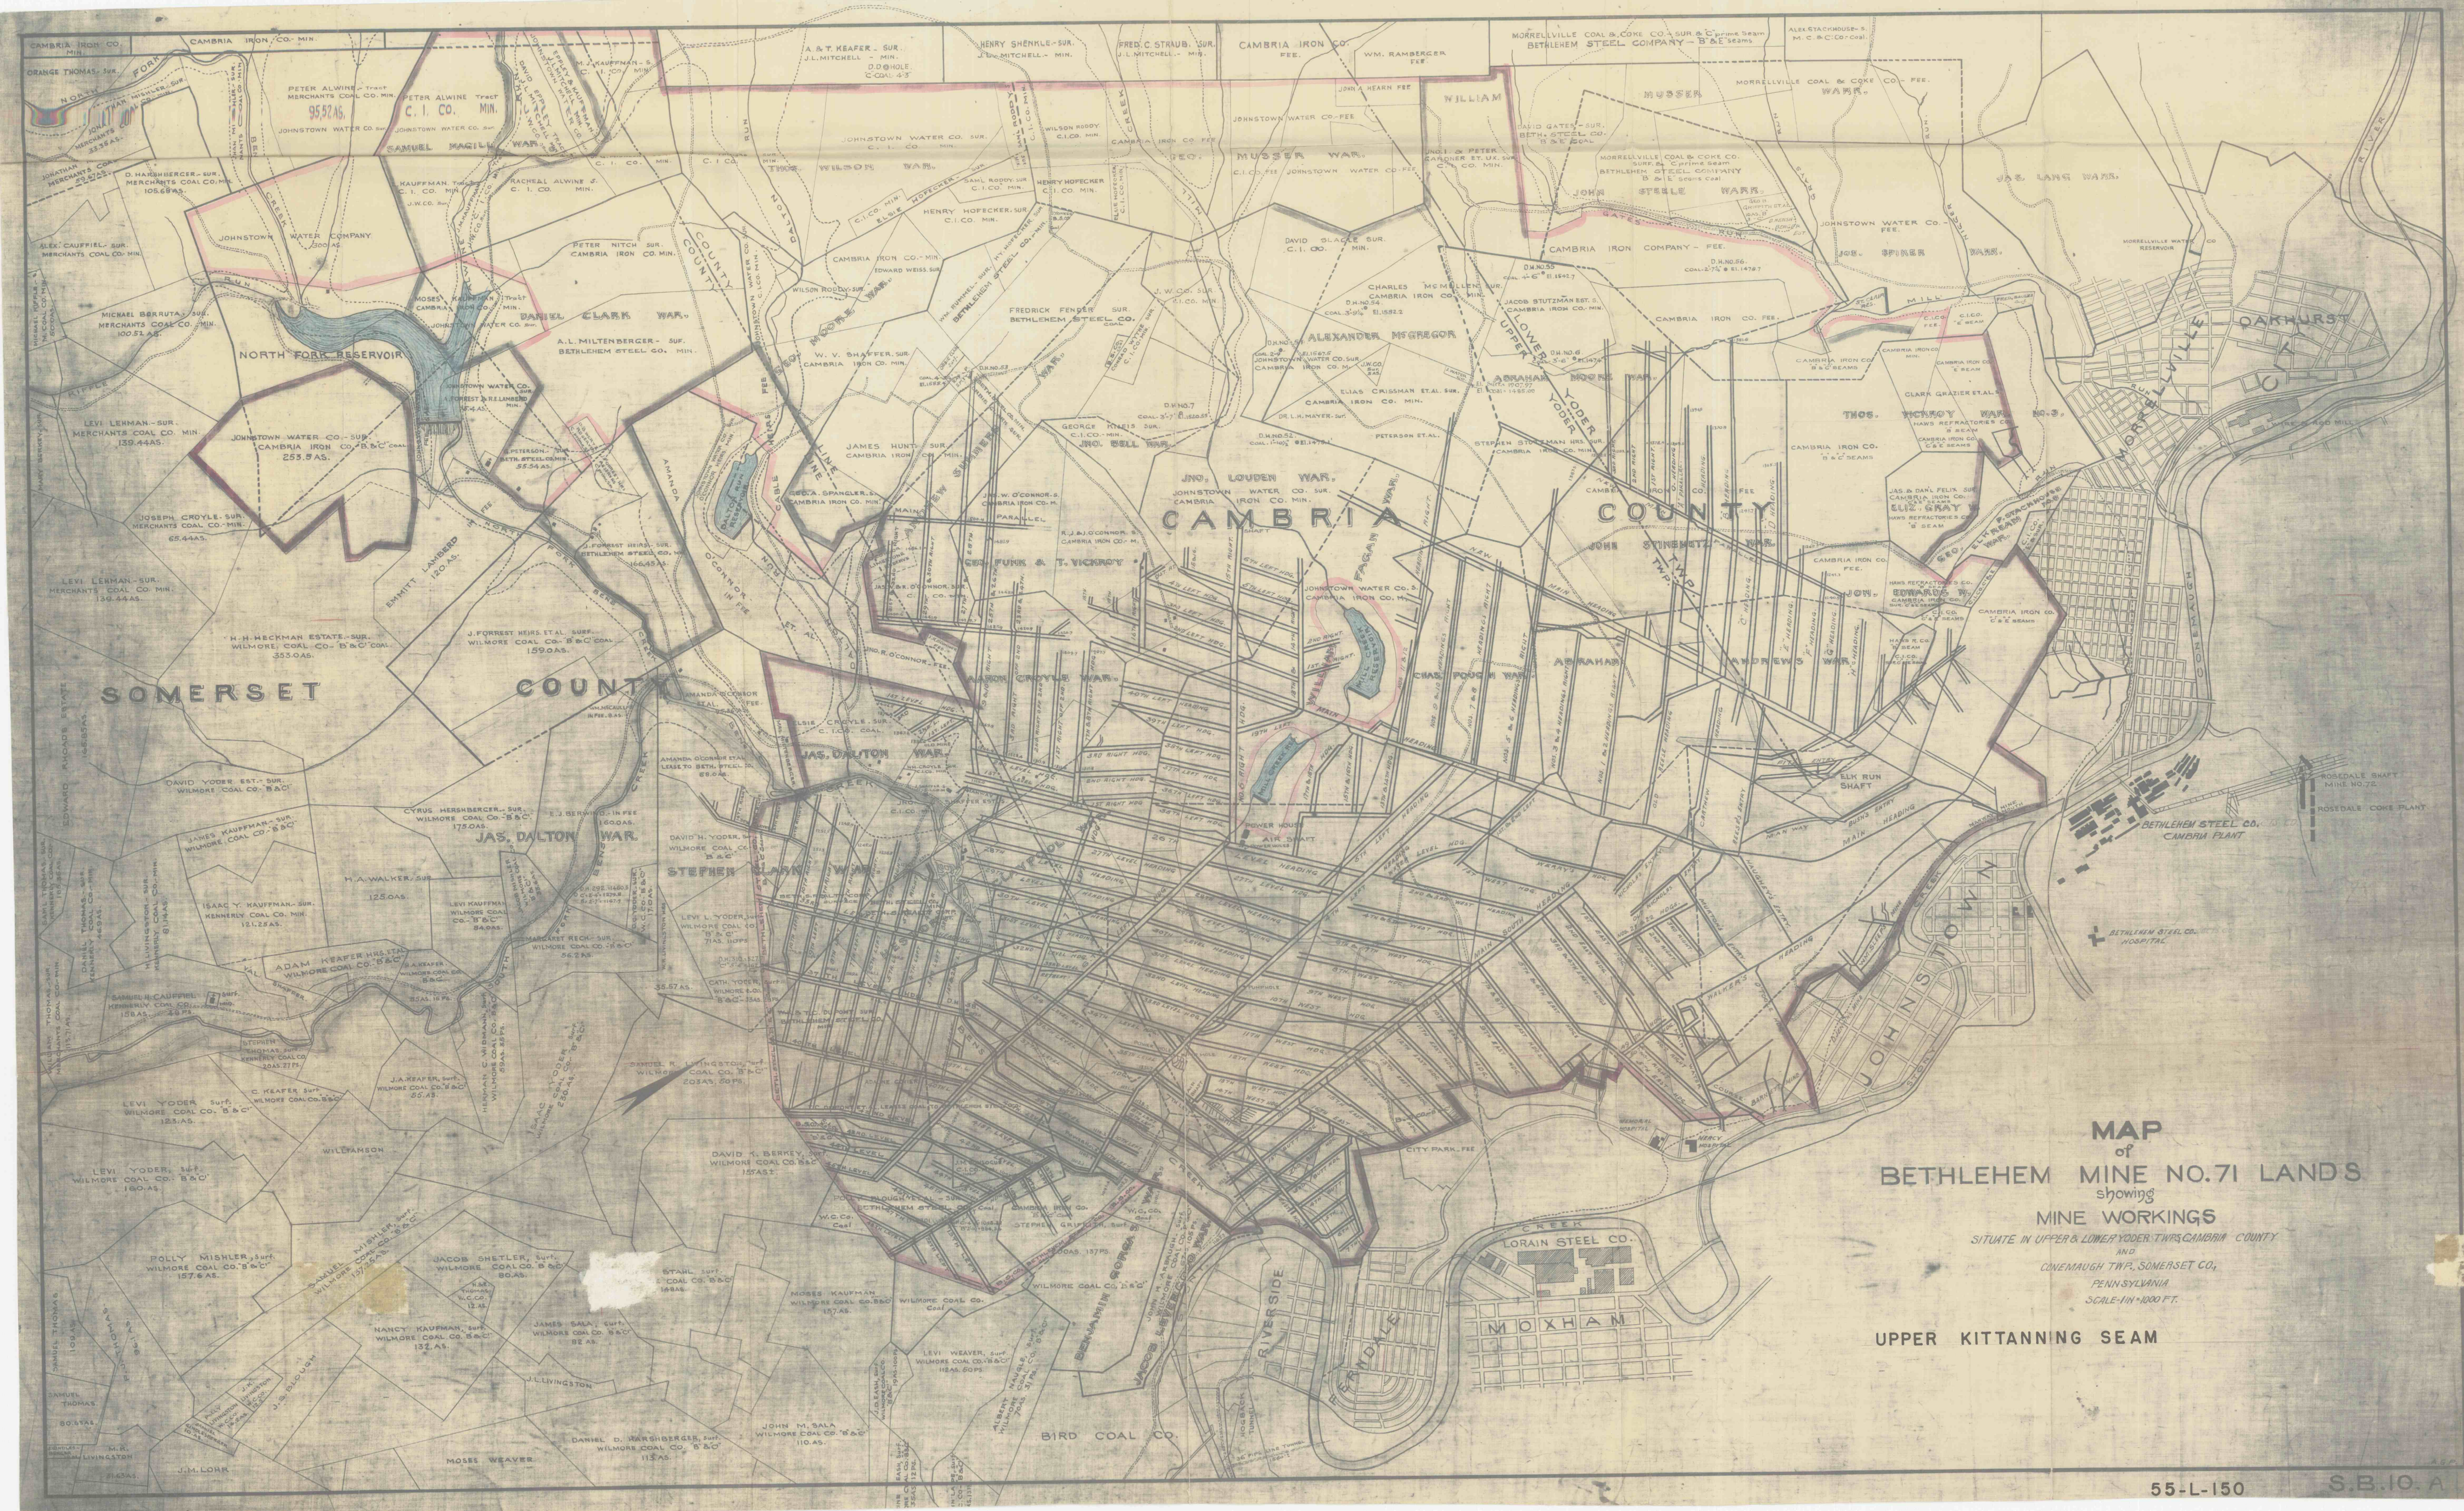

MAP
of
BETHLEHEM MINE NO. 71 LANDS
showing
MINE WORKINGS
SITUATE IN UPPER & LOWER YODER TOWNSHIPS, CAMBRIA COUNTY
AND
CONEMAUGH TWP., SOMERSET CO.,
PENNSYLVANIA
SCALE 1"=1000 FT.
UPPER KITTANNING SEAM