


PERMIT AREA
CONT. MINING
SUPPORT AREA
PROTECTED STRUCTURE
MINING COMPLETED

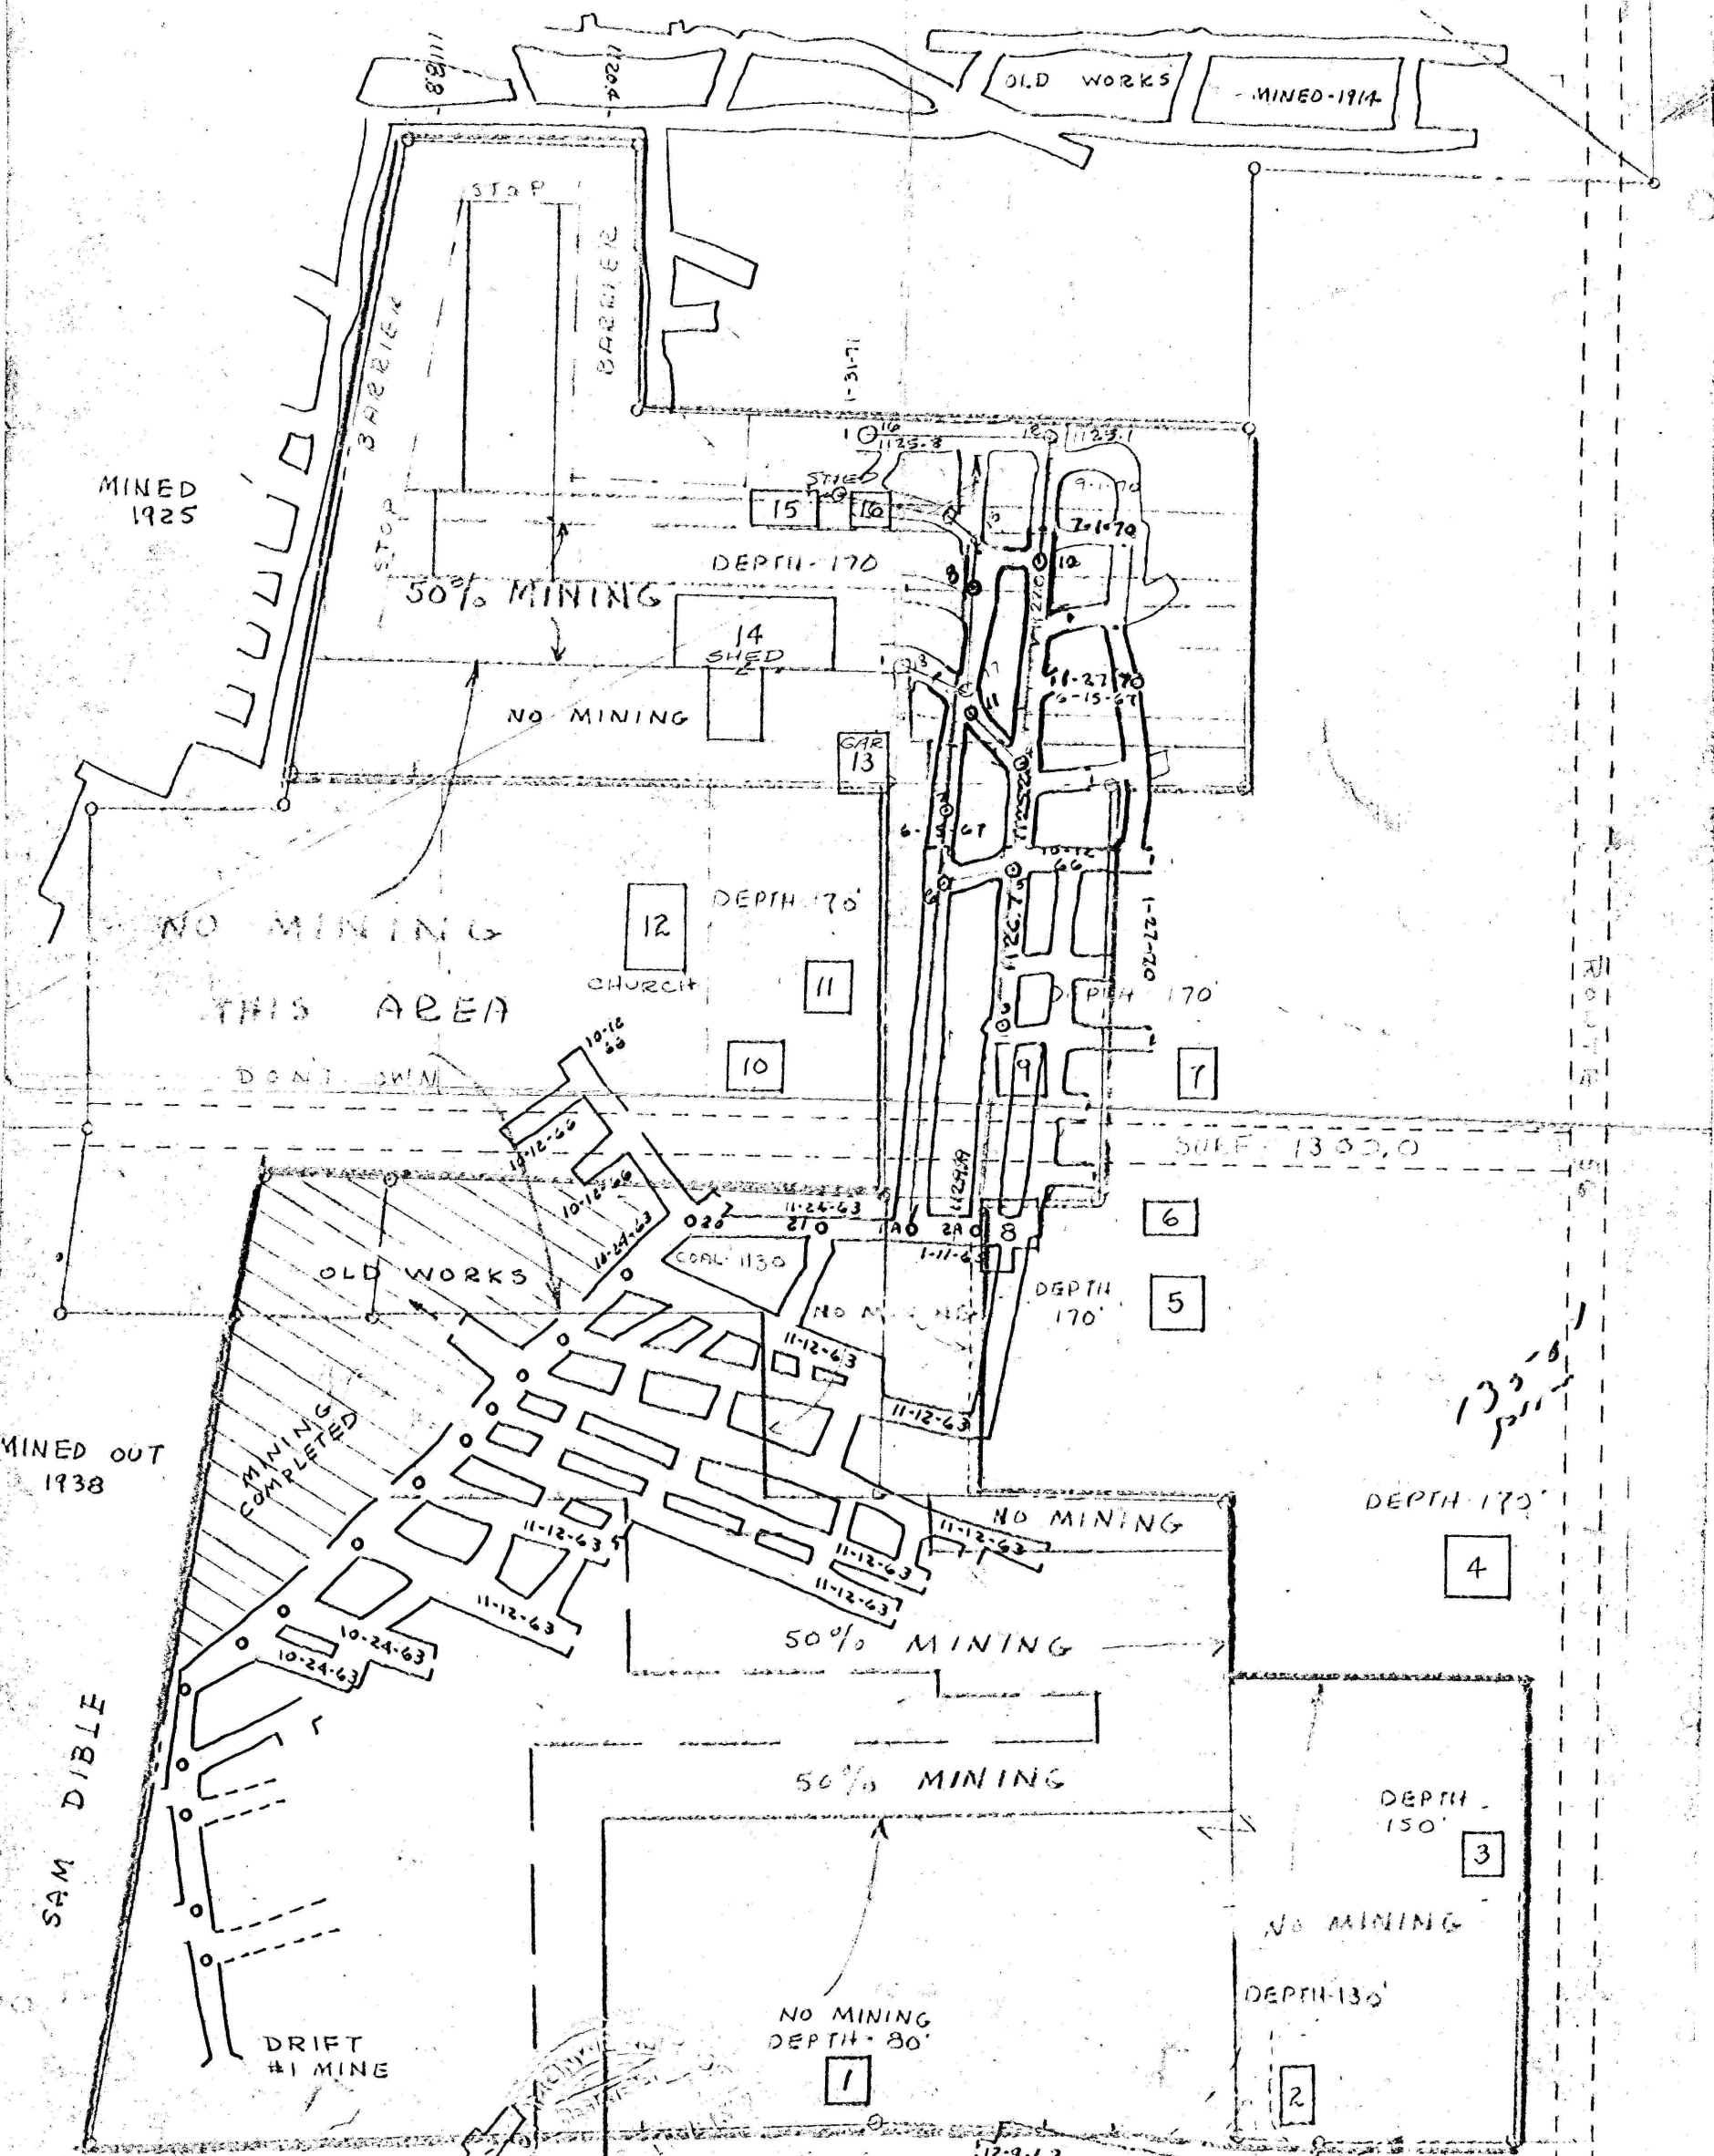

McCracken Coal Co.
McCracken #1 Mine
Young, Twp., Indiana Co., Pa.
Scale 1" = 100'
Revised June 15, 1967
Revised Dec 15, 1967

REVISED - JAN. 27, 1968
POSTED JUNE 19, 1968 (NO MINING)
REVISED 1-27-70

2-22-71 Charles S. Kautsky