


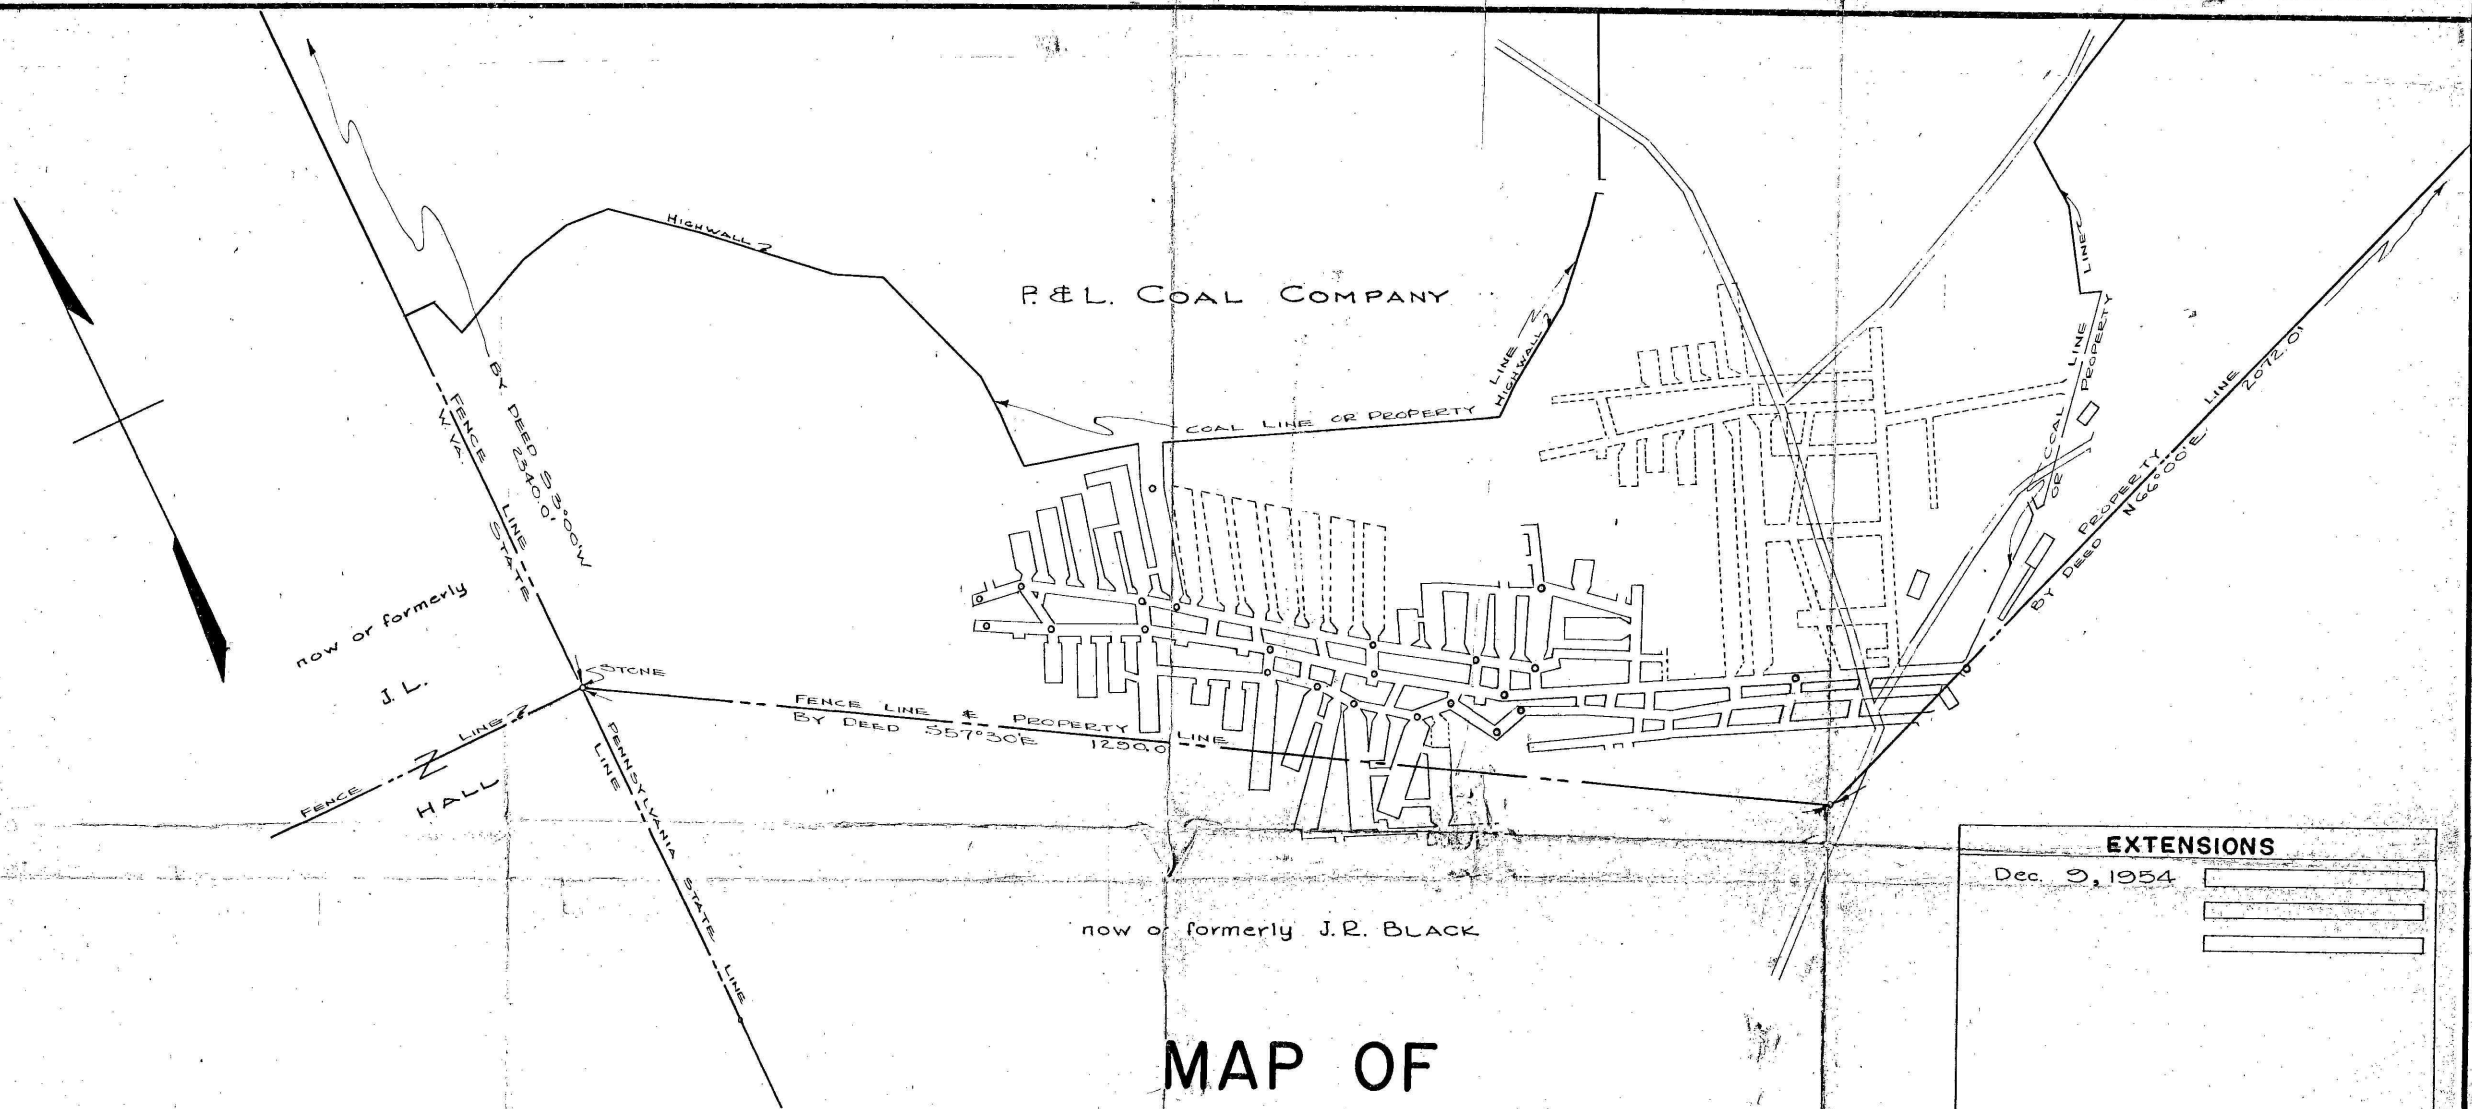


SCALE IN FEET
0 100 200 300 400 500 600

Alexander Coal Co.
"Alexander"
1957 Annual

11-10-1958
Garrett, Md.

Dist. 26.
1956

I hereby certify that this map is true and correct
to the best of my knowledge and belief.

James S. Schellhase W. Va. Reg. Engr. No. 1673

Acknowledged before me a Notary Public this 9th
day of September 1957.

James S. Schellhase
Notary Public for, in and for
Ohio County, West Virginia

My commission expires:

Oct. 18, 1965

EXTENSIONS	
Dec. 9, 1954	