FINAL MAP

SHEET NO. 1

Tri-Ent Inc.
Bren-Mar Mine
Dunkard Twp.; Greene Co.; PA
Scale 1"=100 Ft.

North

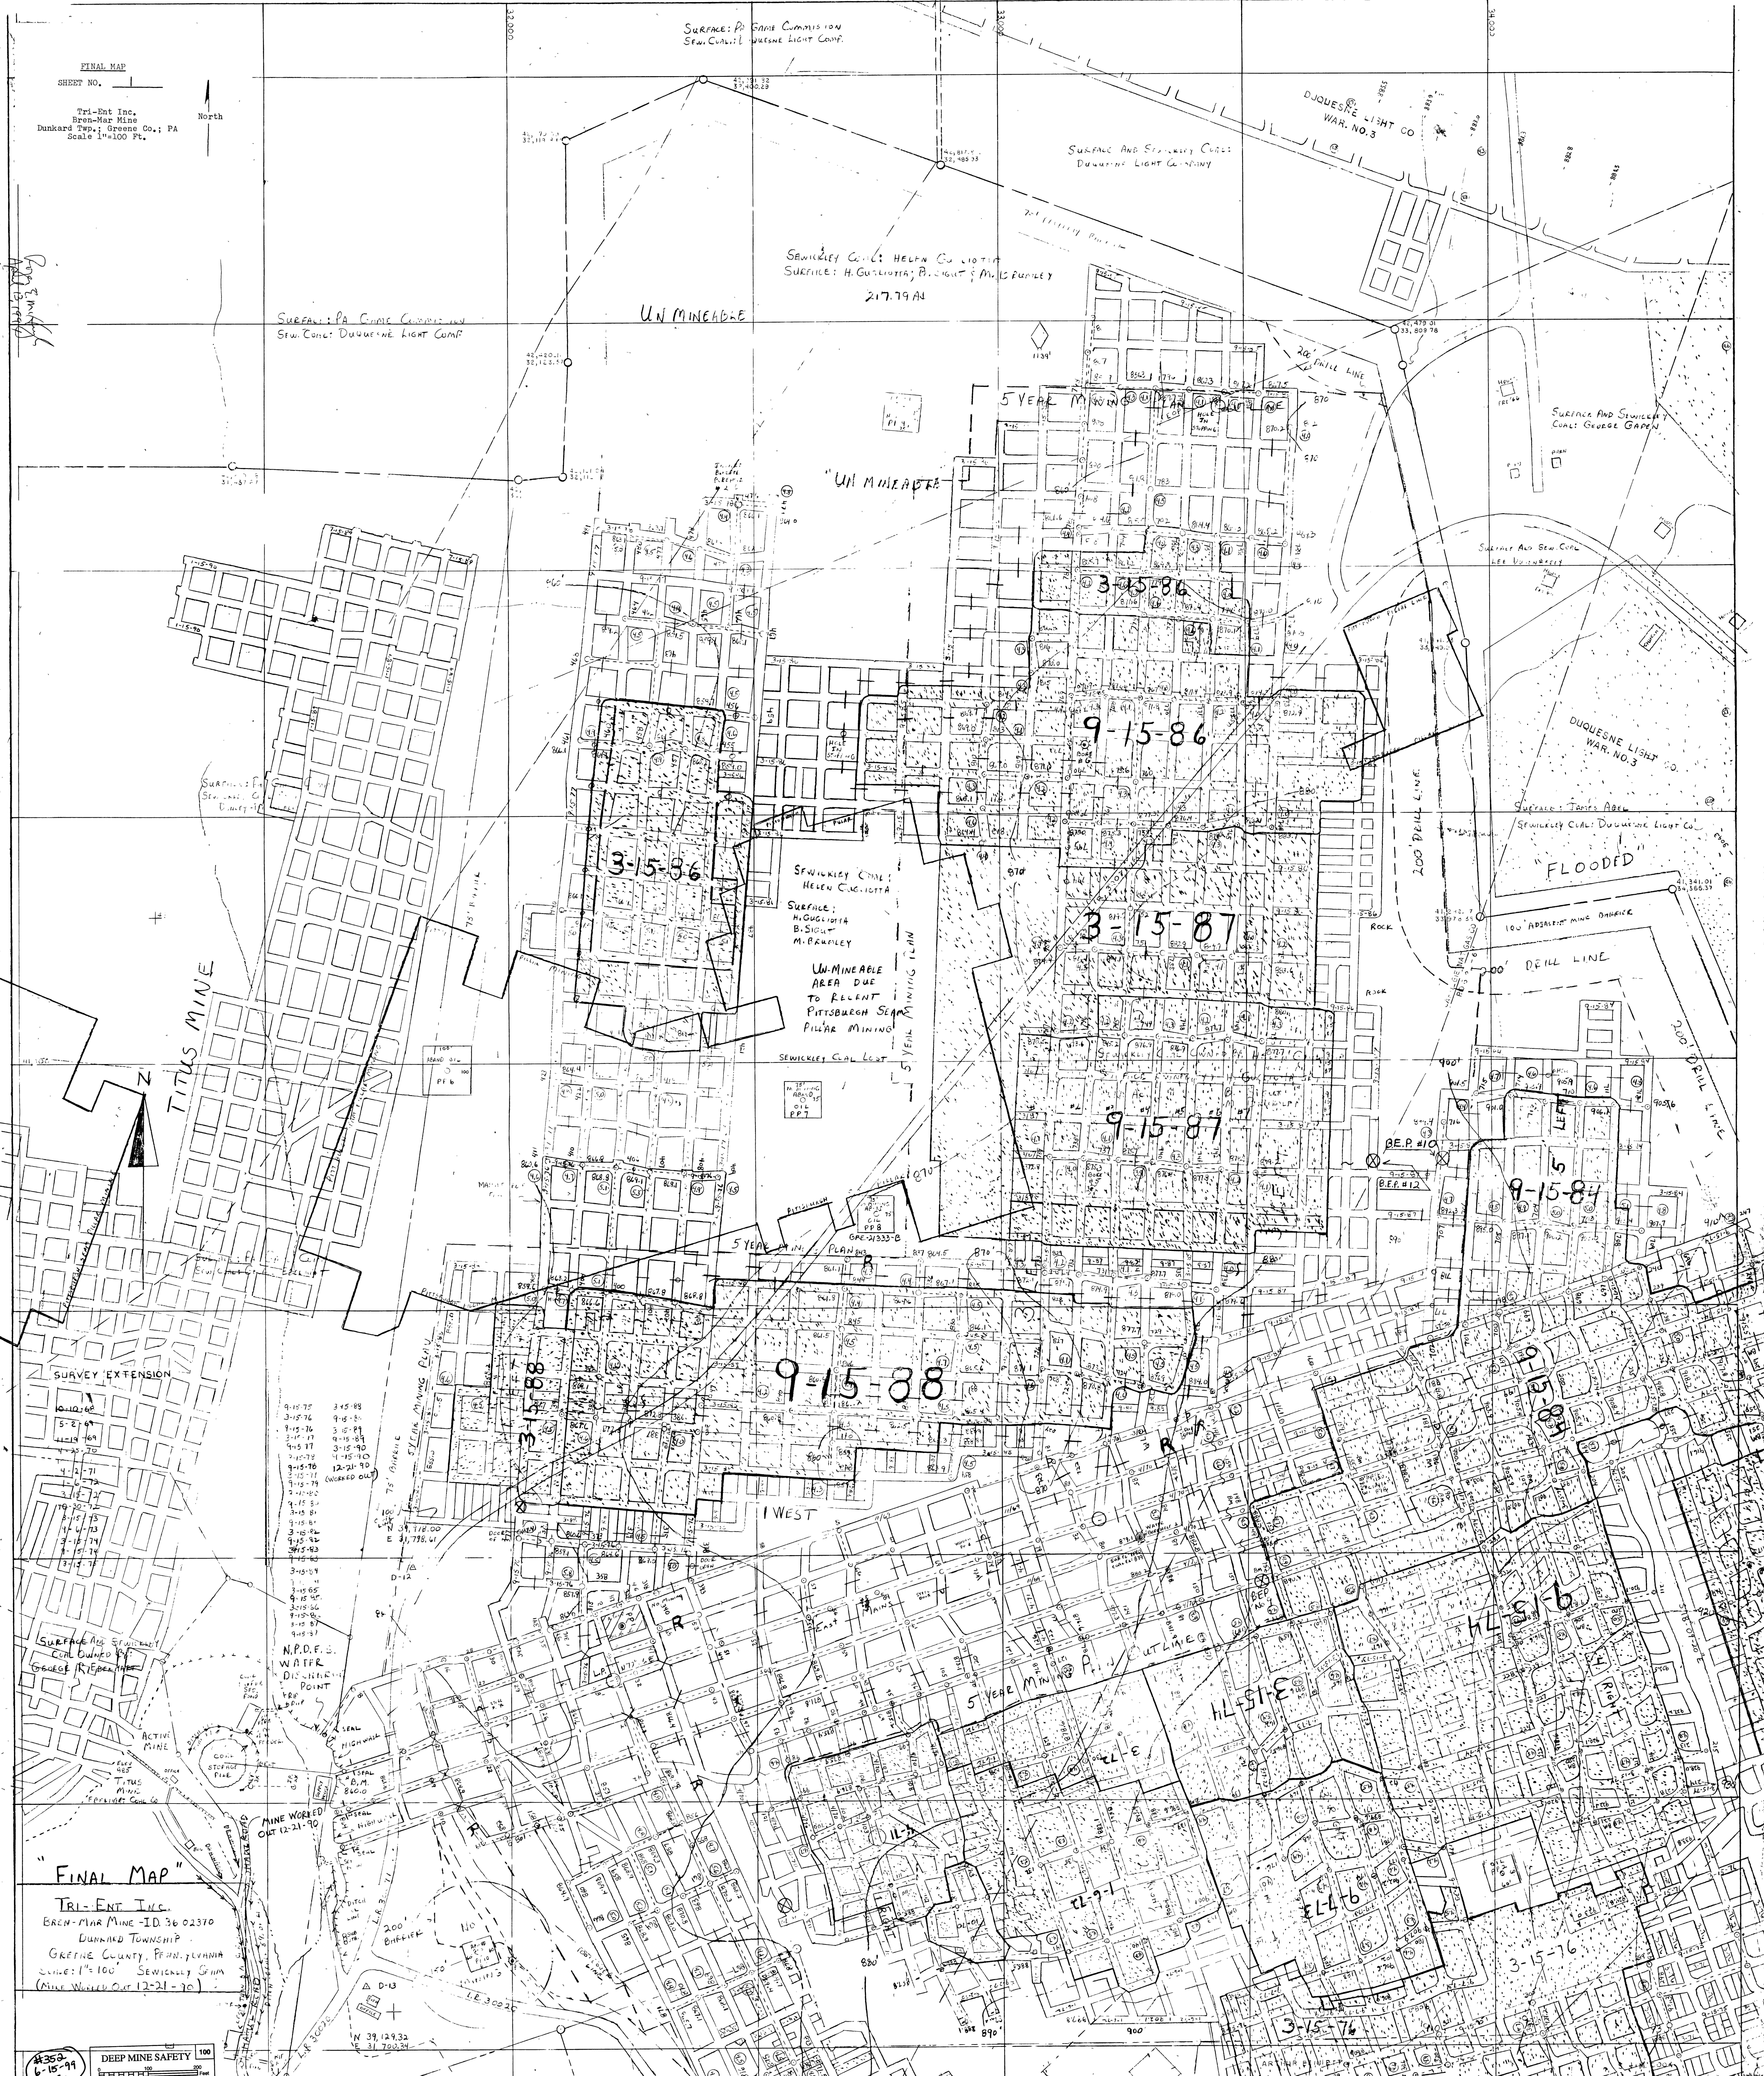
32,000
33,000
34,000
Surface: PA Game Commision
Sew. Coal: Duquesne Light Comp.
43,391.32
32,400.29
46,817.8
32,485.33
Duquesne Light Co
War. No. 3
Surface And Sewickley Coal: Duquesne Light Company
Sewickley Coal: Helen Gugliotta
Surface: H. Gugliotta; B. Sigut & M. Brumley
217.79 Ac
Surface: PA Game Commission
Sew. Coal: Duquesne Light Comp
Un Mineable
"Un Mineable"
42,420.11
32,123.57
42,479.01
33,809.78
1139'
200' Drill Line
5 Year Mining Plan Outline
Surface And Sewickley Coal: George Gapen
Surface And Sew. Coal Lee Vunnrfeldt
Pittsburgh Pillar Line
3-15-86
9-15-86
Bore #6
Duquesne Light Co.
War. No. 3
Surface: James Abel
Sewickley Coal: Duquesne Light Co.
"Flooded"
41,341.01
34,366.37
100' Adjacent Mine Barrier
200' Drill Line
Rock
3-15-87
9-15-87
Sewickley Coal Owned By H. Gugliotta
Sewickley Coal: Helen Gugliotta
Surface: H. Gugliotta B. Sigut M. Brumley
Un-Mineable Area Due To Recent Pittsburgh Seam Pillar Mining
Sewickley Coal Lost
5 Year Mining Plan
Titus Mine
N
75' Barrier
Pittsburgh Seam Pillar Mining
100' Aband. Oil PF 6
75' No Mining Aband. Oil PP 7
75' No Mining Aband. Oil PP 8
GRE-21333-B
B.E.P. #10
B.E.P. #12
9-15-84
Left
200' Drill Line
9-15-88
3-15-88
1 West
Survey Extension
10-10-68
5-2-69
11-19-69
4-25-70
4-2-71
1-6-72
3-15-72
10-30-72
3-15-73
9-6-73
3-15-74
9-15-74
3-15-75
9-15-75
3-15-76
9-15-76
3-15-77
9-15-77
3-15-78
9-15-78
3-15-79
9-15-79
3-15-80
9-15-80
3-15-81
9-15-81
3-15-82
9-15-82
3-15-83
9-15-83
3-15-84
9-15-84
3-15-85
9-15-85
3-15-86
9-15-86
3-15-87
9-15-87
3-15-88
9-15-88
3-15-89
9-15-89
3-15-90
9-15-90
12-21-90 (Worked Out)
N 39,918.00
E 31,798.61
D-12
100' Coal Line
Surface And Sewickley Coal Owned By George R. Eberhart
N.P.D.E.S. Water Discharge Point
Active Mine
Coal Storage Pile
Titus Mine Eberhart Coal Co
Elev 985
Office
Seal
Highwall
Seal
B.M. 860.0
Mine Worked Out 12-21-90
Haul Road
200' Barrier
No Mining
Aband. Oil PF 10
L.R. 30020
D-13
Office
N 39,129.32
E 31,700.34
East Mains
R
Water Borehole
BEP No. 9
5 Year Mining Plan Outline
9-15-84
9-15-85
3-15-73
9-15-73
9-6-72
3-15-74
9-7-73
3-15-76
880'
890'
900'
Right
Arthur Bennett

"Final Map"

Tri-Ent Inc.
Bren-Mar Mine - I.D. 36 02370
Dunkard Township
Greene County, Pennsylvania
Scale: 1"=100' Sewickley Seam
(Mine Worked Out 12-21-90)

DEEP MINE SAFETY 100
0 100 200 Feet

#352
6-15-99

Roger E. Kinkead
April 13, 1999