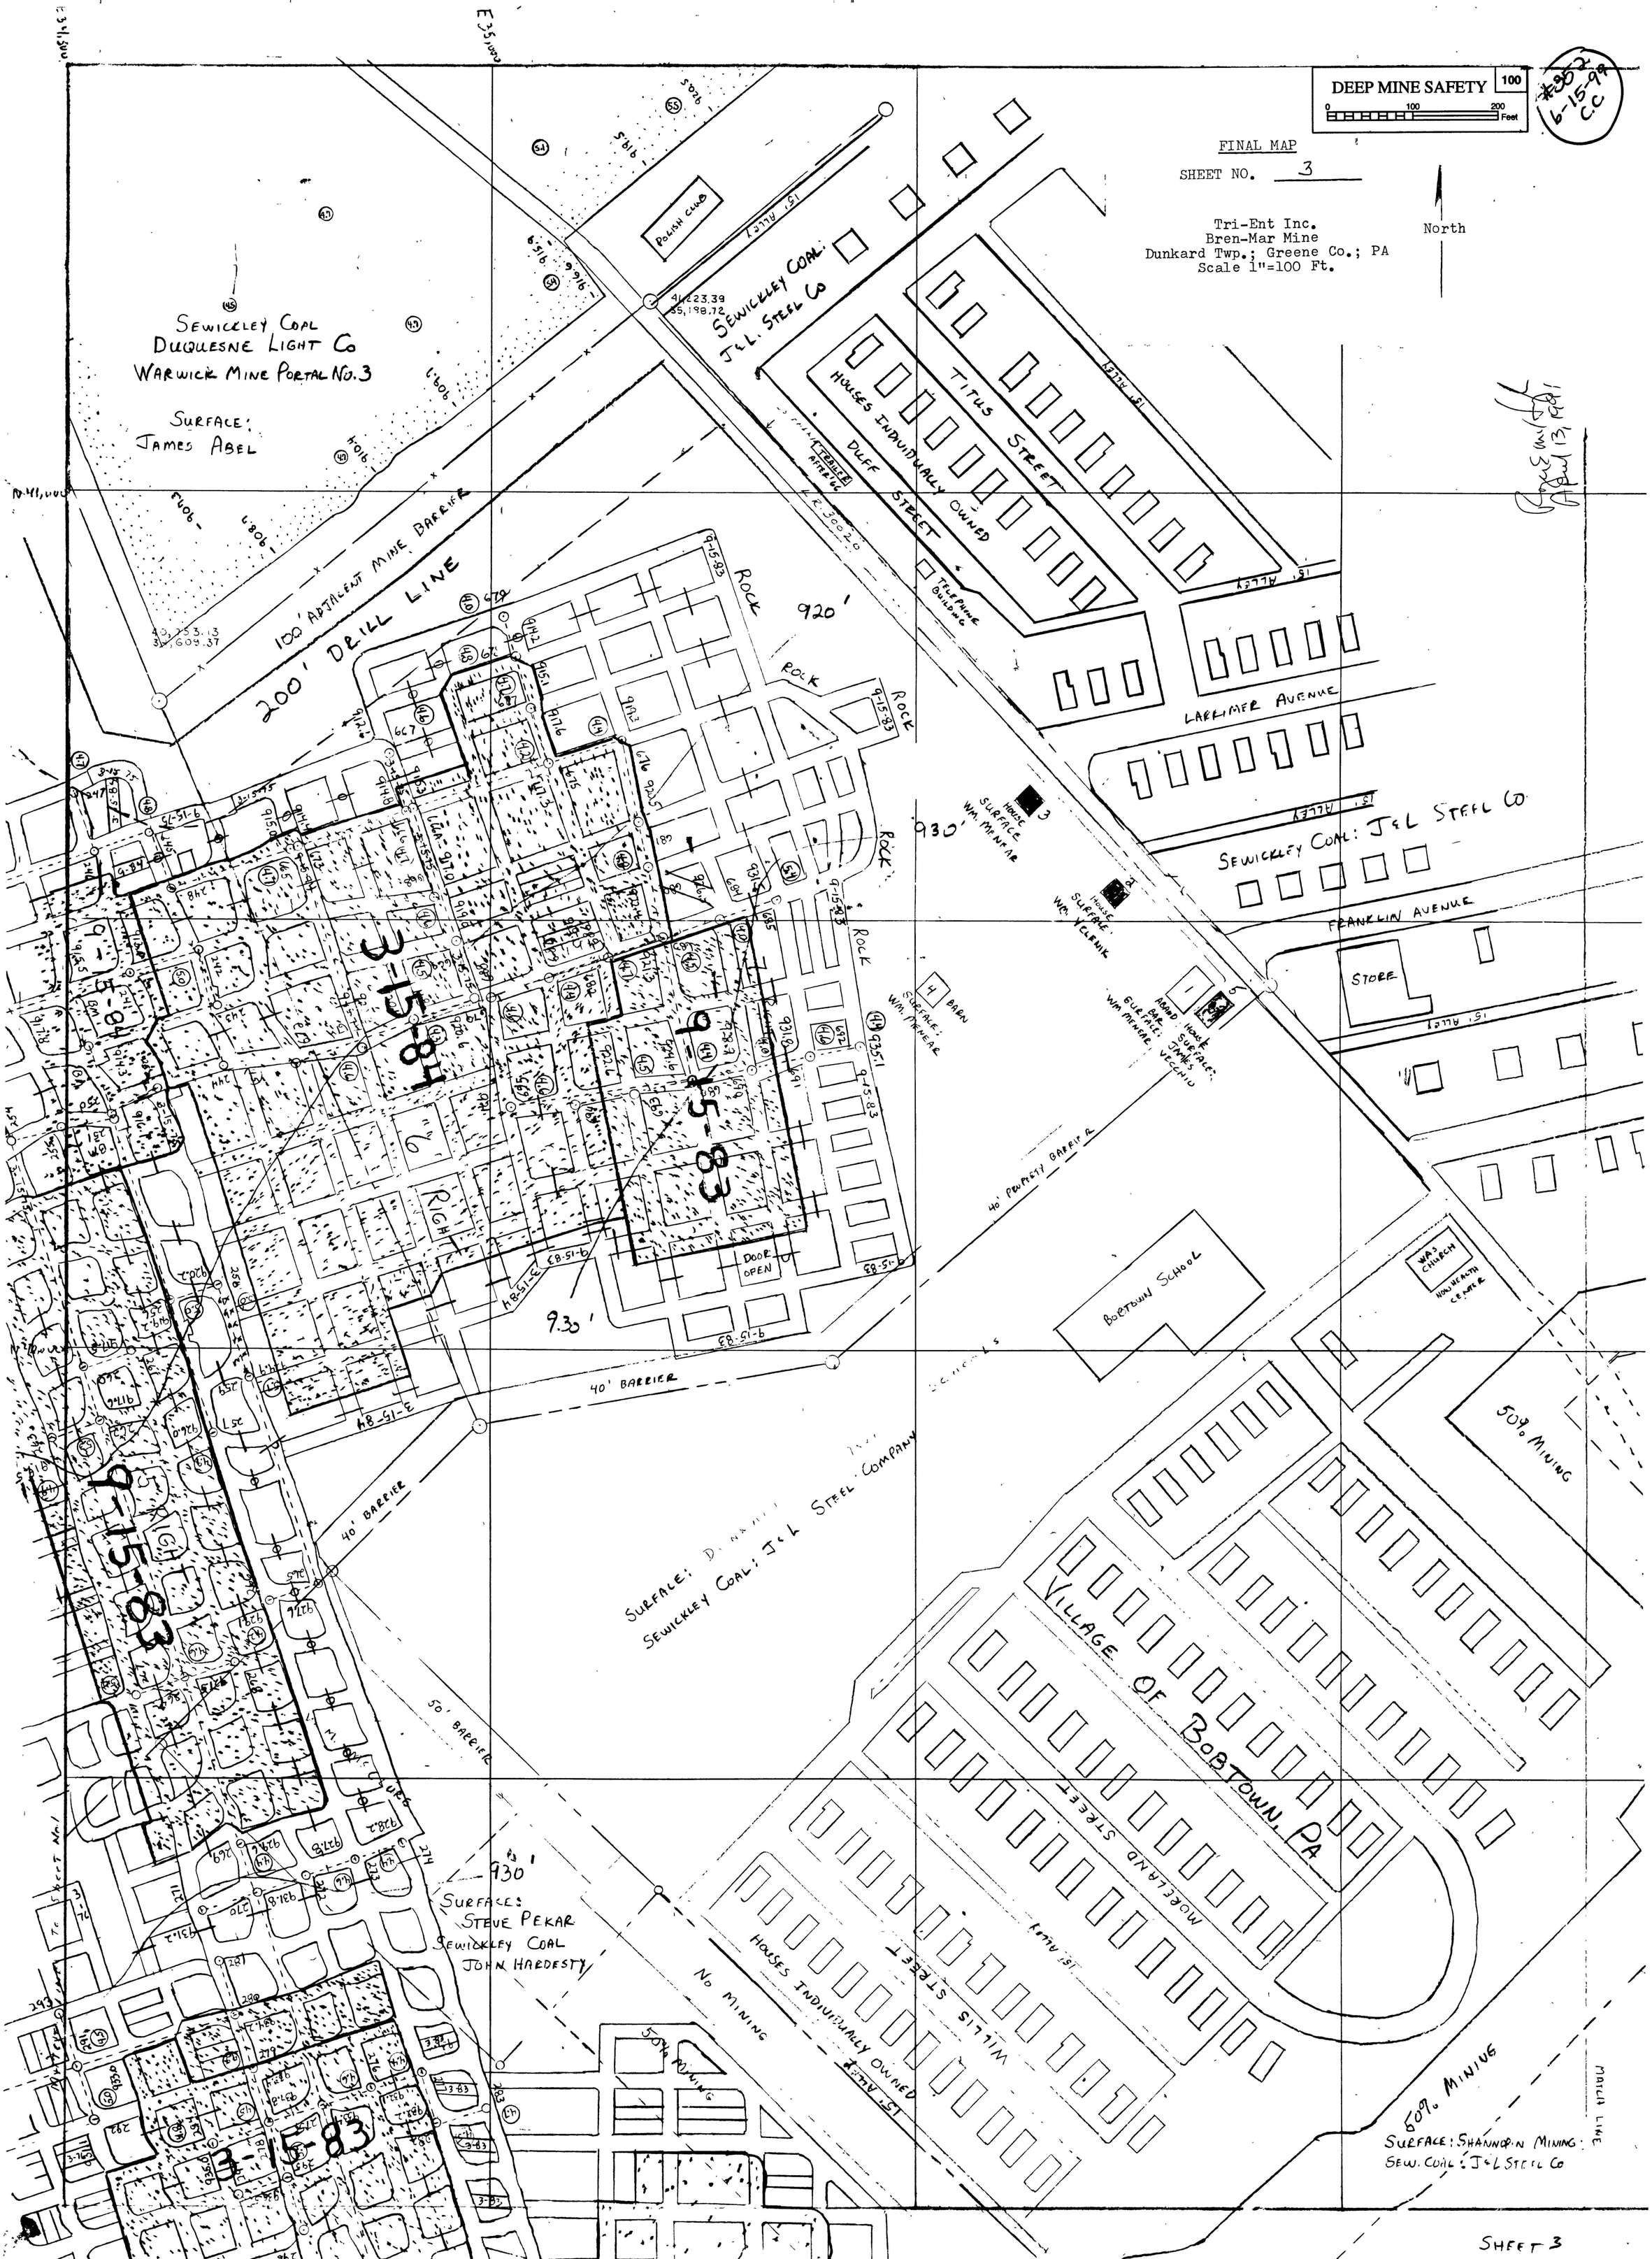
DEEP MINE SAFETY
100
0 100 200 Feet
FINAL MAP
SHEET NO. 3
Tri-Ent Inc.
Bren-Mar Mine
Dunkard Twp.; Greene Co.; PA
Scale 1"=100 Ft.
North
SEWICKLEY COAL
DUQUESNE LIGHT CO
WARWICK MINE PORTAL NO. 3
SURFACE:
JAMES ABEL
POLISH CLUB
SEWICKLEY COAL:
J&L STEEL CO
HOUSES INDIVIDUALLY OWNED
DUFF STREET
TITUS STREET
TELEPHONE BUILDING
100' ADJACENT MINE BARRIER
200' DRILL LINE
ROCK
920'
930'
LARRIMER AVENUE
SEWICKLEY COAL: J&L STEEL CO
FRANKLIN AVENUE
STORE
HOUSE SURFACE WM. MENEAR
HOUSE SURFACE WM. YCLENIK
BARN SURFACE: WM. MENEAR
BAR & GAS SURFACE: WM MENEAR
HOUSE SURFACE: JAMES VECCHIO
40' PROPERTY BARRIER
BOBTOWN SCHOOL
WAS CHURCH NOW HEALTH CENTER
40' BARRIER
SURFACE: D
SEWICKLEY COAL: J&L STEEL COMPANY
50% MINING
VILLAGE OF BOBTOWN, PA
MOELAND STREET
WILLIS STREET
HOUSES INDIVIDUALLY OWNED
NO MINING
SURFACE: STEVE PEKAR
SEWICKLEY COAL
JOHN HARDESTY
SURFACE: SHANNOPIN MINING
SEW. COAL: J&L STEEL CO
MARSH LINE
3-15-83
SHEET 3