

N 39,000

SURFACE: SEWICKLEY COAL;
GEORGE EBERHART

SEWICKLEY COAL - OUTCROP
SURFACE: SEWICKLEY COAL; ERNEST EVERY

DUNKARD CREEK

PAVED L.P. 30020

ORIGINAL SEWICKLEY SEAM OUTCROP

SEWICKLEY
SEAM
ABSENT

ABANDONED
DEAN
MINE
(NO WORKINGS
ON THIS
SHEET)

SURFACE: HERSCHEL MATHEWS
SEWICKLEY COAL: TARGET INDUSTRIES INC.

AREA STRIP MINED
BY GENOVESE COAL
COMPANY

N 38,000

OVER 200 FEET
WEST TO CLOSEST
OLD MINE ENTRY
OF THE ABANDONED
DEAN MINE

SURFACE: ART BENNETT
SEWICKLEY COAL: ERNEST EVERY
17.258/AL

SURFACE: ART BENNETT
SEWICKLEY COAL: ERNEST EVERY

SURFACE: SHANNOPIN MINING CO
SEWICKLEY COAL: JEL STEEL CO

SURFACE: ART BENNETT
SEWICKLEY COAL: JEL STEEL CO

1987
EMERALD
MINE


FINAL MAP

SHEET NO. 2

Tri-Ent Inc.
Bren-Mar Mine
Dunkard Twp.; Greene Co.; PA
Scale 1"=100 Ft.

North

DEEP MINE SAFETY

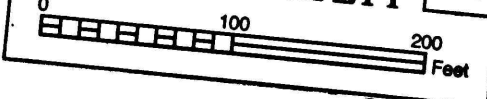

Rock Smith
April 13, 1991

#352
L-15-77
C.C.