

RICHARD M^cCOY

PENNA. STATE HIGHWAY ROUTE NO 857



Hegarty Roads
1/2 mi.

THOMAS SHROCK (surf)
M. M^cGLYNN (coal)


M. M^cGLYNN

SAMUEL HEGARTY EST.

D^{seam} Coal out crop

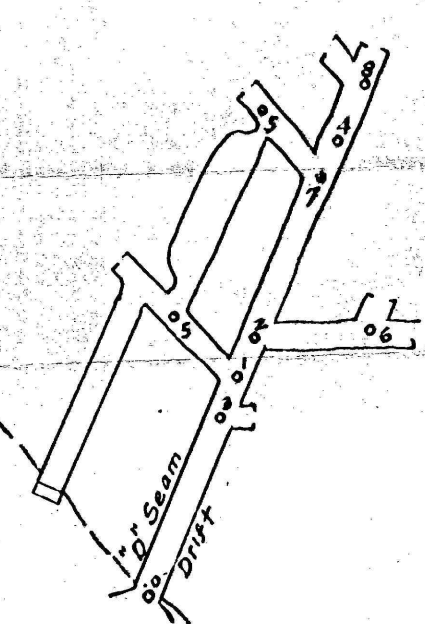

THOMAS SHROCK

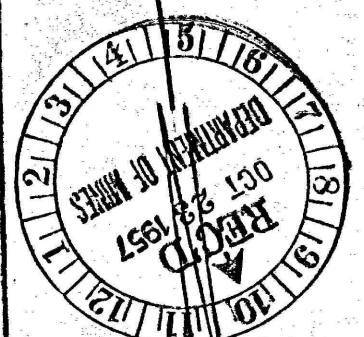

YORKSHIRE COAL CO.
MADEIRA, PA.
MAP OF MINE dist. 27
BECCARIA TWR. CLFD. CO. PA. 27
SCALE 1"=100'
CLEARFIELD, PA. ROY C. KINDIG
OCT. 15, 1957. REG. ENGR.